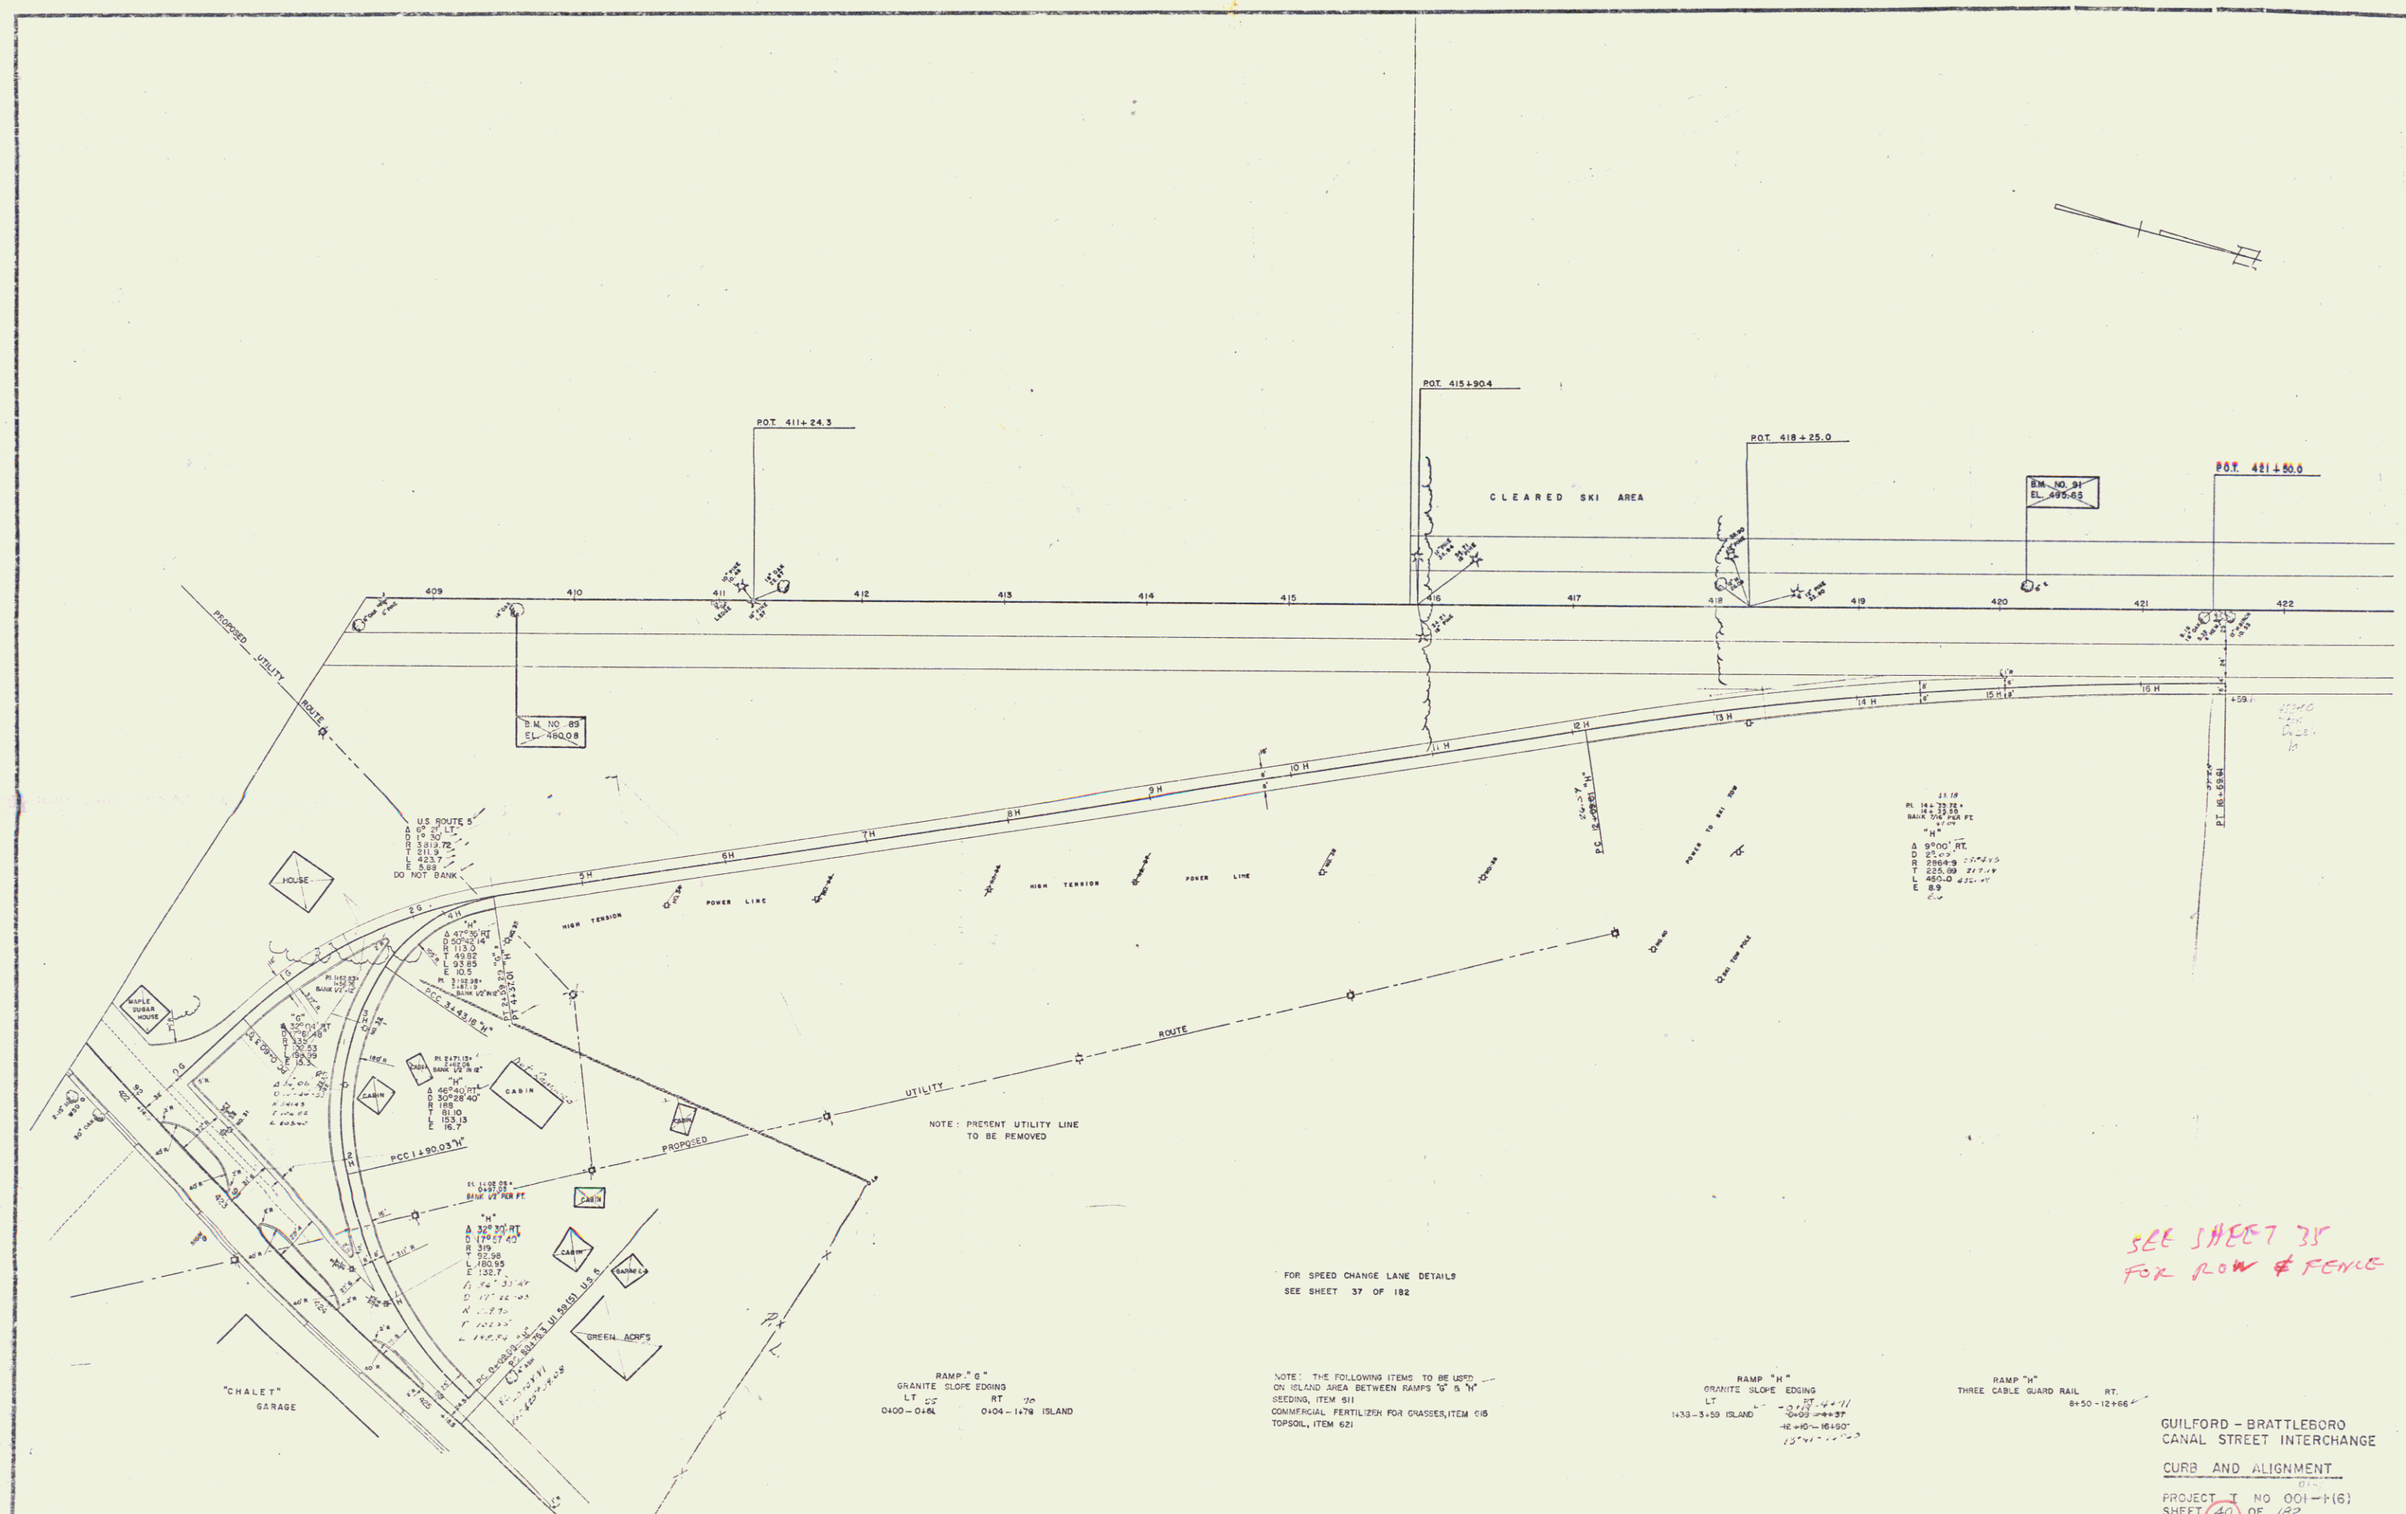
P.O.T. 411+24.3
P.O.T. 415+90.4
P.O.T. 418+25.0
P.O.T. 421+50.0
CLEARED SKI AREA
B.M. NO. 91
EL. 495.65
B.M. NO. 89
EL. 460.08
PROPOSED UTILITY ROUTE
UTILITY ROUTE
HIGH TENSION POWER LINE
U.S. ROUTE 5
DO NOT BANK
HOUSE
MAPLE SUGAR HOUSE
CABIN
PROPOSED
NOTE: PRESENT UTILITY LINE TO BE REMOVED
FOR SPEED CHANGE LANE DETAILS SEE SHEET 37 OF 182
GREEN ACRES
"CHALET" GARAGE
RAMP "G" GRANITE SLOPE EDGING
LT 25 RT 70
0400 – 0481 0404 – 1+78 ISLAND
NOTE: THE FOLLOWING ITEMS TO BE USED ON ISLAND AREA BETWEEN RAMPS "G" & "H"
SEEDING, ITEM 611
COMMERCIAL FERTILIZER FOR GRASSES, ITEM 615
TOPSOIL, ITEM 621
RAMP "H" GRANITE SLOPE EDGING
LT
1+33 – 3+59 ISLAND
RAMP "H" THREE CABLE GUARD RAIL RT.
8+50 – 12+66
SEE SHEET 38 FOR ROW & FENCE
GUILFORD – BRATTLEBORO
CANAL STREET INTERCHANGE
CURB AND ALIGNMENT
PROJECT I NO 001-1(6)
SHEET 40 OF 182