GRANITE CURB
Island Rt.
410+42 - 411+94 415+00 - 416+00
412+19 - 416+09
i.s. +30
GRANITE SLOPE EDGING
Lt.
410+54 - 411+73

ONE COURSE CEMENT
CONCRETE SIDEWALK 5'
415+9 - 416+00

THREE CABLE GUARD RAIL
WITH STEEL POSTS
~~411+96 - 415+00 Rt.~~

REMOVAL AND DISPOSAL OF PRESENT
GUARD RAIL
413+50 - 414+50 RT.

Beginning of ℄ of 16' wide Right-of-way
conveyed by QCD
Latchis 12/17/58

REVISED
Δ 20°38' Lt
D 4°
R 14327
L 5158
E 236
Bank 9/16 per ft.

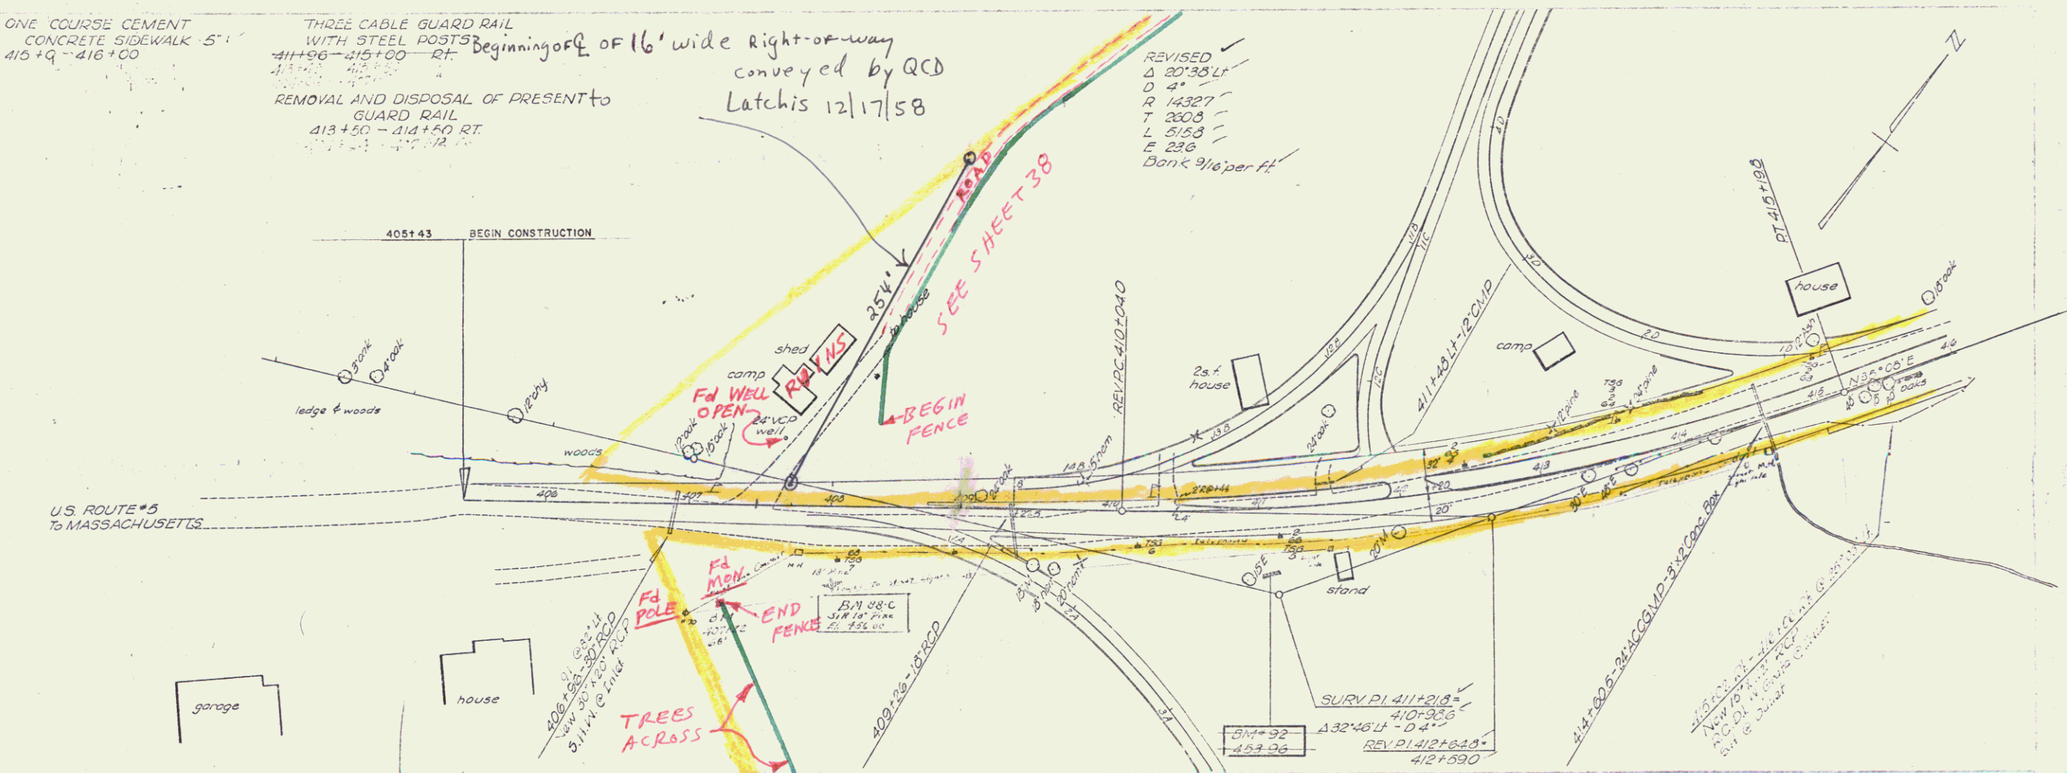

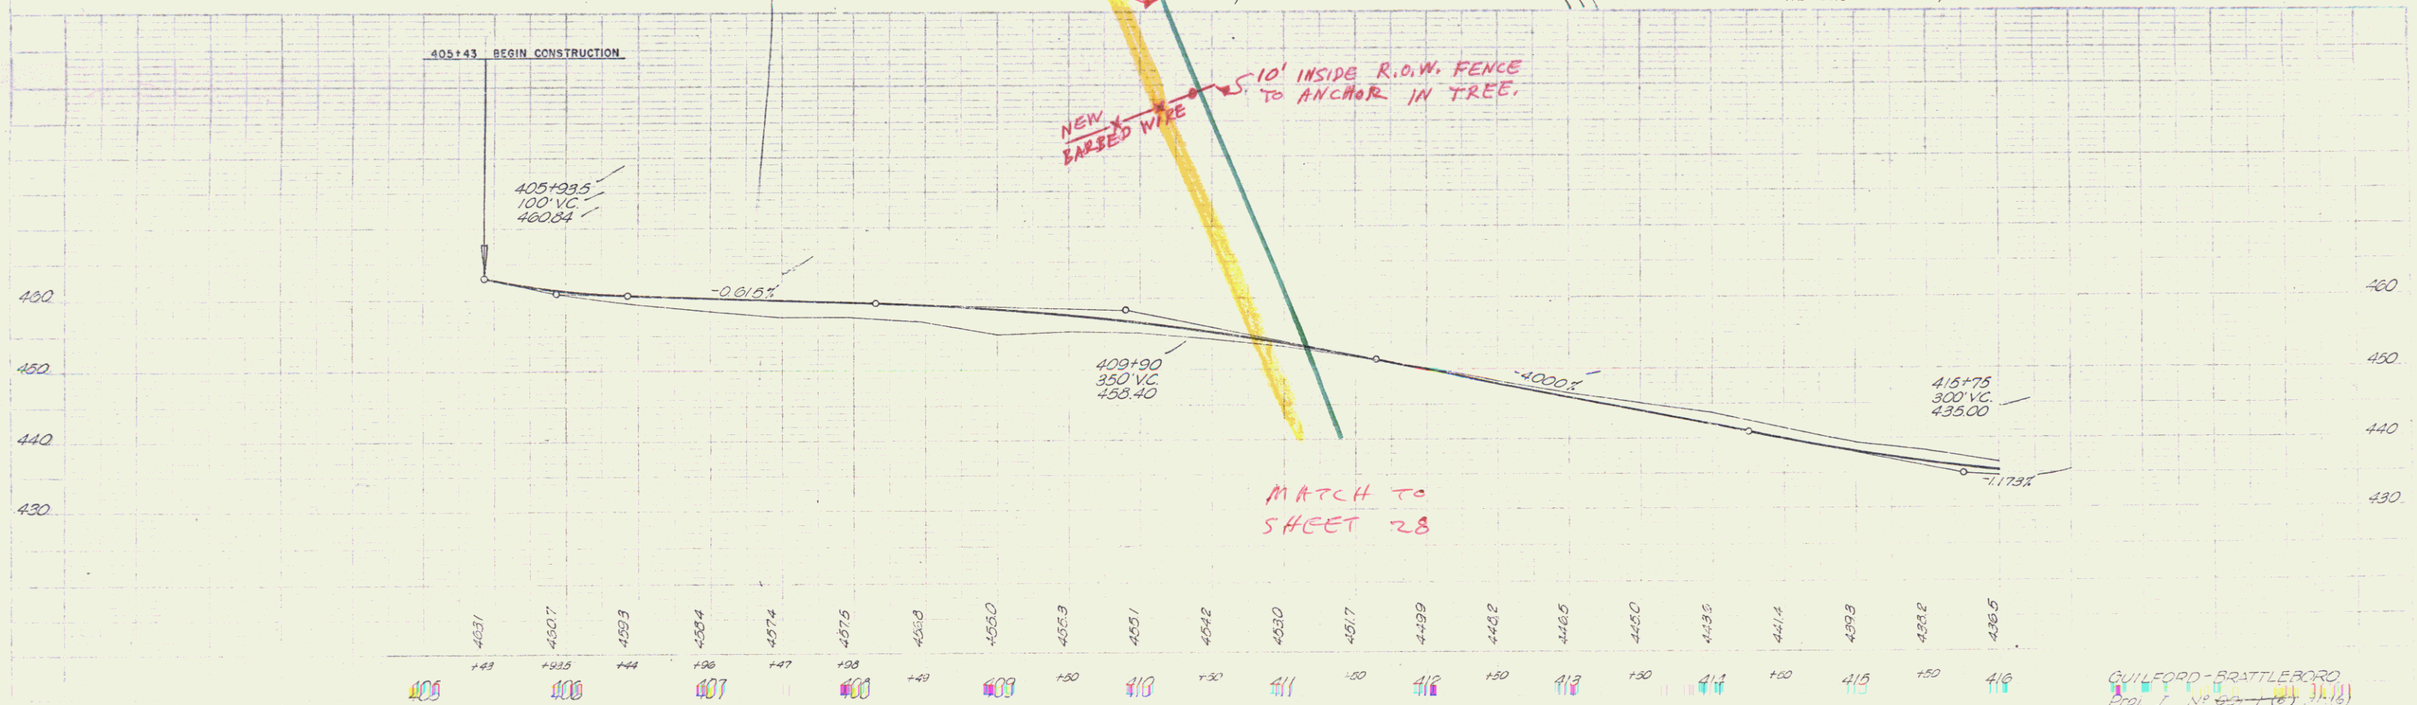

GUILFORD - BRATTLEBORO
Proj. I No. ~~[illegible]~~ (8) 31.16
U.S. #5 - Canal St. Interchange
Sheet 48 of 182