THREE CABLE GUARD RAIL WITH STEEL POSTS

LT. Lt. Median Rt.

~~422+00 425+52~~
421+76 - 425+12

PROPERTY LINE FENCE ITEM 583-B

Lt. Rt.
422 + 00 - 428+00 ~~422+00 - 428+00~~
420+00

DRILLING AND BLASTING OF SOLID ROCK SUBGRADE
ITEM 114 (Mod.)
STA. 421+~~70~~ 40 - 420+00
422+00 - 425+25

Const. U-Turn
425 + 25 Median

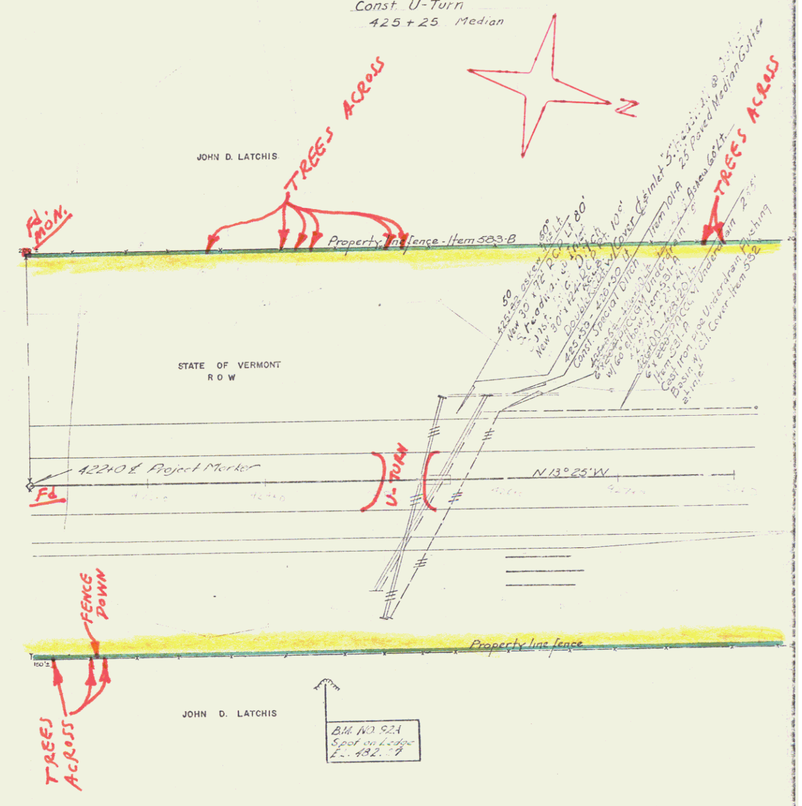

9

BEGIN PROJECT
I NO. 91-1(2)

BRATTLEBORO
I 91-1(2)
9 (2)
32 496

2