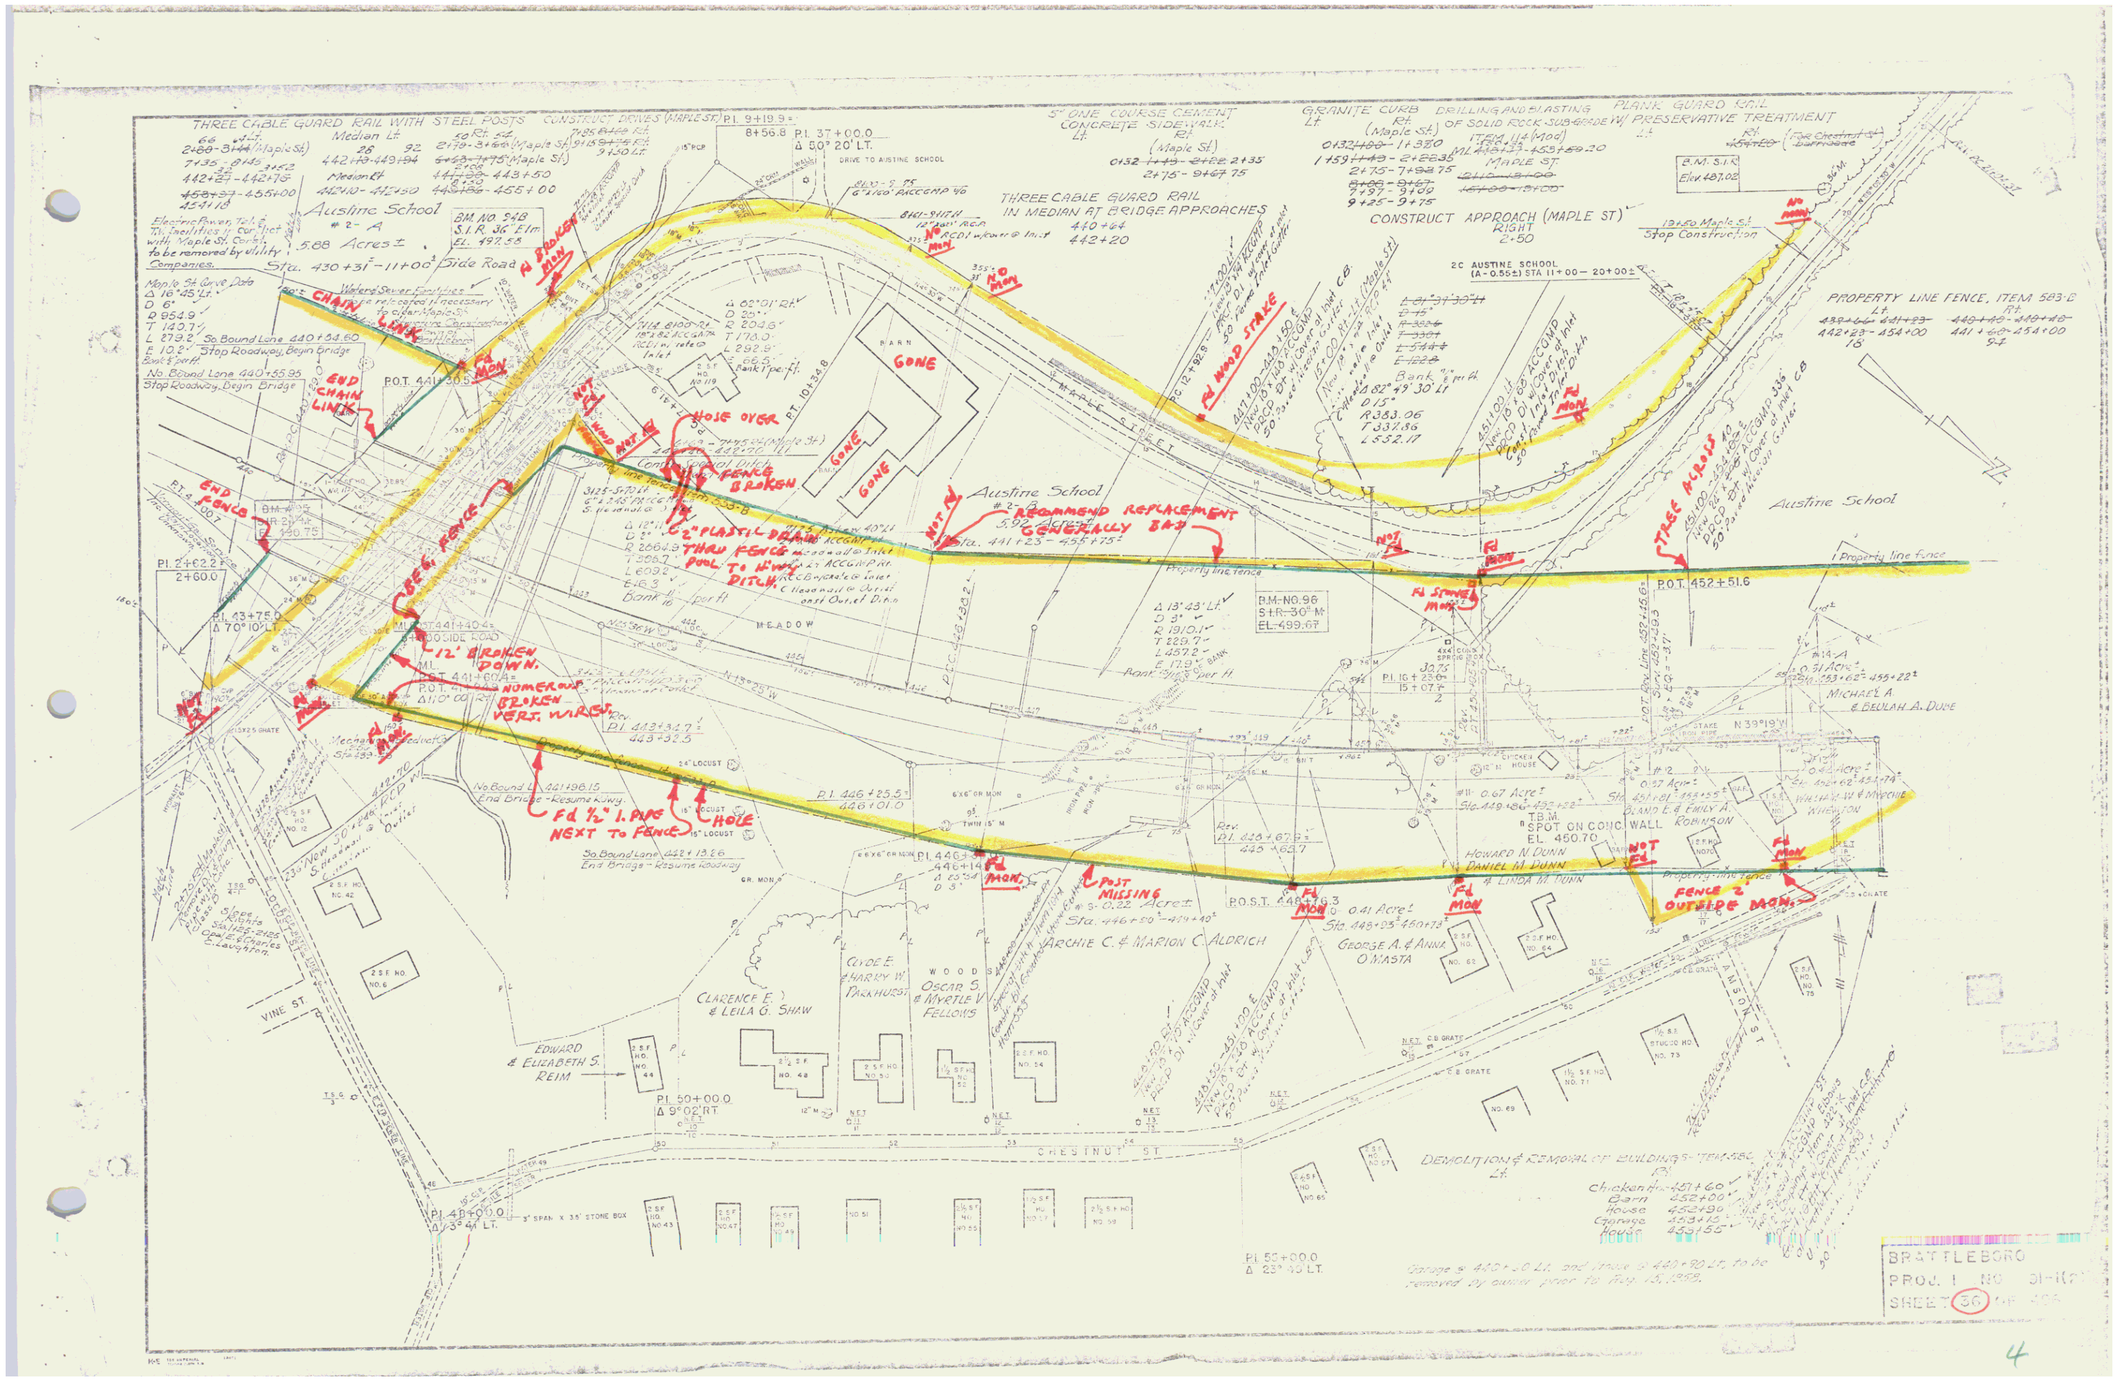
THREE CABLE GUARD RAIL WITH STEEL POSTS
CONSTRUCT DRIVES (MAPLE ST.)
5" LINE COURSE CEMENT CONCRETE SIDEWALK
GRANITE CURB
DRILLING AND BLASTING OF SOLID ROCK SUBGRADE
PLANK GUARD RAIL W/ PRESERVATIVE TREATMENT
THREE CABLE GUARD RAIL IN MEDIAN AT BRIDGE APPROACHES
CONSTRUCT APPROACH (MAPLE ST)
PROPERTY LINE FENCE, ITEM 583.6
Austine School
BM NO. 54B
S.I.R. 36" Elm
EL. 497.58
5.88 Acres ±
Sta. 430+31' - 11+00' Side Road
CHAIN LINK
END CHAIN LINK
END FENCE
HOSE OVER
FENCE BROKEN
RECOMMEND REPLACEMENT
GENERALLY BAD
12" PLASTIC DRAIN
THRU FENCE TO H'WAY DITCH
BEG. FENCE
12" BROKEN DOWN.
NUMEROUS BROKEN VERT. WIRES
Fd 1/2" I. PIPE NEXT TO FENCE
HOLE
POST MISSING
FENCE 2' OUTSIDE MON.
TILE ALREADY
Fd WOOD STAKE
Fd STONE MON.
BARN
GONE
MEADOW
Austine School
Property line fence
P.O.T. 452+51.6
B.M. NO. 96
S.I.R. 30" M
EL. 499.67
MICHAEL A. & BEULAH A. DUDE
HOWARD N. DUNN
DANIEL H. DUNN & LINDA M. DUNN
ARCHIE C. & MARION C. ALDRICH
GEORGE A. & ANNA O. MASTA
CLYDE E. & HARRY W. PARKHURST
OSCAR S. & MYRTLE V. FELLOWS
CLARENCE E. & LEILA G. SHAW
EDWARD & ELIZABETH S. REIM
VINE ST.
CHESTNUT ST.
DEMOLITION & REMOVAL OF BUILDINGS, ITEM 206.1
Garage & 440+-0 Lt. and House @ 440+90 Lt. to be removed by owner prior to Aug. 15, 1968.
BRATTLEBORO
PROJ. I NO
SHEET 36

4