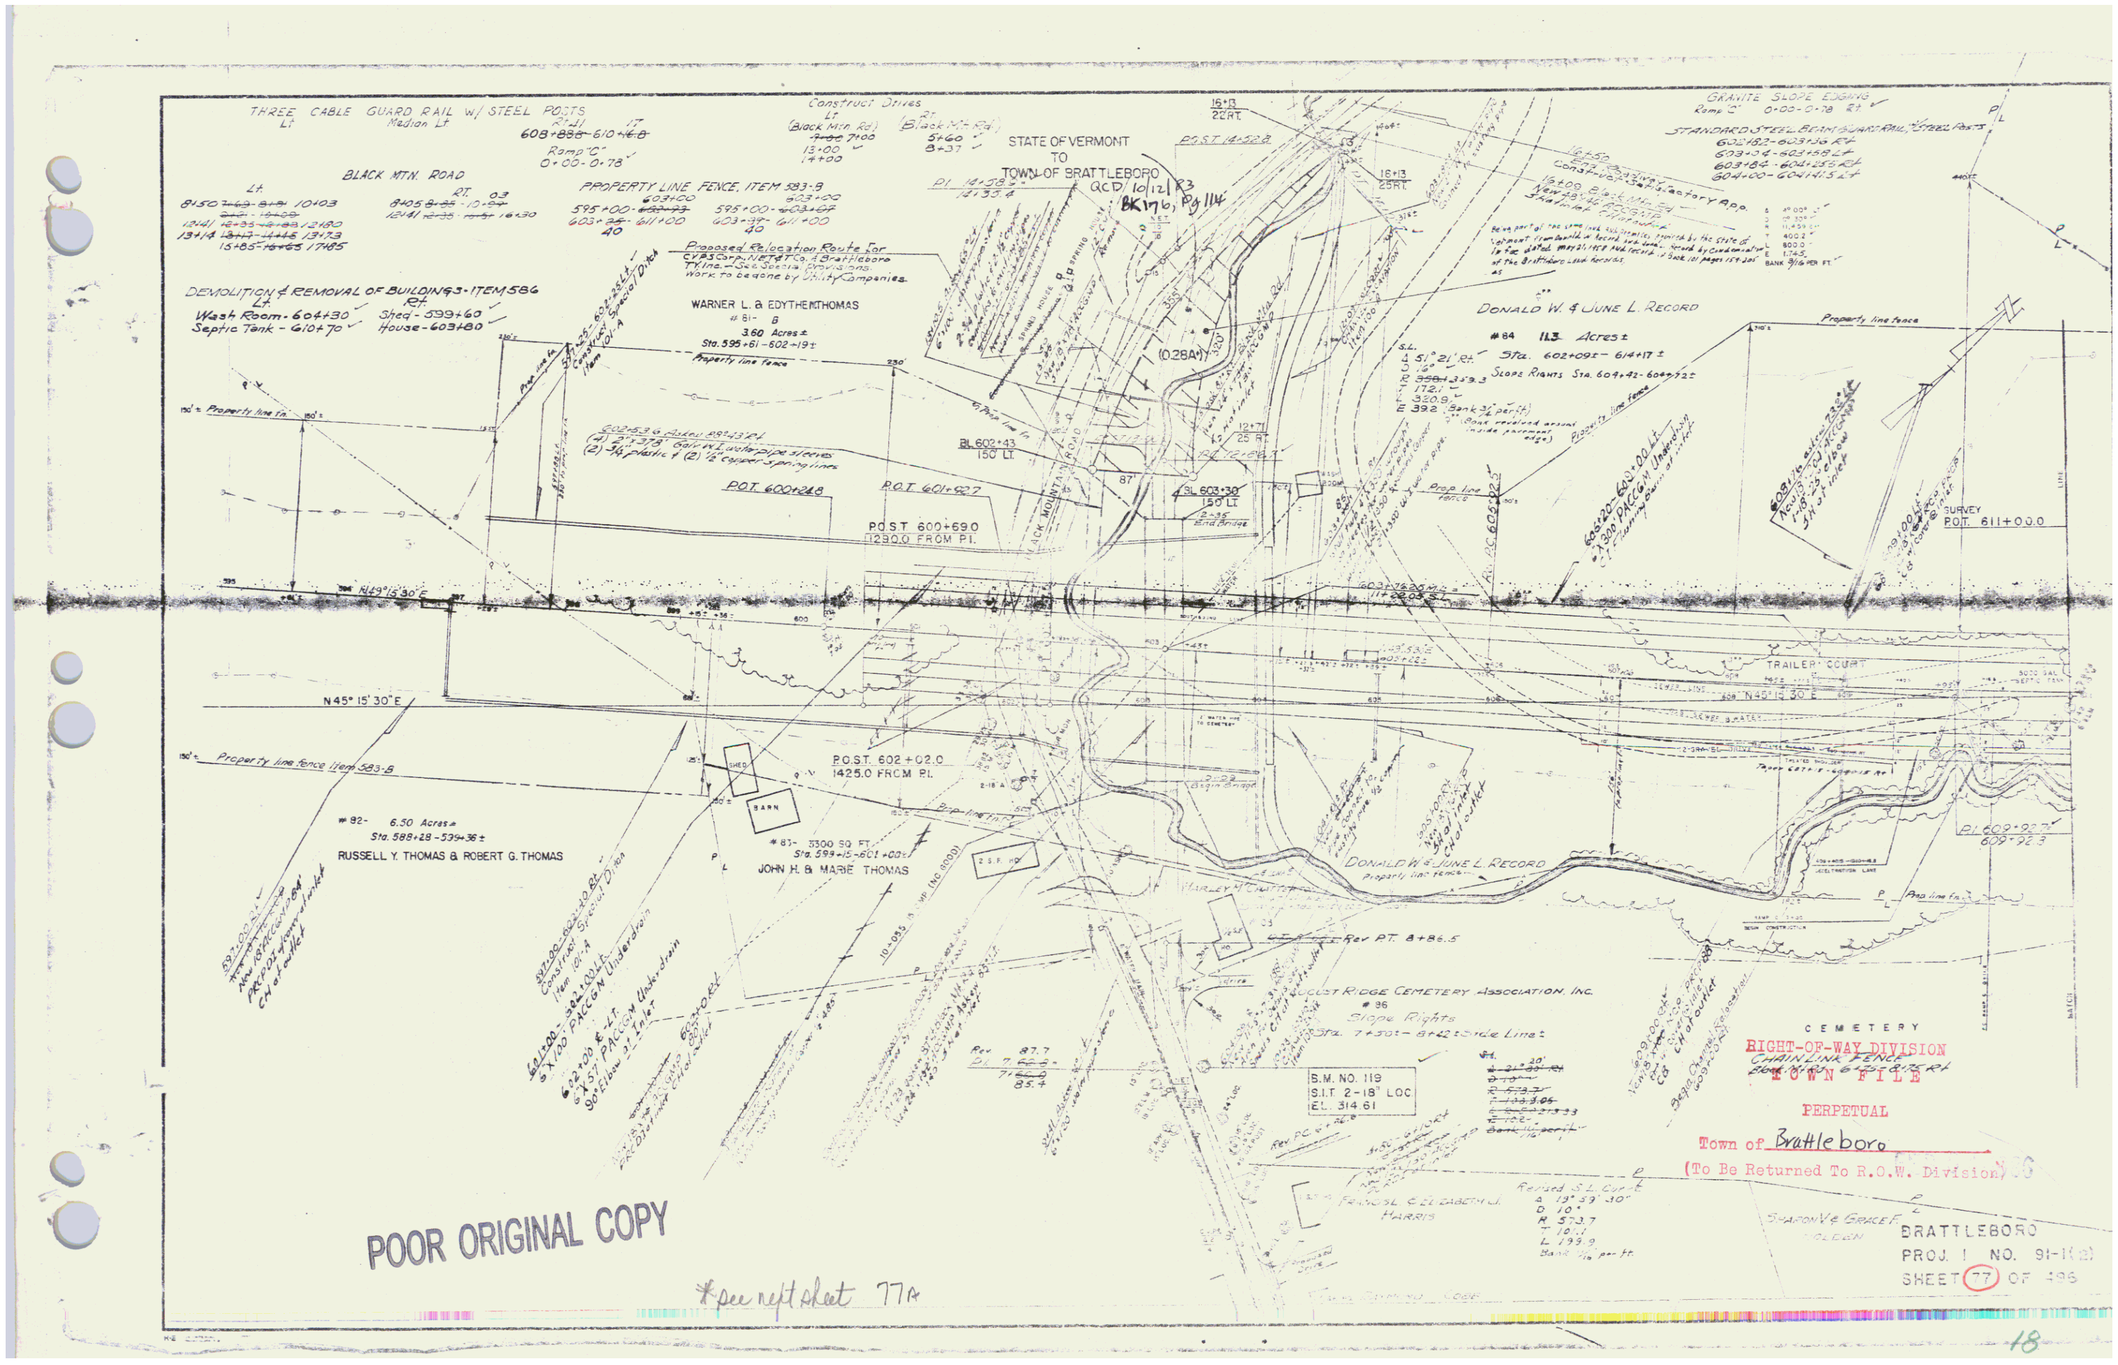
THREE CABLE GUARD RAIL w/ STEEL POSTS
BLACK MTN. ROAD
PROPERTY LINE FENCE, ITEM 583-B
STATE OF VERMONT
TO
TOWN OF BRATTLEBORO
DEMOLITION & REMOVAL OF BUILDINGS - ITEM 586
WARNER L. & EDYTHE M. THOMAS
DONALD W. & JUNE L. RECORD
GRANITE SLOPE EDGING
STANDARD STEEL BEAM GUARD RAIL, STEEL POSTS
POST 600+690
1290.0 FROM PI.
N45° 15' 30" E
TRAILER COURT
POST 602+02.0
1425.0 FROM PI.
RUSSELL Y. THOMAS & ROBERT G. THOMAS
JOHN H. & MARIE THOMAS
DONALD W. & JUNE L. RECORD
CEMETERY
RIGHT-OF-WAY DIVISION
TOWN FILE
PERPETUAL
Town of Brattleboro
(To Be Returned To R.O.W. Division)
BRATTLEBORO
PROJ. I NO. 91-K(2)
SHEET 77 OF 496
POOR ORIGINAL COPY
*see next sheet 77A

18