Note: For Summary Of Landscape Material
Contract No1, See Sheet No. 26

#35 GRACE M. CURRIER
(A 6.4±) STA 1017+88-1029+75±
CULVERT & DITCHING RIGHTS STA. 1019 + 50 LT.
STA 1026+00 LT.
COND: 7/3/59
REC.: PUTNEY BK. 35 — PG. 222 — 7/10/59

~~Three Cable Guard Rail with Steel Posts~~
~~1026 + 50 to 1027 + 50 LT.~~

Paved Median Gutter
1027 + 50 to 1022 + 75
1026 + 00 to 1026 + 25
1035 + 75 to 1036 + 00

Property Line Fence with Steel Posts
Item No. 583-8
1022 + 00 to 1038 + 00 Lt.
1022 + 00 to 1038 + 00 Rt.

Construct Special Ditch
Item 101-C
1026+00 Lt.

#36 REUBIN & ELSIE BLOOD
(A 13.9±) STA 1028+76-1054+22±
COND 7/3/59
REC.: SEE #35

Construct Drive
1036 + 40 Rt.

PROJECT ID NO.	STATE	FED. AID PROJ. SECT. NO.	FISCAL YEAR	SHEET NO.	TOTAL SHEETS
I	VT.	I 91-1(10)	FISCAL YEAR 25		328

NOTE 1029 + 75-1043 + 00 LT.
ERECT PROPERTY LINE FENCE W/STEEL POSTS, MODIFIED AND PROPERTY LINE FENCE WITH STEEL POSTS, MODIFIED, (SWINE FENCE) PRIOR TO CONSTRUCTION.
FOR DETAILS OF SWINE FENCE, SEE SHEET NO. 26 AND ROADWAY STANDARD F-1.

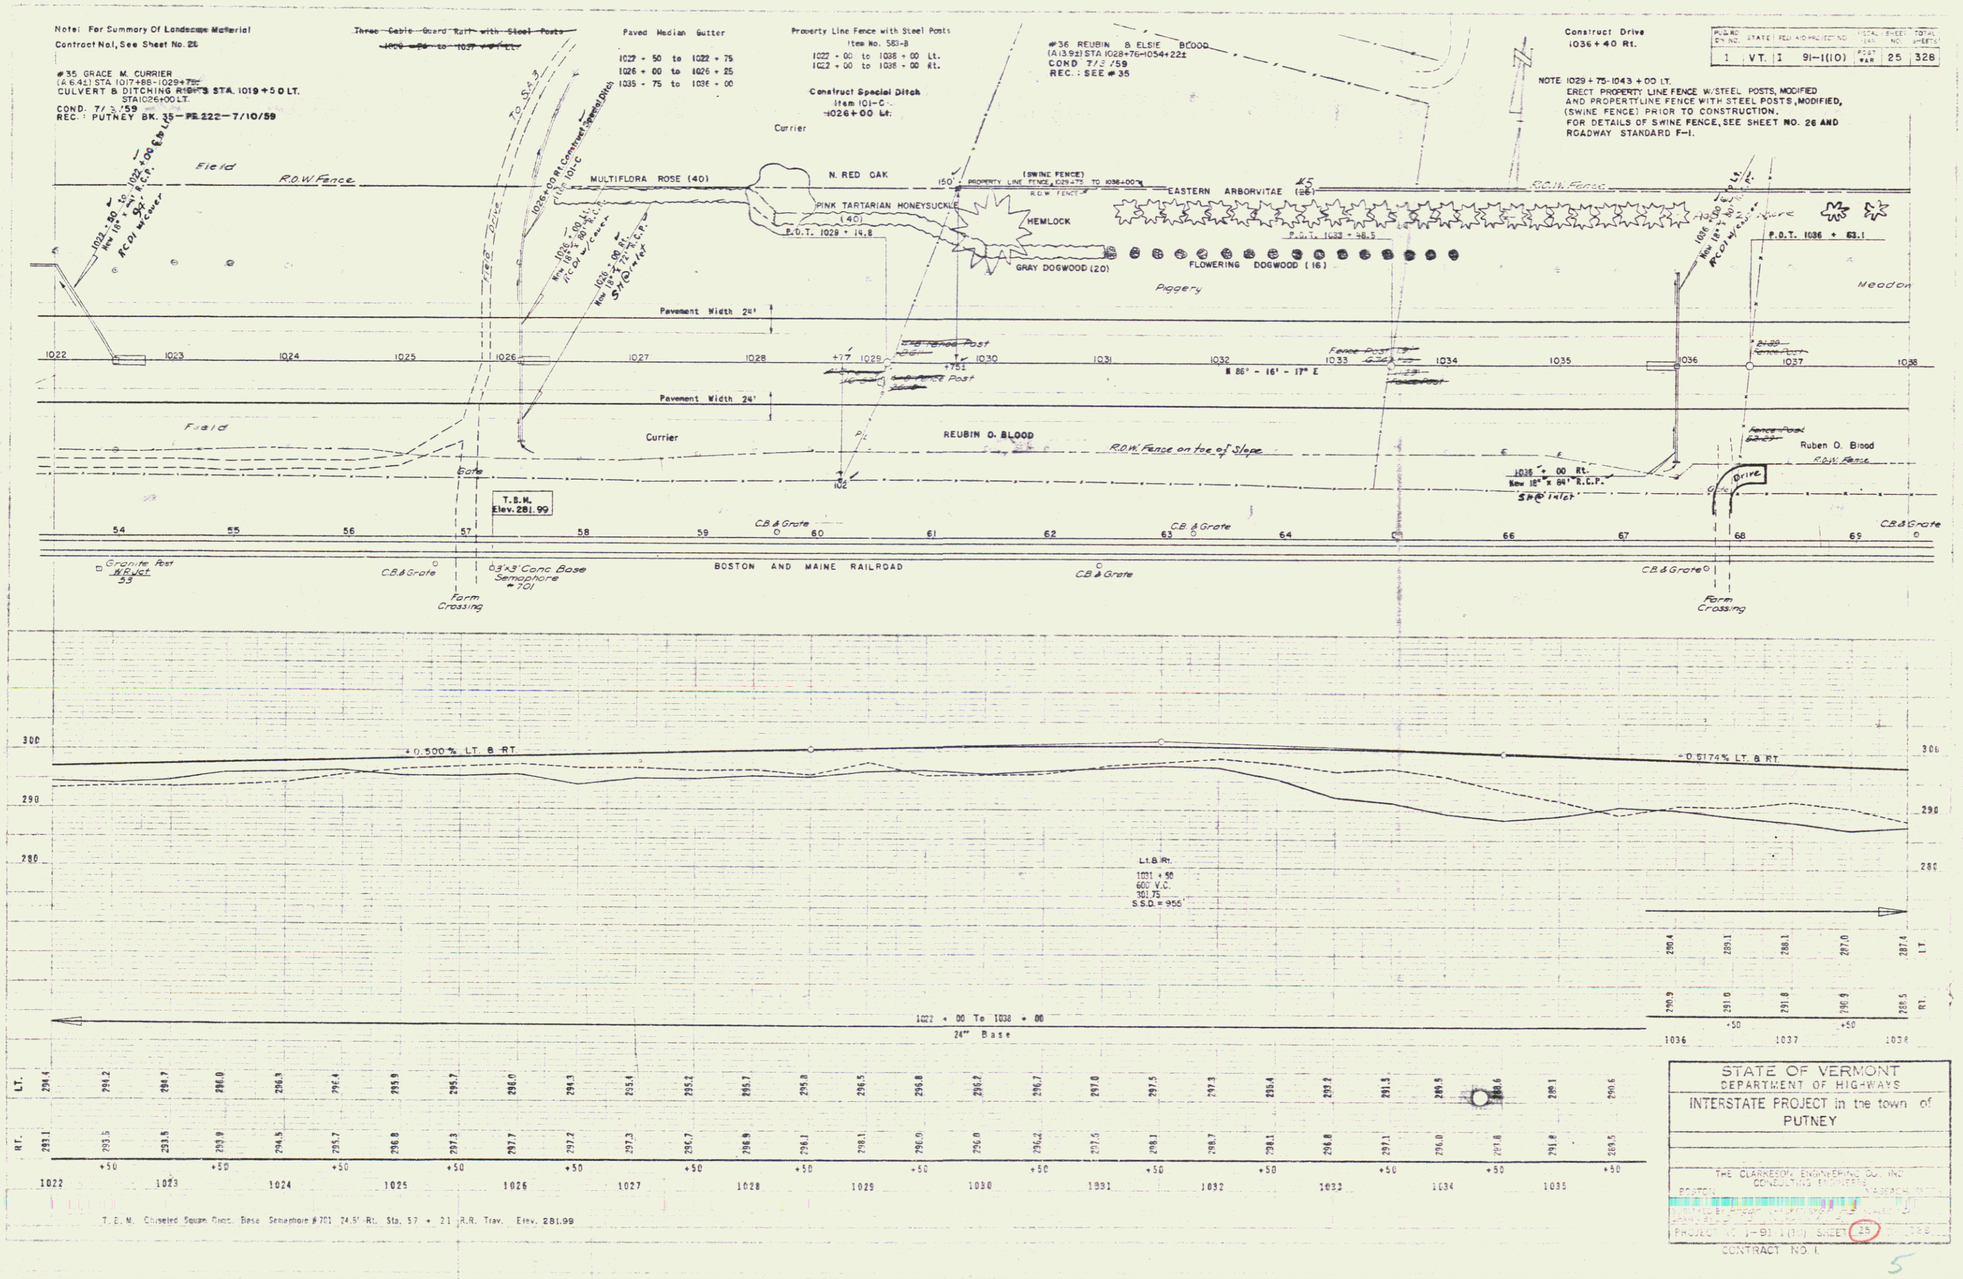

T.B.M. Chiseled Square Conc. Base Semaphore #701 24.5' Rt. Sta. 57 + 21 R.R. Trav. Elev. 281.99

STATE OF VERMONT
DEPARTMENT OF HIGHWAYS
INTERSTATE PROJECT in the town of PUTNEY

THE CLARKESON ENGINEERING CO., INC.
CONSULTING ENGINEERS
BOSTON

PROJECT NO. I-91 (10) SHEET 25

CONTRACT NO. 1

5