PUB NO. DIV. NO.	STATE	FED. AID PROJECT NO.	FISCAL YEAR	SHEET NO.	TOTAL SHEETS
1	VT.	I-91-1(10)	POST WAR	26	328

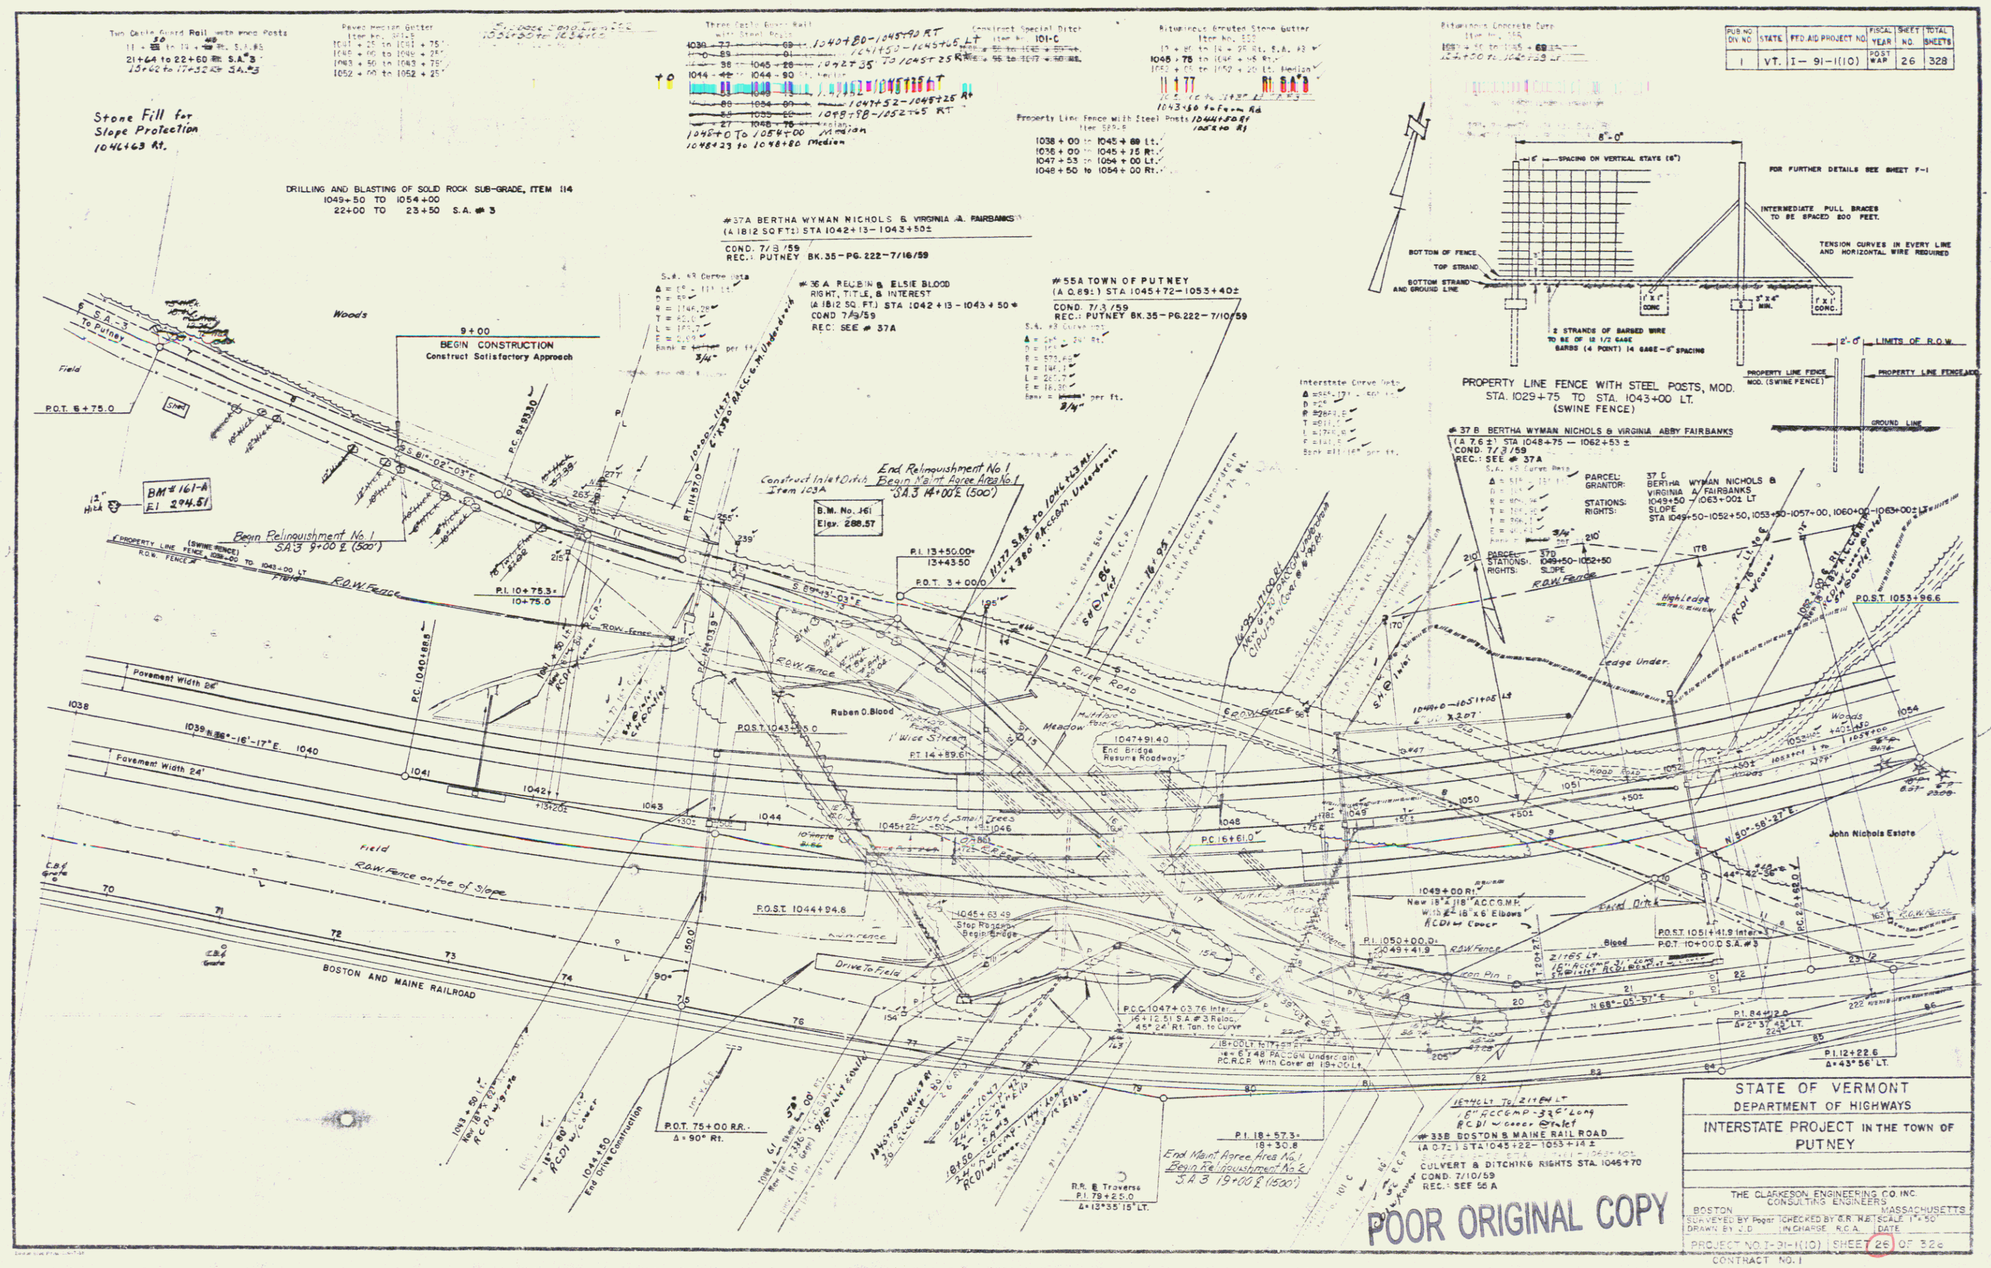

POOR ORIGINAL COPY