Note: For Summary Of Landscape Material, Contract No.2, See Sheet No. 37.

Drilling and Blasting of Solid Rock Subgrade
Item No. 114
1085 + 00 to 1089 + 00 40
1089 + 00 to 1100 + 00

Three Cable Guard Rail With Steel Posts
1085 + 00 to 1090 + 75 Lt. Median
1085 + 00 to 1093 + 50 Rt.

Paved Median Gutter
1089 + 75 to 1090 + 00
1093 + 92 to 1093 + 67
~~1096 + 75 to 1097 + 00~~
1099 + 75 to 1100 + 00

~~Bituminous Grouted Stone Gutter~~
~~Item 595~~
~~1090+00 Rt.~~
~~1096 + 25 to 1097+00 Rt.~~

Property Line Fence With Steel Posts
Item No. 613 B
1085 + 00 to 1101 + 00 Lt.
1085 + 00 to 1101 + 00 Rt.

Granite Slope Edging
Item 556-A
1085+00 to 1089+80

PUBLIC DIV. NO.	STATE	FED. AID PROJECT NO.	FISCAL YEAR	SHEET NO.	TOTAL SHEETS
1	VT.	I 91-1(110)	POST WAR	32	328

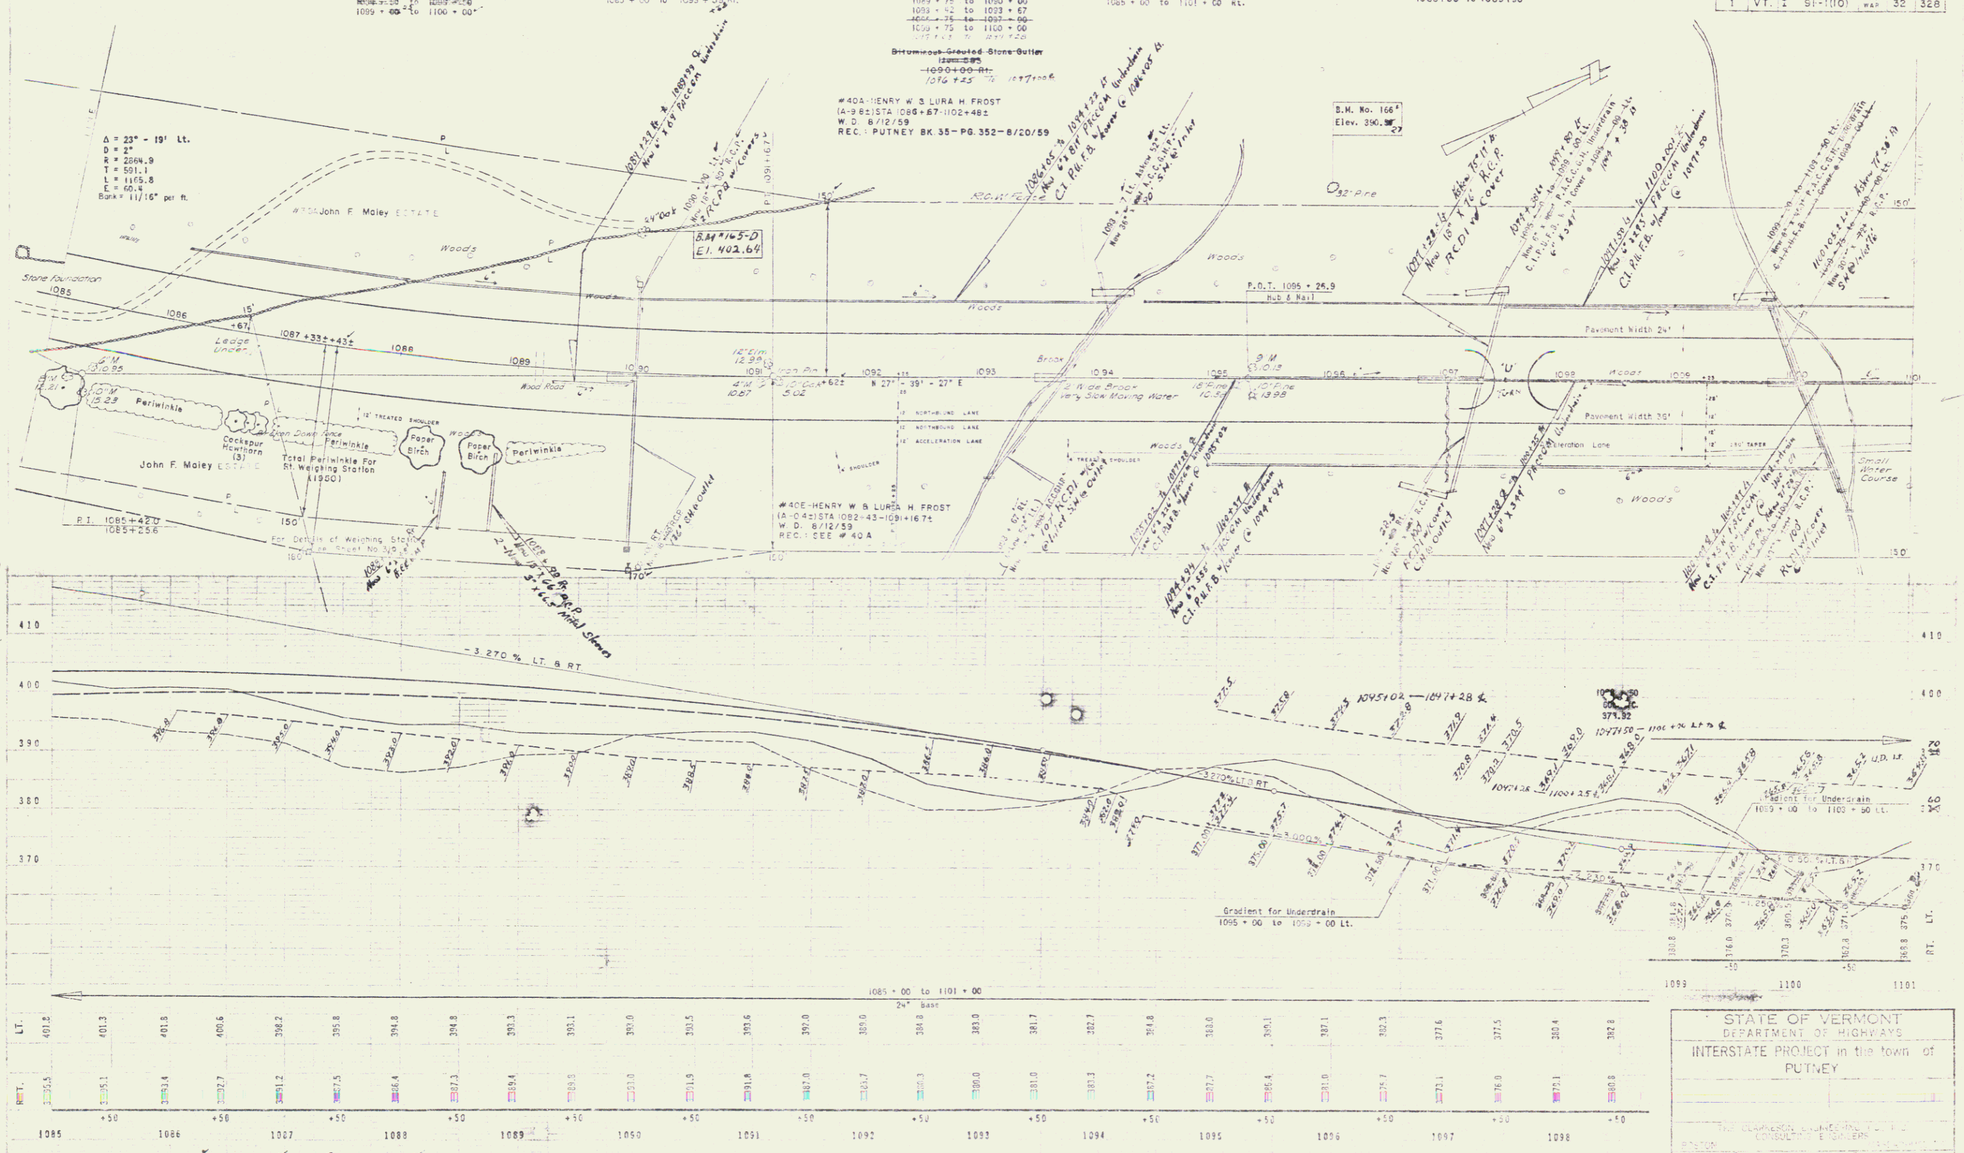

B.M. No. 166 R.R.S.I.R. 32" Pine 160' Lt. Sta. 1096 + 00 Elev. 390.27

B.M. No 165-D S.I.R. 24" Oak 120' Lt. Sta. 1090+00 Elev. 402.64

9