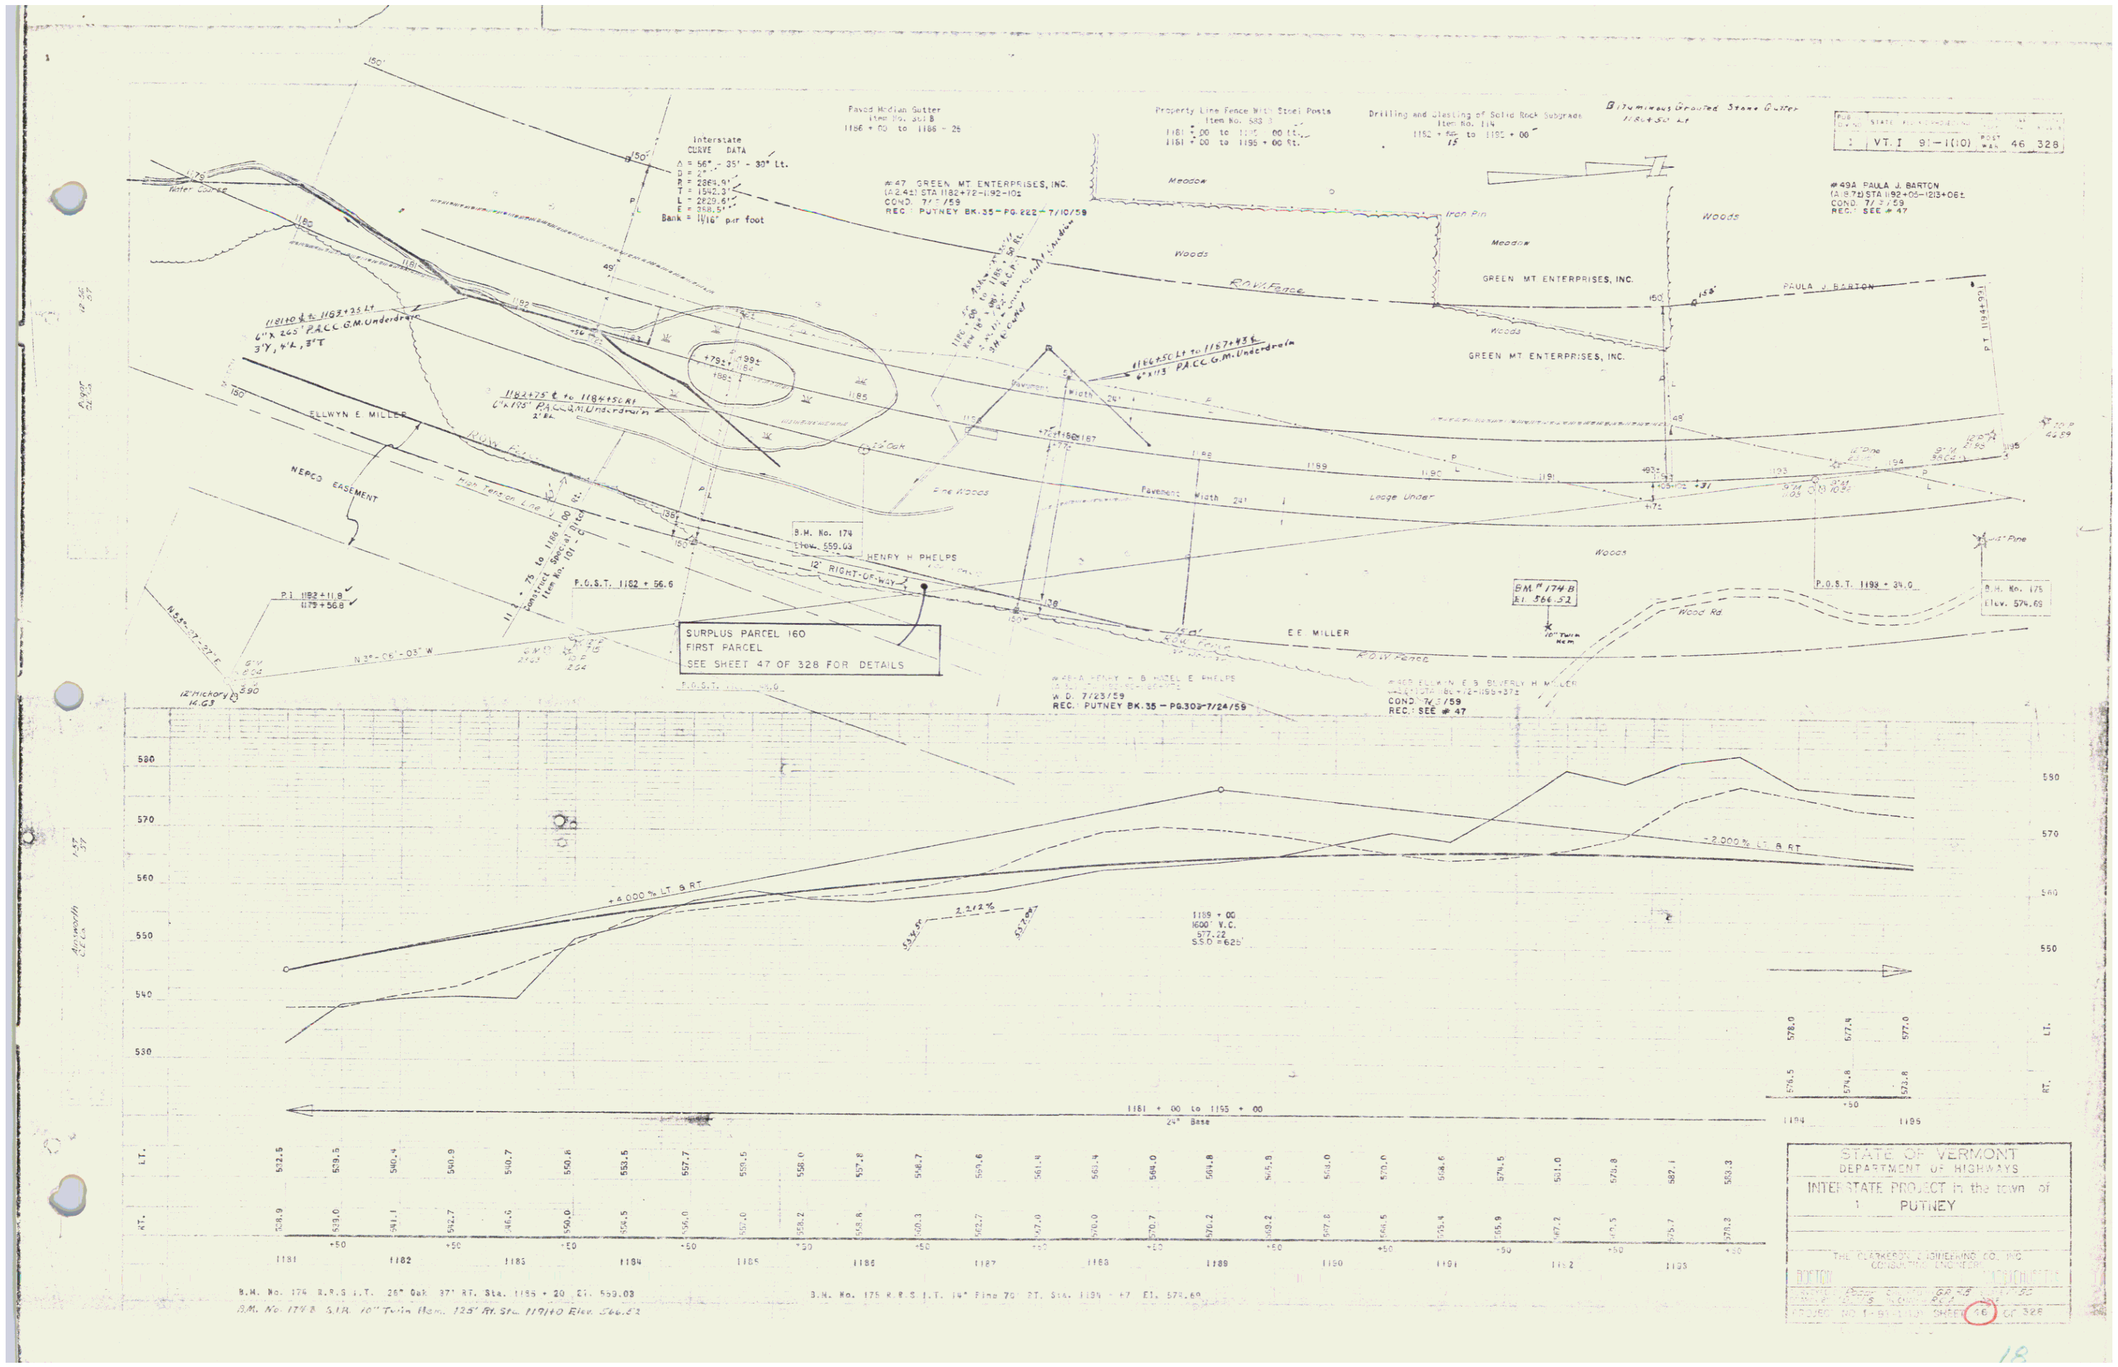
Interstate
CURVE DATA
Δ = 56° - 35' - 30" Lt.
D = 2°
R = 2864.5'
T = 1542.3'
L = 2829.61'
E = 368.5'
Bank = 1 1/16" per foot
#47 GREEN MT. ENTERPRISES, INC.
COND. 7/7/59
REC.: PUTNEY BK. 35 - PG. 222 - 7/10/59
#49A PAULA J. BARTON
COND. 7/7/59
REC.: SEE #47
GREEN MT. ENTERPRISES, INC.
PAULA J. BARTON
ELLWYN E. MILLER
NEPCO EASEMENT
HENRY H. PHELPS
12' RIGHT-OF-WAY
B.M. No. 174
Elev. 559.03
SURPLUS PARCEL 160
FIRST PARCEL
SEE SHEET 47 OF 328 FOR DETAILS
E.E. MILLER
B.M. No. 175
Elev. 574.69
+4.000% LT & RT
-2.000% LT & RT
2.212%
1189 + 00
1600' V.C.
577.22
550.462b'
1181 + 00 to 1195 + 00
24" Base
STATE OF VERMONT
DEPARTMENT OF HIGHWAYS
INTERSTATE PROJECT in the town of
PUTNEY
CONSULTING ENGINEERS
BOSTON
SHEET 46 OF 328