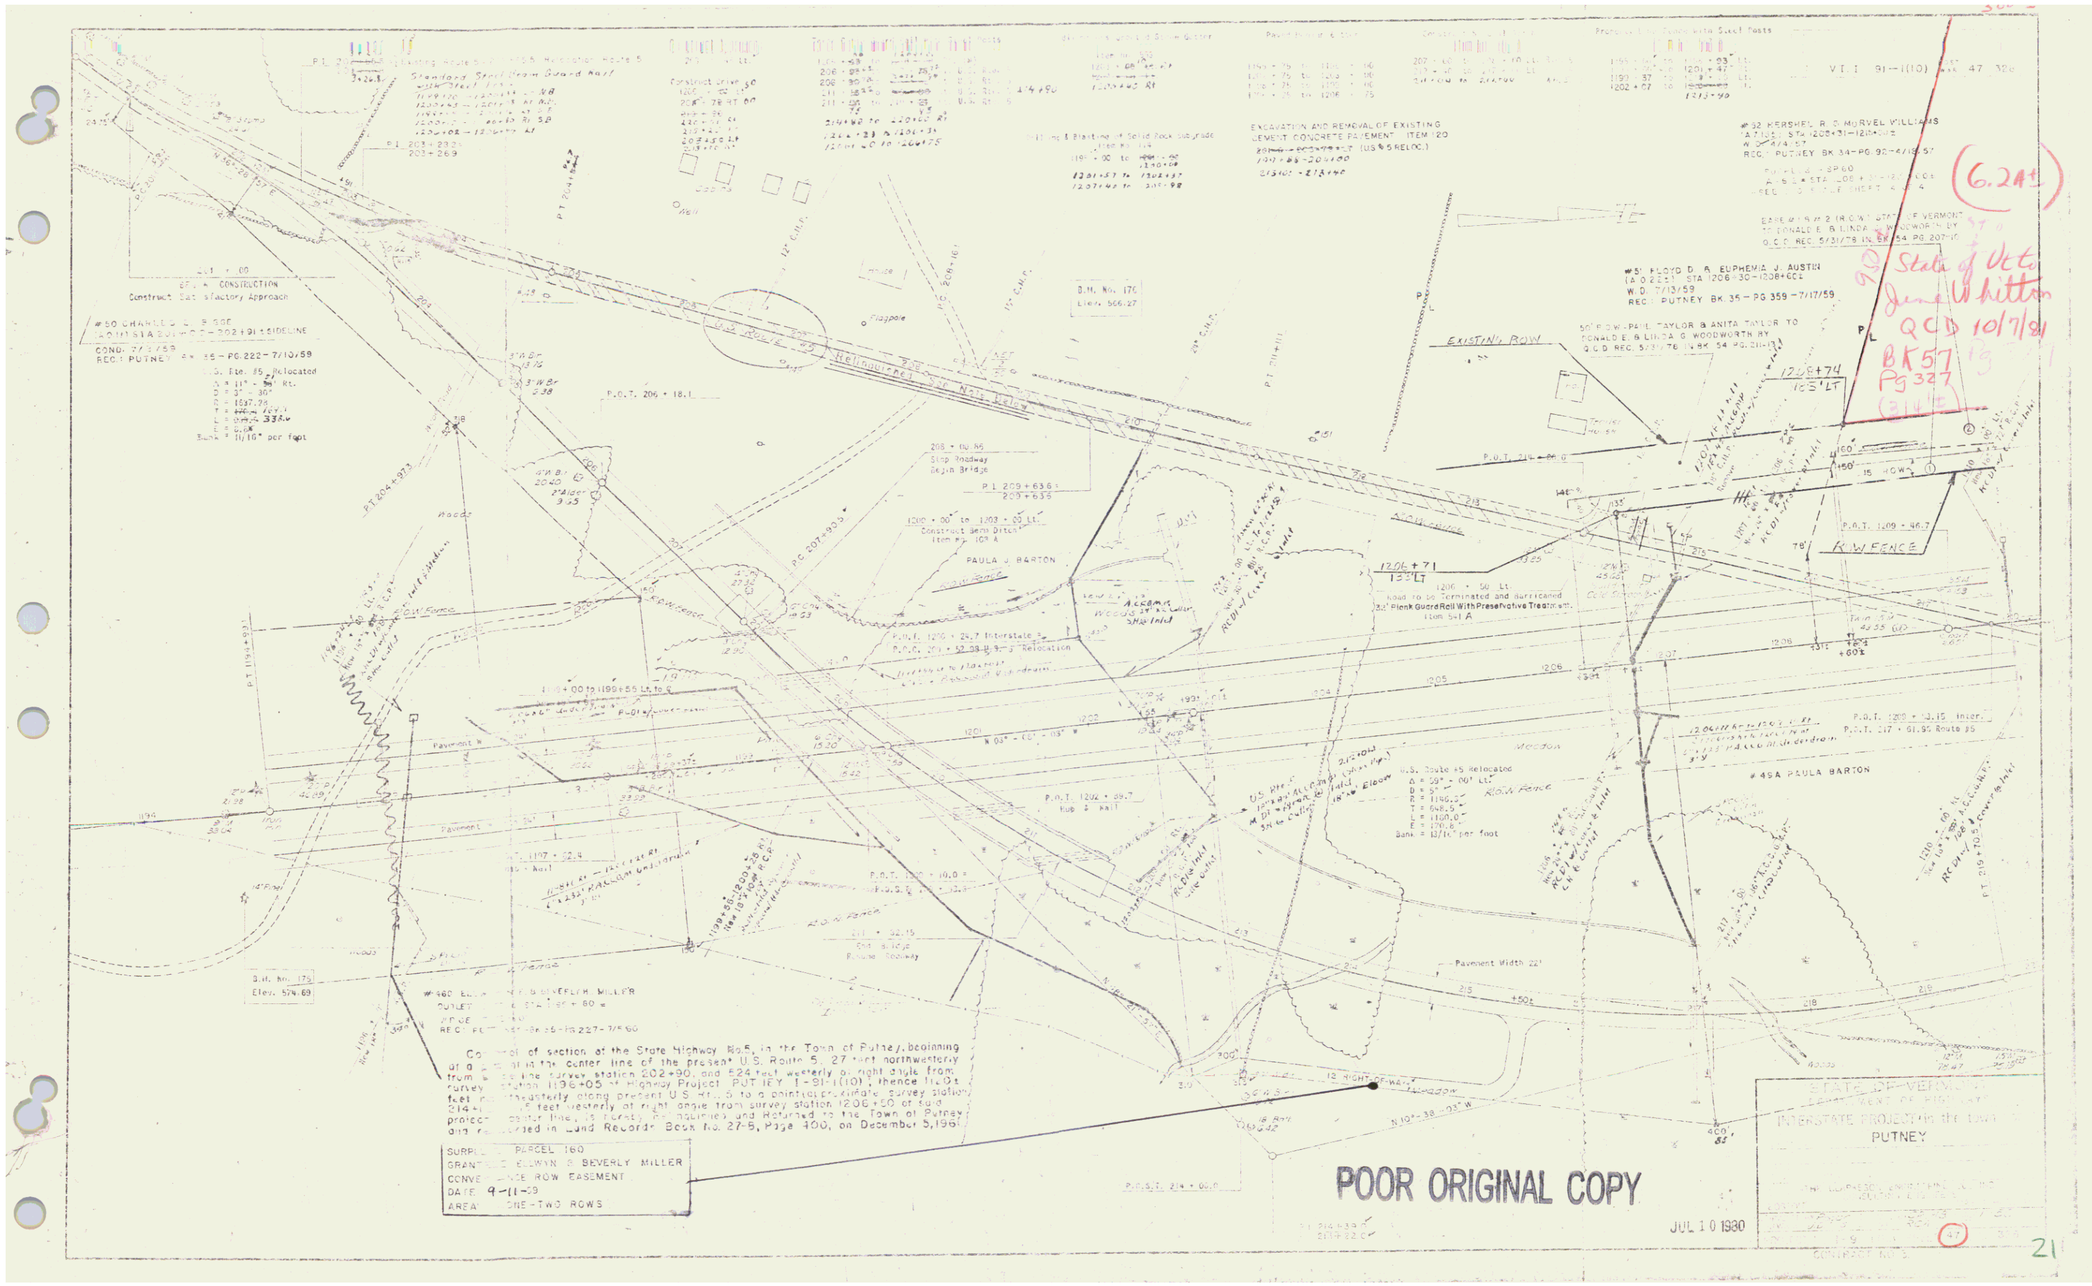
(6.24±)
State of Vt.
Jane W. Litton
QCD 10/7/81
BK57
Pg 327
(3.14±)
EXISTING ROW
ROW FENCE
PAULA J. BARTON
#49A PAULA BARTON
Pavement Width 22'
Construct Sat. Sfactory Approach
Construct Drive
Construct Semi Ditch
Item No. 103 A
Road to be Terminated and Barricaded
Plank Guard Rail With Preservative Treatment
Item 541 A
Excavation and Removal of Existing Cement Concrete Pavement Item 120
Stop Roadway
Begin Bridge
Section of section at the State Highway No.5, in the Town of Putney, beginning at a point in the center line of the present U.S. Route 5, 27 feet northwesterly from the line survey station 202+90, and 524 feet westerly at right angle from survey station 1196+05 of Highway Project PUT IEY 1-91-1(10) thence N.09° feet northeasterly along present U.S. Rt. 5 to a point in approximate survey station 214+ feet westerly at right angle from survey station 1206+50 of said project center line, as hereby relocated and returned to the Town of Putney and recorded in Land Records Book No. 27-5, Page 400, on December 5, 1961.
SURPLUS PARCEL 160
GRANTOR EDWYN & BEVERLY MILLER
CONVEYANCE ROW EASEMENT
DATE 9-11-39
AREA ONE-TWO ROWS
POOR ORIGINAL COPY
JUL 10 1980
STATE OF VERMONT
DEPARTMENT OF HIGHWAYS
INTERSTATE PROJECT in the town
PUTNEY
21