STATE OF VERMONT
DEPARTMENT OF HIGHWAYS

PROPOSED IMPROVEMENT

INTERSTATE PROJECT

RIGHT-OF-WAY and Construction Plans

TOWN OF PUTNEY

COUNTY OF WINDHAM

Interstate Route I-91

Pin # 91R040

BRATTLEBORO - BELLOWS FALLS ROAD

BEGINNING AT A POINT [illegible] MILES NORTH OF THE DUMMERSTON-PUTNEY TOWN LINE AND EXTENDING NORTHERLY [illegible] MILES

LENGTH OF ROADWAY	[illegible]	FEET = 1.638 MILES	CONTRACT NO. 2
LENGTH OF BRIDGES	[illegible]	FEET = 0.067 MILE	
LENGTH OF PROJECT	[illegible]	FEET = 1.705 MILES	

DESIGN DESIGNATION

ADT (1958)	2015
ADT (1975)	5080
DHV (1975)	730
D	55%
T =	5%
V =	70 M.P.H.

BEGIN PROJECT I91-1(10)
BEGIN CONTRACT NO. 1
980+00

END PROJECT I91-1(10)
END CONTRACT NO. 3
1211+00

1160+00
END CONTRACT NO. 2 PROJECT I-91-1(10)
BEGIN CONTRACT NO. 3 PROJECT I-91-1(10)

970+00
END CONTRACT NO. 1 PROJECT I-91-1(10)
BEGIN CONTRACT NO. 2 PROJECT I-91-1(10)

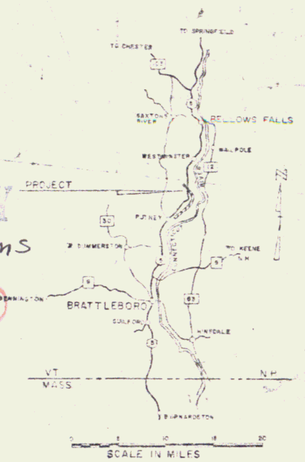

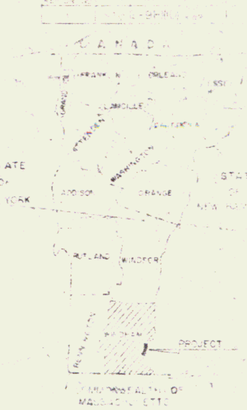

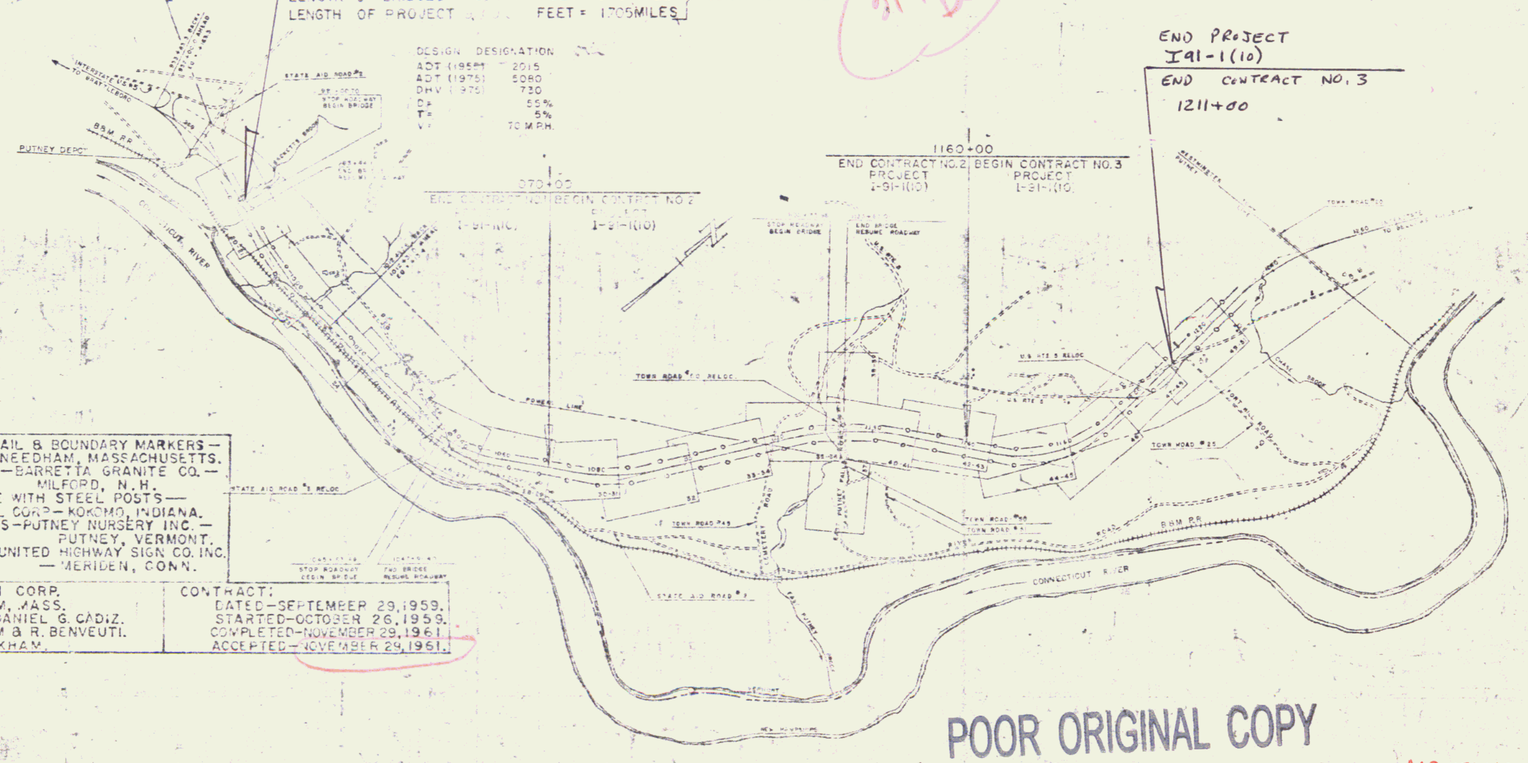

INDEX OF SHEETS
CONTRACT NO. 2

1	TITLE PAGE
1-A	ALIGNMENT DATA SHEET
2	TYPICAL SECTIONS OF IMPROVEMENT-INTERSTATE-BITUMINOUS CONCRETE PAVEMENT, ITEM 361-B, MODIFIED
5	TYPICAL SECTIONS, TOWN ROAD NO. 50
6	QUANTITY SHEET, ITEMS
8	QUANTITY SHEET, DRAINAGE
11-12	GRADE SHEETS
14-15	EARTHWORK SHEETS
18	GRADE AND EARTHWORK SHEET, TOWN ROAD NO. 50
19	EARTHWORK SUMMARY
30-43	PLAN AND PROFILE
52-52B	STANDARD SHEET SCH-30-56 (1&2) AND SB-20-56
53	STANDARD SHEET SB-22-58
54-54A	STANDARD SHEET SB-56-57 (1&2)
55	STANDARD SHEET SB-AS SQUARE-50
58	A-0 DRILLING AND BLASTING OF SOLID ROCK SUBGRADE
58A	B-1 BANKING TABLES
58B	B-5 TYPICAL SLOPE GRADING
58C	B-6 MUCK EXCAVATION
58L	B-17 DETAIL OF GUARD RAIL IN MEDIAN AT CULVERTS; DETAILS OF U-TURNS
58E	C-1 CURBS
58F	D- PRECAST R.C.P. DROP INLETS
58G	D-2 CEMENT RUBBLE MASONRY AND UNDERDRAIN
58H	D-3 GUTTERS
58I	D-4 FLUSHING BASINS AND SPECIAL A.C.C.G.M.P. ELBOWS
59	D-5 R.C. DROP INLETS
60	D-10 TOPS WITH BITUMINOUS CONCRETE CURB
61	D-11 DETAIL OF GRATES
62	D-12 CONCRETE CATCH BASIN OR MANHOLE
63	E-1 BARRICADES, SIGNS AND LIGHTS (ROADWAYS)
64	E-3 TRAFFIC SIGNS, REGULATORY SIGNS
65	E-4 TRAFFIC SIGNS, ROUTE MARKERS AND AUXILIARY MARKERS
66	E-5 TRAFFIC SIGNS, SIGN BOLT FOOTINGS
67	E-6 TRAFFIC SIGNS, WARNING AND GUIDE SIGNS
68	E-7 STANDARD SIGN PLACEMENT
69	E-8 DELINEATORS, DETAILS
70	F-1 PROPERTY LINE FENCE, MODIFIED
70A	G-1 STANDARD STEEL BEAM GUARD RAIL
71	G-2A TWO CABLE GUARD RAIL
72	G-3 THREE CABLE GUARD RAIL WITH STEEL POSTS
73	G-4 STEEL MARKER POST AND PLANK GUARD RAIL
74	J-1 MARKER (PROPERTY AND BOUNDARY)
75	DRAINAGE [illegible]
76	[illegible]
77	TRAFFIC SIGN [illegible]
79	TRAFFIC SIGN LEGEND
1-0, 20A	BRIDGE SHEETS UNDER ABS AT 1132+50 (TOWN ROAD NO 50 AND EAST PUTNEY BROOK)
1-17A, 20-1	CROSS SECTIONS, INTERSTATE
292-301	CROSS SECTIONS, TOWN ROAD NO. 50
326-328	CHANNEL SECTIONS AT 1132+50 (EAST PUTNEY BROOK)

TOTAL NUMBER OF SHEETS 125

SHEET NUMBERS NOT LISTED ABOVE ARE NOT A PART OF THIS CONTRACT

PROJECT NAME	NUMBER	TYPE	PAVEMENT AREA
PUTNEY	I-91-1(10) Cont 2	BIT. CONC. PAVT.	91,968 S.Y.

RECORD PLANS

MATERIALS

SUBBASE OF GRAVEL-WOODS PIT — PUTNEY, VERMONT.
SUBBASE OF SAND-MACLAURY'S PIT & CHICKERING'S PIT-PUTNEY, VT.
CRUSHED ROCK & CRUSHED STONE-PERINI QUARRY-DUMMERSTON, VT.
REFINED TAR & ASPHALT-TRIMOUNT BITUMINOUS PRODUCTS CO.— EVERETT, MASSACHUSETTS.
BITUMINOUS CONCRETE — PERINI PLANT — DUMMERSTON, VERMONT.
CONCRETE CLASS "B", PEA STONE & GRITS — BRATTLEBORO SAND & GRAVEL CO.— BRATTLEBORO, VERMONT.
REINFORCING STEEL, STEEL MARKER POSTS, STEEL GRATE INLET [illegible] BASINS — BETHLEHEM STEEL [illegible] PENNSYLVANIA
REINFORCE[illegible] [illegible] JOHN MARIETTA CO.-WINDSOR, VT.
ASPHALT [illegible] GALVANIZED METAL PIPE — NORTH-[illegible] CO.— WESTMINSTER, VERMONT.
CABLE GU[illegible] [illegible] INC.— NEWTON LOWER FALLS, MASS.

ANCHORS FOR GUARD RAIL & BOUNDARY MARKERS — E. J. BAKER — NEEDHAM, MASSACHUSETTS.
GRANITE SLOPE EDGING — BARRETTA GRANITE CO.— MILFORD, N.H.
PROPERTY LINE FENCE WITH STEEL POSTS — CONTINENTAL STEEL CORP.— KOKOMO, INDIANA.
TREES, SHRUBS & VINES — PUTNEY NURSERY INC.— PUTNEY, VERMONT.
SIGNS & DELINEATORS — UNITED HIGHWAY SIGN CO. INC. — MERIDEN, CONN.

CONTRACTOR — PERINI CORP. FRAMINGHAM, MASS.
RESIDENT ENGINEER — DANIEL G. CADIZ.
INSPECTORS — K. PINKHAM & R. BENVEUTI.
RECORD PLANS — K. PINKHAM.

CONTRACT:
DATED — SEPTEMBER 29, 1959.
STARTED — OCTOBER 26, 1959.
COMPLETED — NOVEMBER 29, 1961.
ACCEPTED — NOVEMBER 29, 1961.

COUNTY
TOWN
FEN[illegible]
ST[illegible]
UN[illegible]
SU[illegible]
TR[illegible]
RA[illegible]
RE[illegible]
CE[illegible]
SU[illegible]
CO[illegible]
PR[illegible]
PR[illegible]
TE[illegible]
TH[illegible]

CONTRACTOR — PERINI CORP.
FRAMINGHAM, MASS.

GROUND ELEVATION — DATUM LINE
GRADE ELEVATION — DATUM LINE

CURVE DATA

DEFLECTION OF ANGLE	Δ
DEGREE OF CURVE	D
RADIUS OF CURVE	R
TANGENT DISTANCE	T
LENGTH OF CURVE	L
EXTERNAL DISTANCE	E
POINT OF INTERSECTION	PI
POINT OF CURVE	PC
POINT OF TANGENT	PT
POINT OF REVERSE CURVATURE	PRC

SCALES

TITLE	1" = 1500'
TYPICAL	1" = AS SHOWN
PLAN	1" = 50'
PROFILE HORIZONTAL	1" = 50'
PROFILE VERTICAL	1" = 10'
CROSS-SECTIONS	1" = 10'

THESE PLANS ARE SUBJECT TO SUCH REVISIONS AS MAY BE REQUIRED BY THE BUREAU OF PUBLIC ROADS OR THE COMMISSIONER OF HIGHWAYS.

CONSTRUCTION IS TO BE CARRIED ON IN ACCORDANCE WITH THE PLANS AND THE STANDARD ROAD AND BRIDGE SPECIFICATIONS OF JANUARY 1957 AS APPROVED JULY 5, 1956 BY THE BUREAU OF PUBLIC ROADS, INCLUDING ALL SUBSEQUENT APPROVED REVISIONS AND SUCH OTHER SPECIFICATIONS AND SPECIAL PROVISIONS AS ARE SUBMITTED WITH THE PLANS.

POOR ORIGINAL COPY

MP 18.42 - 22.79

DEPARTMENT OF COMMERCE
BUREAU OF PUBLIC ROADS
APPROVED

STATE OF VERMONT
DEPARTMENT OF HIGHWAYS
INTERSTATE PROJECT in the Town of PUTNEY