PUB. NO. DIV. NO.	STATE	FED. AID PROJECT NO.	FISCAL YEAR	SHEET NO.	TOTAL SHEETS
1	VT.	I-91-1(10)	POST WAP	26	328

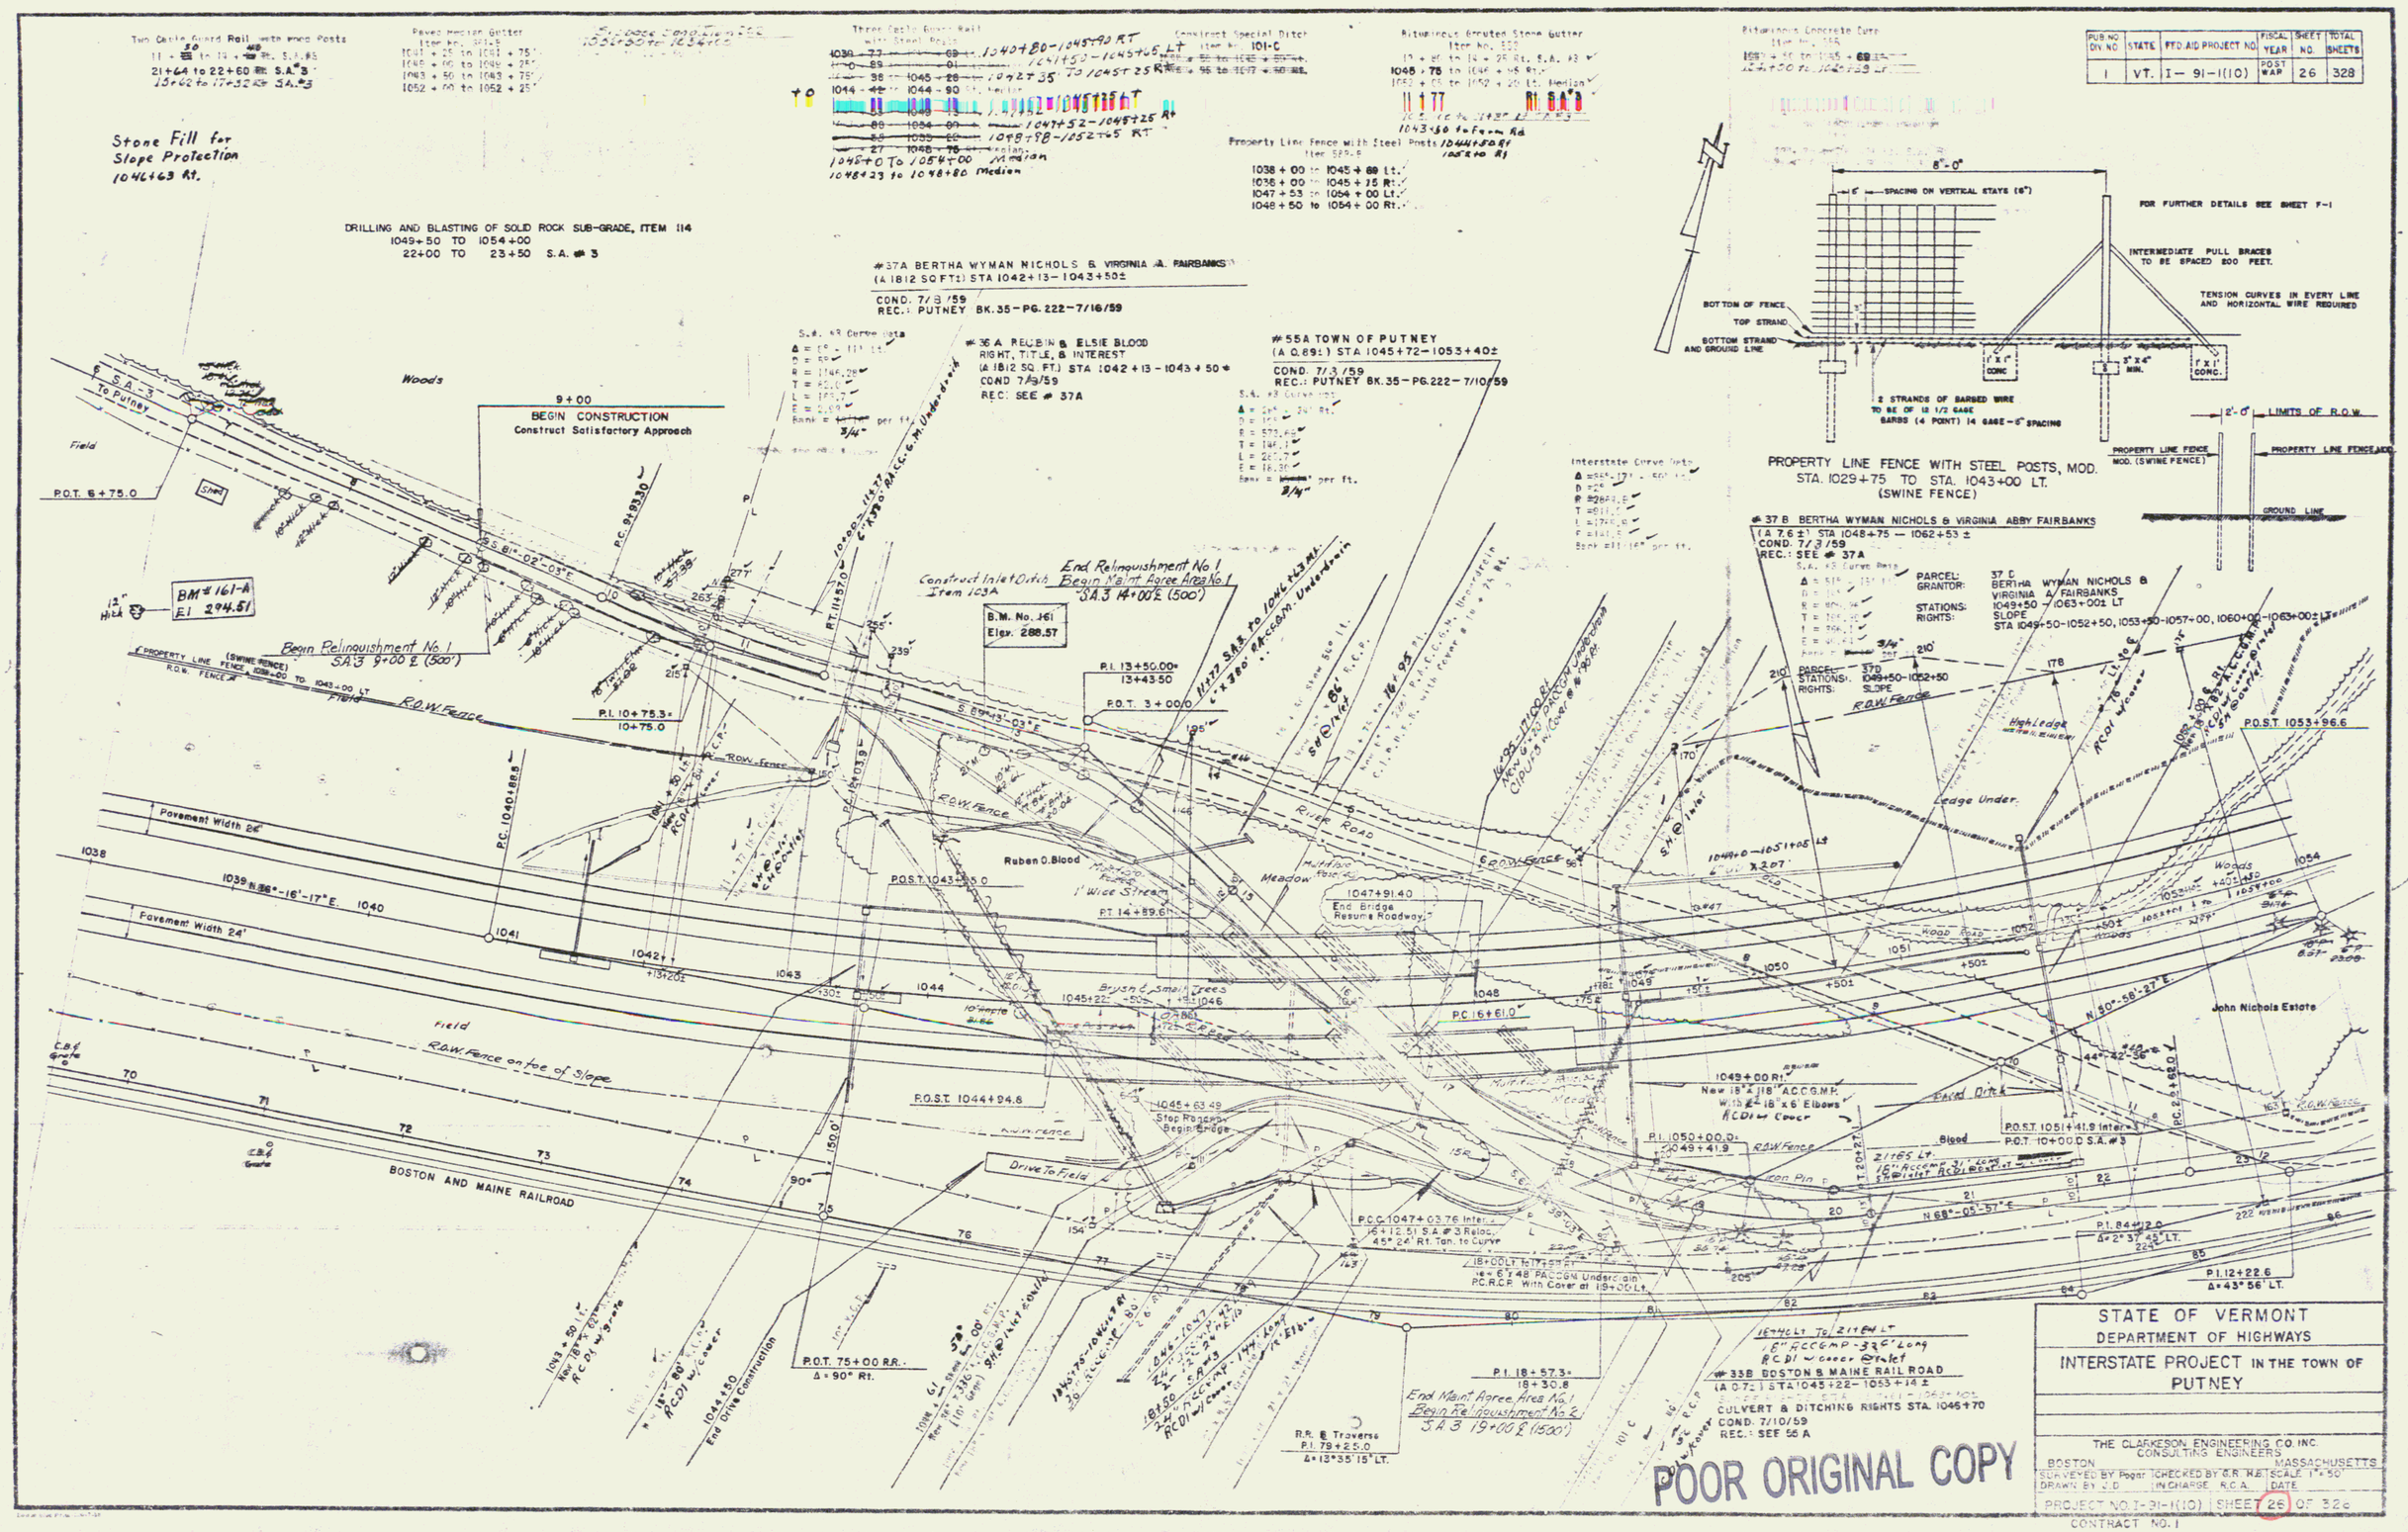

STATE OF VERMONT
DEPARTMENT OF HIGHWAYS
INTERSTATE PROJECT IN THE TOWN OF PUTNEY

THE CLARKESON ENGINEERING CO. INC.
CONSULTING ENGINEERS
BOSTON MASSACHUSETTS
SURVEYED BY Pogar CHECKED BY G.R. H.E. SCALE 1" = 50'
DRAWN BY J.D. IN CHARGE R.C.A. DATE
PROJECT NO. I-91-1(10) SHEET 26 OF 326
CONTRACT NO. 1