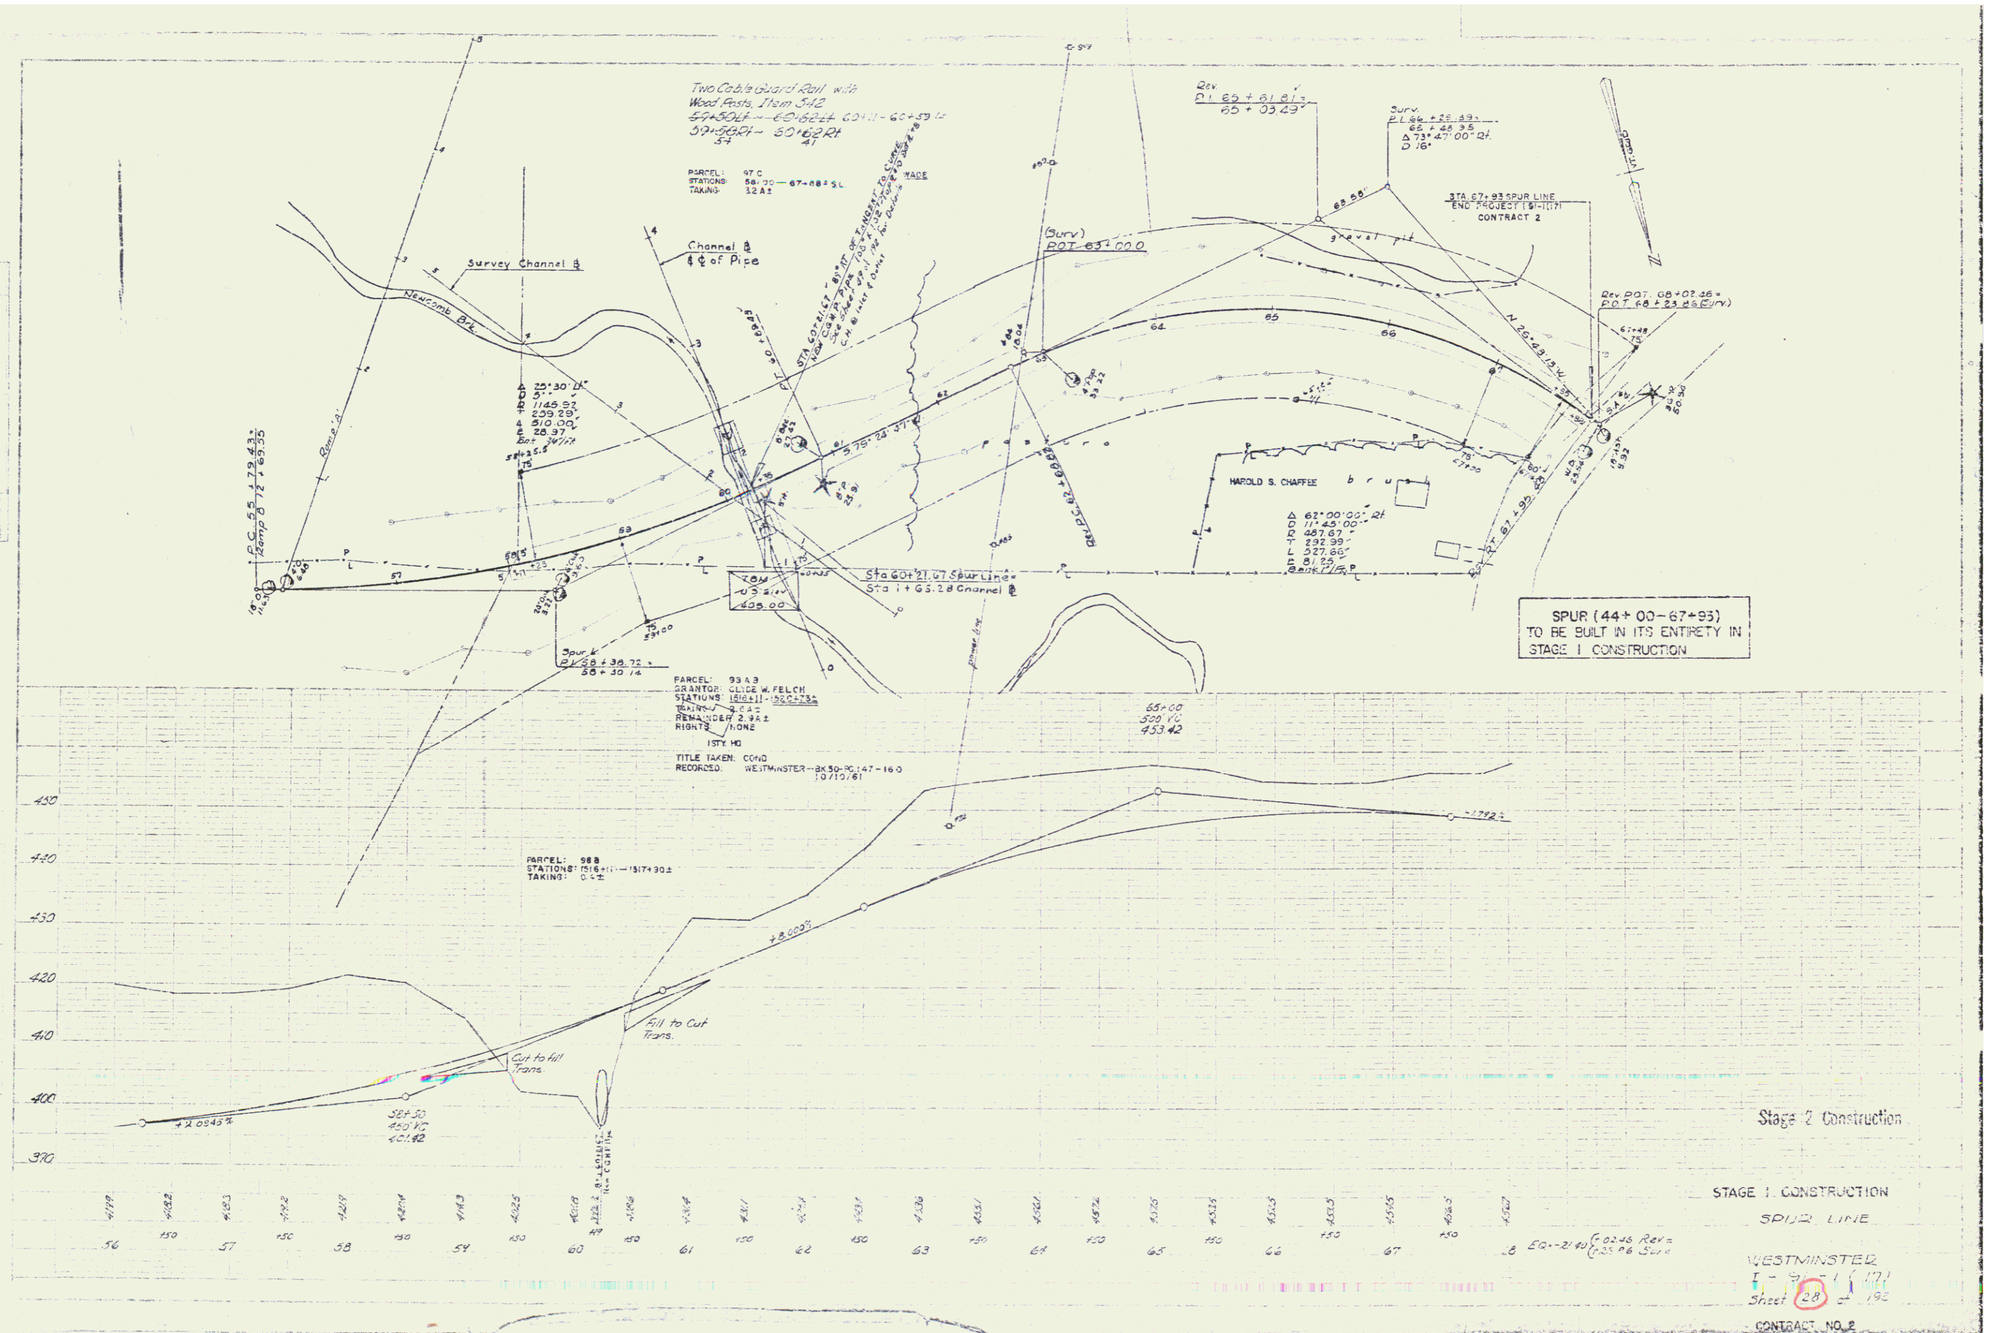
Two Cable Guard Rail with
Wood Posts, Item 542
Survey Channel ℄
Newcomb Brk.
Channel ℄
℄ of Pipe
(Surv)
POT 63+00.0
Rev.
POT 68+02.46 =
POT 68+23.46 (Surv)
HAROLD S. CHAFFEE
SPUR (44+00–67+93)
TO BE BUILT IN ITS ENTIRETY IN
STAGE 1 CONSTRUCTION
PARCEL: 97 C
STATIONS: 58+30 — 67+68 ± SL
TAKING: 32 A ±
PARCEL: 93 A 3
GRANTOR: CLIDE W. FELCH
PARCEL: 98 B
STATIONS: 15+16 ± — 15+74.90 ±
TAKING: 0.4 ±
TITLE TAKEN: COND
RECORDED: WESTMINSTER--BK 50-PG 147-160
10/10/61
+8.00%
Fill to Cut
Trans.
Cut to Fill
Trans.
Stage 2 Construction
STAGE 1 CONSTRUCTION
SPUR LINE
WESTMINSTER
Sheet 28
CONTRACT NO. 2

14