NOTE
In Order to Obtain Stable Slopes at the Terminal Point of the Contract, Earthwork Slopes shall be carried beyond the end of the Contract as Directed by the Engineer.

DRILLING & BLASTING OF SOLID ROCK SUBGRADE, ITEM 114 Mod
SBL Sta 1707+20 to Sta 1707+10
SBL Sta 1707+25 to Sta 1708+00
NBL Sta 1709+15 to Sta 1713+00

BITUMINOUS CONCRETE CURB - TYPE 1
SBL Sta 1709+45 to Sta 1714+33 Rt
NBL Sta 1708+77 to Sta 1713+00 Lt

HEAVY DUTY LINE FENCE W/STEEL POSTS
NBL Sta 1710+00 to Sta 1713+00 Rt

THREE CABLE GUARD RAIL W/STEEL POSTS
LEFT
NBL Sta 1708+00 to Sta 1713+00
SBL Sta 1705+00 to Sta 1713+00

PARCEL: 141
GRANTOR: FREDERICK L. OSGOOD, EST
STATIONS: 1705+10 SBL-1723+53 NBL
TAKING: 19.7A ± L.A.
REMAINDER: 13.3A ±
RIGHTS: LOSS OF ACCESS 3.0A ±
STA 1710+15 - 1724+79 NBL
TITLE TAKEN - COND. 12/6/61
RECORDED - ROCKINGHAM - BK 113 - PG 52 12/9/61

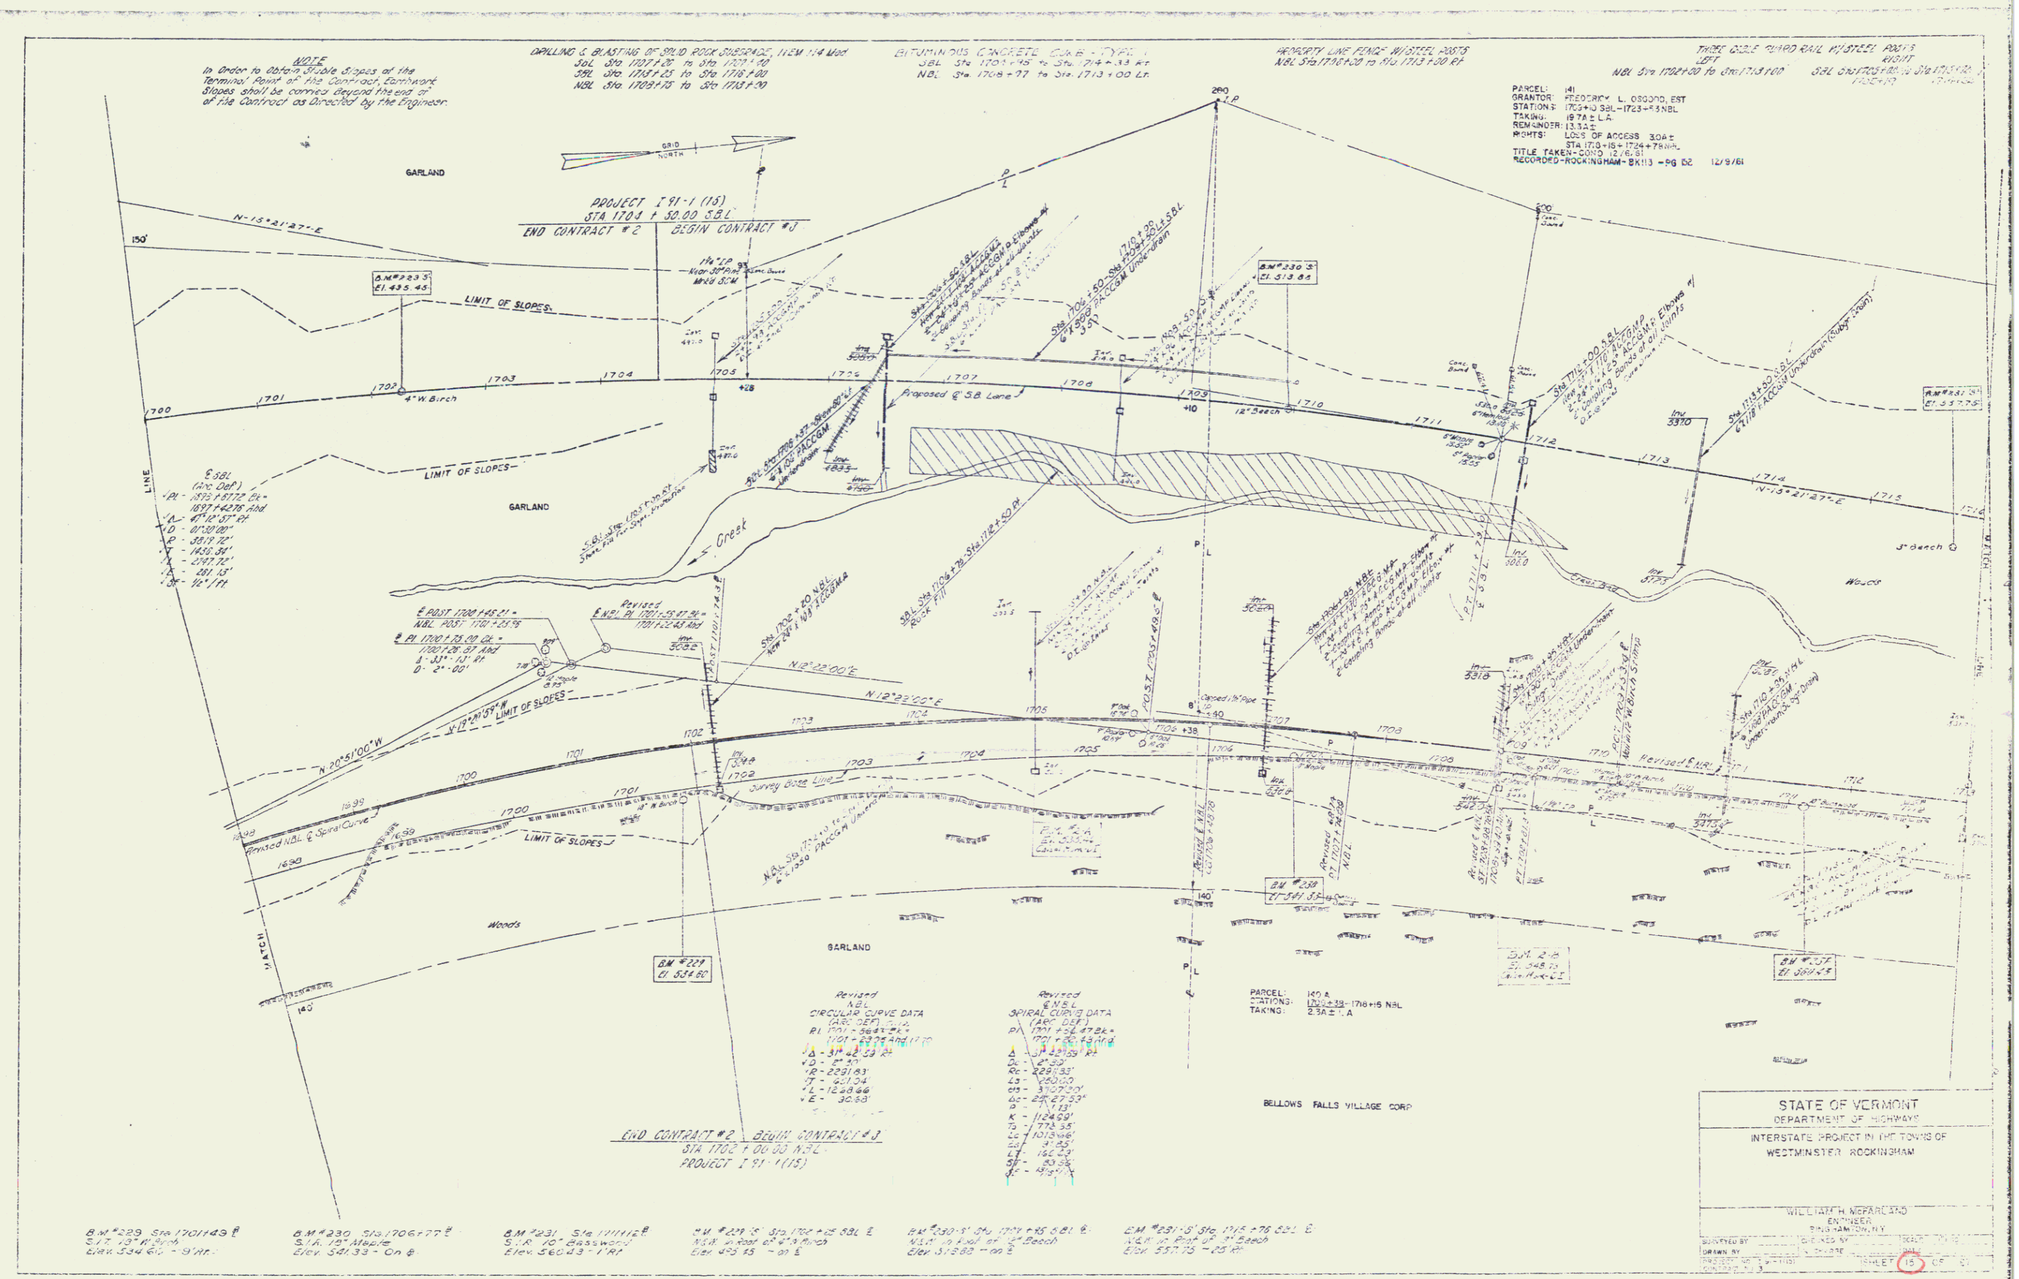

17