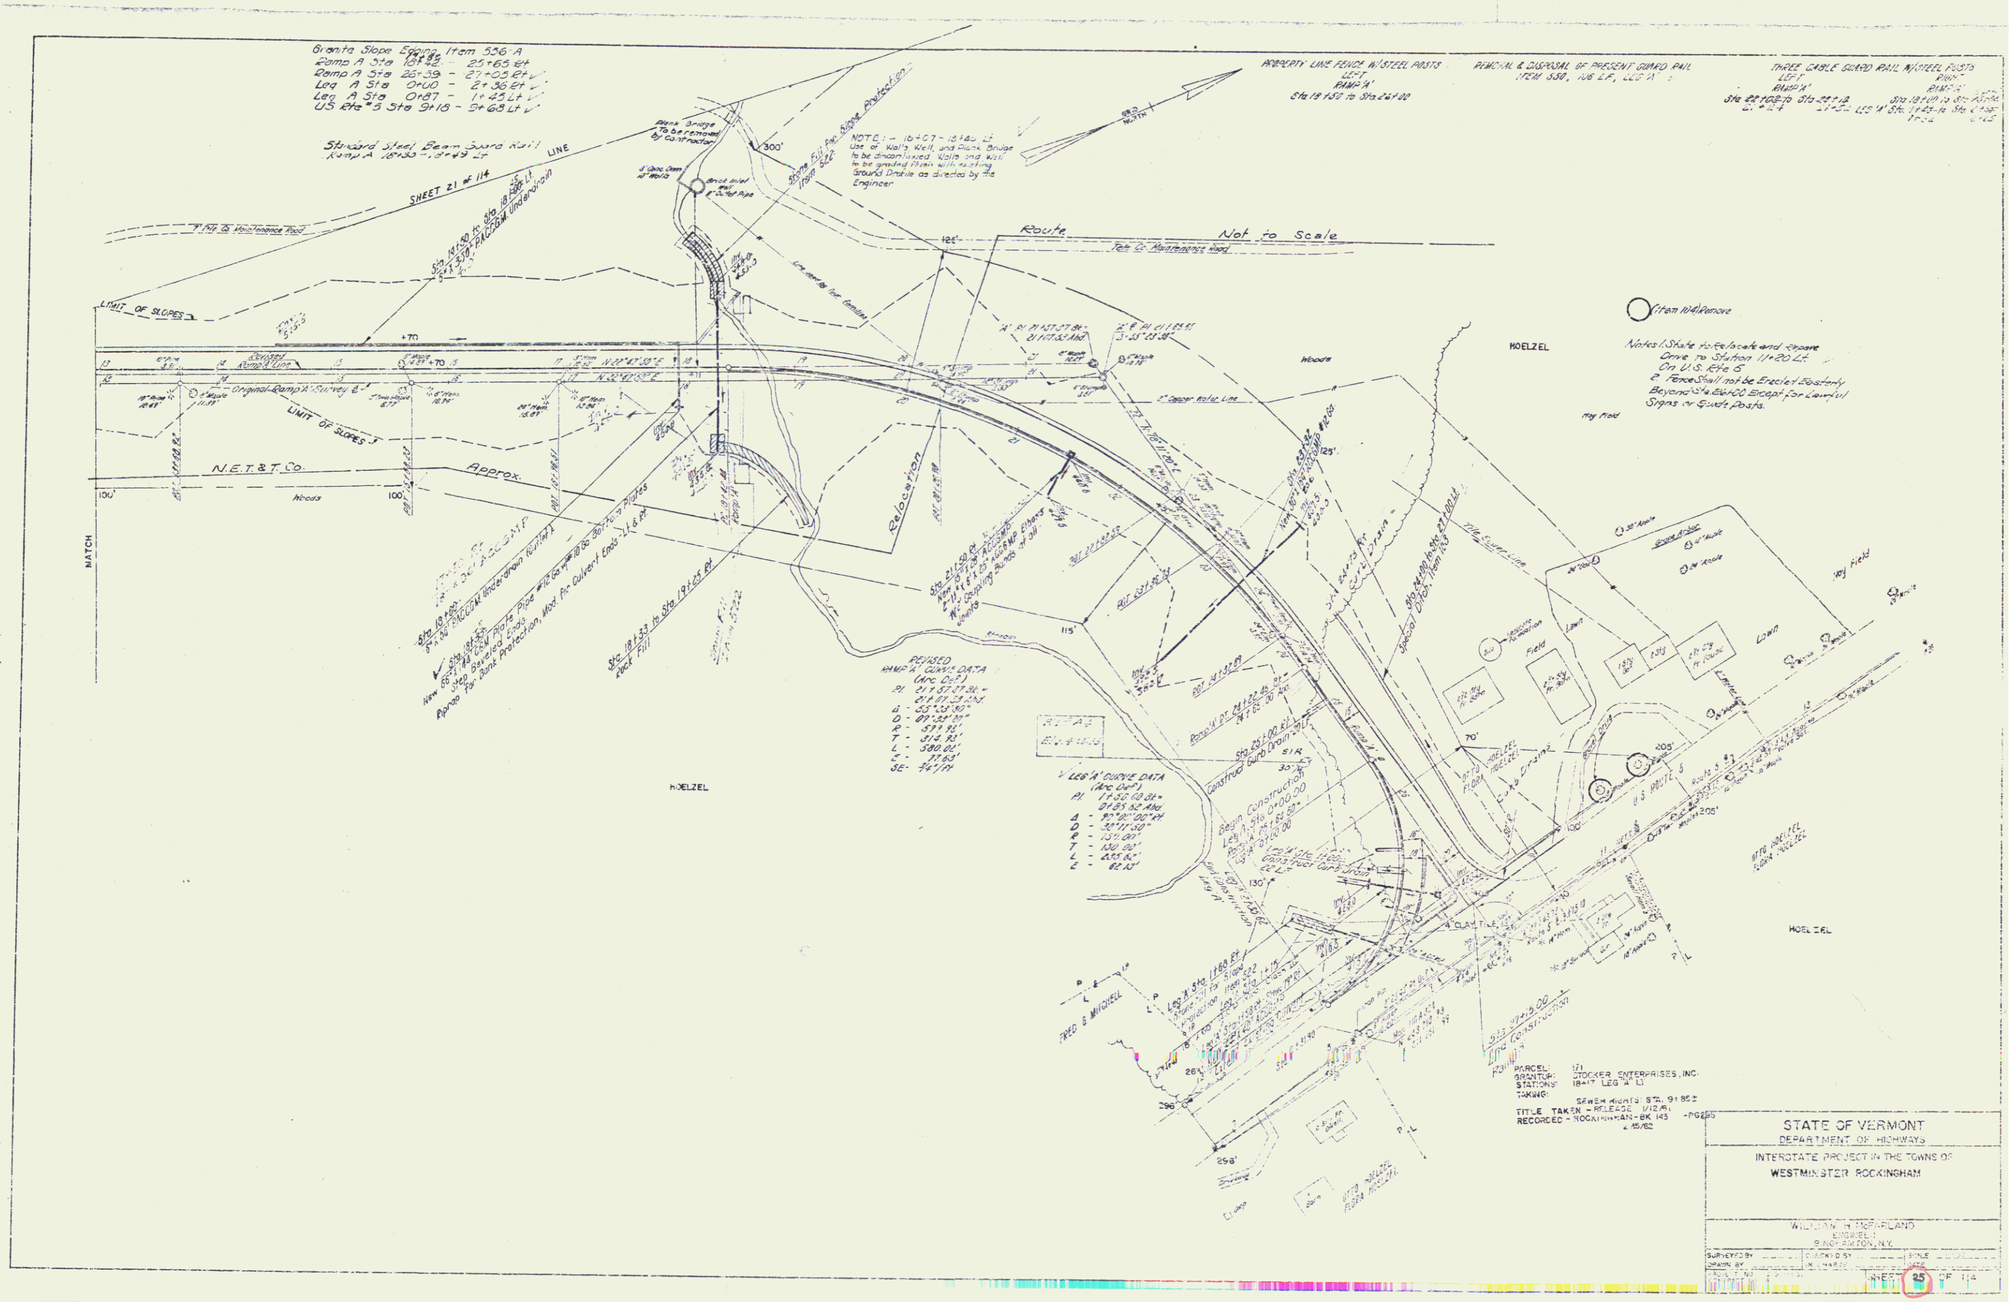
Granite Slope Facing, Item 536-A
Ramp A Sta 18+95 - 25+65 Rt
Ramp A Sta 26+39 - 27+05 Rt
Leg A Sta 0+00 - 2+36 Rt
Leg A Sta 0+87 - 1+25 Lt
US Rte 5 Sta 9+16 - 9+68 Lt
Standard Steel Beam Guard Rail
Ramp A 18+35 - 19+49 Lt
SHEET 21 of 114
Route
Not to Scale
Tele Co. Maintenance Road
LIMIT OF SLOPES
Original Ramp A Survey
N.E.T.&T. Co.
Approx
Woods
MATCH
Relocation
HOELZEL
Item 104 Remove
Hay Field
Lawn
U.S. ROUTE 5
REVISED RAMP "A" CURVE DATA
LEG "A" CURVE DATA
PARCEL: 171
GRANTOR: STOCKER ENTERPRISES, INC.
STATIONS: 18+17 LEG "A" Lt
TAKING: SEWER RIGHTS STA. 9+85±
TITLE TAKEN - RELEASE 1/12/81
RECORDED - ROCKINGHAM - BK 143 - PG 265
4/15/82
STATE OF VERMONT
DEPARTMENT OF HIGHWAYS
INTERSTATE PROJECT IN THE TOWNS OF
WESTMINSTER ROCKINGHAM
ENGINEER
SURVEYED BY
DRAWN BY
CHECKED BY
SCALE
SHEET 25 OF 114