STATE OF VERMONT

DEPARTMENT OF HIGHWAYS

PROPOSED IMPROVEMENT

INTERSTATE PROJECT IN THE TOWNS OF WESTMINSTER - ROCKINGHAM

COUNTY OF WINDHAM

PROJECT NO. I 91-1 (15)

CONTRACT NO. 5

Interstate Route I91

SHEET NO. INDEX OF SHEETS

1 TITLE PAGE
2 TYPICAL SECTIONS AND DETAILS-3" BITUMINOUS CONCRETE PAVEMENT, ITEM 361-B, MOD.
SUPERELEVATION TRANSITION TABLES
7-8 QUANTITY SHEETS, ITEMS
9-10 QUANTITY SHEETS, DRAINAGE
11-14 GRADE AND EARTHWORK SHEETS
15 EARTHWORK SUMMARY
16-30 PLAN AND PROFILE SHEETS
31 CANNELIZED INTERSECTION PLAN WITH PAVEMENT CONTOURS
32 TRAFFIC TURNING MOVEMENTS
32-A EMBANKMENT DETAILS AT WILLIAMS RIVER
33-36 TRAFFIC SIGN SHEETS-DESIGN, LOCATION AND SUMMARY
36-A DELINEATOR LOCATION PLAN
37-47 ROUTE 103 STRUCTURES
48 SCB-D-60 WF BEAM BRIDGES
49 SCB-30-58(1) 30'ROADWAY COMPOSITE BEAM BRIDGES
49A SCB-30-58(2) 30'ROADWAY COMPOSITE BEAM BRIDGES
50 SCB-42-58(1) 42'ROADWAY COMPOSITE BEAM BRIDGES
51 SCB-42-58(2) 42'ROADWAY COMPOSITE BEAM BRIDGES
52 SB-56-60 DETAILS OF BRIDGE RAILINGS (2 SHEETS)
53 SB-45-45°SKEW STEEL DETAILS OF APPROACH SLABS FOR 15° BRIDGES
54 SB-20-56 CONSTRUCTION DETAILS FOR WF BRIDGES
55 SB-22-56 DETAIL OF EXPANSION JOINT OVER PIERS AND ABUTMENTS
56 A-61 DRILLING AND BLASTING OF SOLID ROCK
57 B-1 BANKING TABLES
58 B-5 TYPICAL SLOPE GRADING
59 B-6 MUCK EXCAVATION
60 H-13 DRIVEWAY DETAILS
61 B-15 ENTRANCE AND EXIT TERMINALS
62 B-16 DIVISIONAL ISLAND AND TRIANGULAR ISLAND DESIGN
63 B-17 DETAIL OF GUARD RAIL IN MEDIAN, SAFETY TURNOUT AND U-TURN
64 C-1 CURBS
65 D-1 PRECAST R.C.P. DROP INLETS AND CATCH BASINS
66 D-2 HEADWALLS AND UNDERDRAIN
67 D-3 GUTTERS
68 D-4 PLATE PIPE, PIPE ELBOWS, FLUSHING BASINS, AND METAL END SECTIONS
69 D-8 REINFORCED CONCRETE DROP INLETS
70 D-10 TOP FOR A DROP INLET
71 D-11 GRATES AND COVERS FOR DROP INLETS
71-A D-13 CONCRETE FLAT BASIN OR MANHOLE
72 E-1 BARRICADES, SIGNS AND LIGHTS (ROADWAY)
73 E-3 REGULATORY SIGNS
74 E-4 ROUTE MARKERS AND AUXILIARY MARKERS
75 E-5 SIGN POST FOOTINGS
76 E-6 REGULATORY, WARNING AND GUIDE SIGNS
77 E-7 STANDARD SIGN PLACEMENT
78 E-8 DELINEATORS
78-A E-9 CONSTRUCTION IDENTIFICATION SIGNS
79 F-1 PROPERTY LINE FENCE
80 G-1 STEEL BEAM GUARD RAIL
81 G-3 THREE CABLE GUARD RAIL
82 G-4 MARKER POSTS AND GUIDE POSTS
83 J-1 PROJECT MARKERS AND BOUNDARY MARKERS
84 J-3 MINIMUM PLANTING DISTANCES
84A J-4 FIELD OFFICE DETAILS
85-141 CROSS SECTIONS

TOTAL NUMBER OF SHEETS 147

SHEETS 17, 18, 19, 20 & 107 THRU 117 ARE PRINTS

SHEETS ADDED BY FINALS ARE:

19A - 19G, 107A THRU 107S (FINAL)

1-9-16-R ODD & REVISED SECTIONS

REMAINING SHEETS D-1 - D-246 A

PROJECT | BEGIN PROJECT I 91-1(15) | STA. 1844+00.00 | N. 817,367.89 | E. 512,964.29

[PROJECT NAME & NUMBER | TYPE PAVEMENT | AREA]
WESTMINSTER ROCKINGHAM | BITUMINOUS CONC. | 17,315 SQ.YD.

RECORD PLANS

MATERIALS

SUBBASE OF GRAVEL — FOUNTAIN PIT — BARTONSVILLE, VT.
— STODDARD PIT — ROCKINGHAM, VT.
— PARDA PIT — SEXTONS RIVER, VT.
SUBBASE OF CRUSHED GRAVEL & CRUSHED STONE BASE COURSE CRUSHED STONE SHOULDERS, PEASTONE & CHIPS — PERINI QUARRY — WESTMINSTER, VT.
TAR & ASPHALT — THE VOID BITUMINOUS PRODUCTS CO. — EVERETT, MASS.
TAR EMULSION — BORDEN CHEMICAL CO. — NEW YORK, N.Y.
BITUMINOUS CONCRETE — LAWRENCE ASPHALT PAVING (PLANT) — ATTLEBORO
JOINT SEALER HOT POURED ELASTIC TYPE — SERVICISED PRODUCTS CO. — CHICAGO, ILL.
CONCRETE CLASS "B" — CHARLESTOWN READY MIX — CHARLESTOWN, N.H.
REINFORCING STEEL & CABLE GUARD RAIL — BETHLEHEM STEEL CORP. — BETHLEHEM, PA.
REINFORCED CONCRETE PIPE — MARTIN MARIETTA CORP. — WINDSOR, VT.
ASPHALT COATED CORRUGATED GALVANIZED METAL PIPE — REPUBLIC STEEL CORP. — YOUNGSTOWN, OHIO
STEEL DITCH GRATES — IRVING SUBWAY GRATING CO. INC. — LONG ISLAND CITY, N.Y.
CAST IRON COVERS FOR FLUSHING BASINS — ETHERIDGE FOUNDRY & MACHINE CO. — PORTLAND, MAINE.
PLAIN GUARD RAIL — NEW ENGLAND POLE & WOOD PRESERVING CO. — SUDBURY, MASS.
GUARD RAIL — BETHLEHEM STEEL CO. — BETHLEHEM, N.H.
GRANITE SLOPE EDGING & CURBS — BENNETTS QUARRIES — MILFORD, N.H.
SIGNS — BELLE STORE — STANDARD SIGN CO. — CLINTON, MASS.
SITE MATERIAL — PELTON & LESURE — SWANZEY, N.H.
PANELS SHOWING A WIRES — SIDNEY ALLEN INC. — PUTNEY, VT.

BEGINNING 3.635 MILES NORTH OF THE WESTMINSTER-ROCKINGHAM TOWN LINE AT STATION 1844+00 AND CONTINUING IN A NORTHERLY DIRECTION 0.615 MILES TO STATION 1876+46.48

LENGTH OF ROADWAY = 3,084.48 FEET = 0.584 MILES
LENGTH OF BRIDGE = 162.00 FEET = 0.031 MILES
LENGTH OF CONTRACT = 3,246.48 FEET = 0.615 MILES

DESIGN DESIGNATION

ADT-1980 = 2280
ADT-1975 = 5060
DHV-1975 = 715
T = 7%
D = 54%
V = (70) M.P.H.

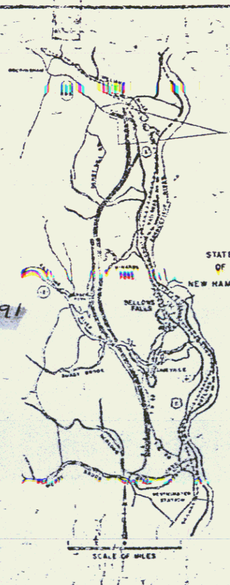

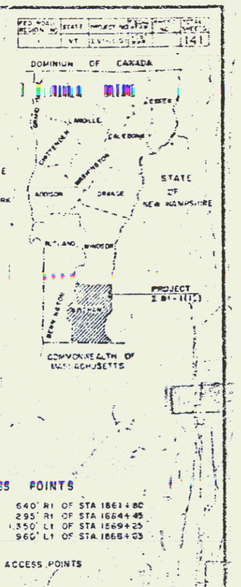

ACCESS POINTS

RAMP ENTRANCE	640' RT OF STA 1863+80
RAMP ENTRANCE	295' RT OF STA 1864+45
RAMP ENTRANCE	1350' LT OF STA 1869+25
RAMP ENTRANCE	960' LT OF STA 1868+05

LEGEND: X DESIGNATES ACCESS POINTS

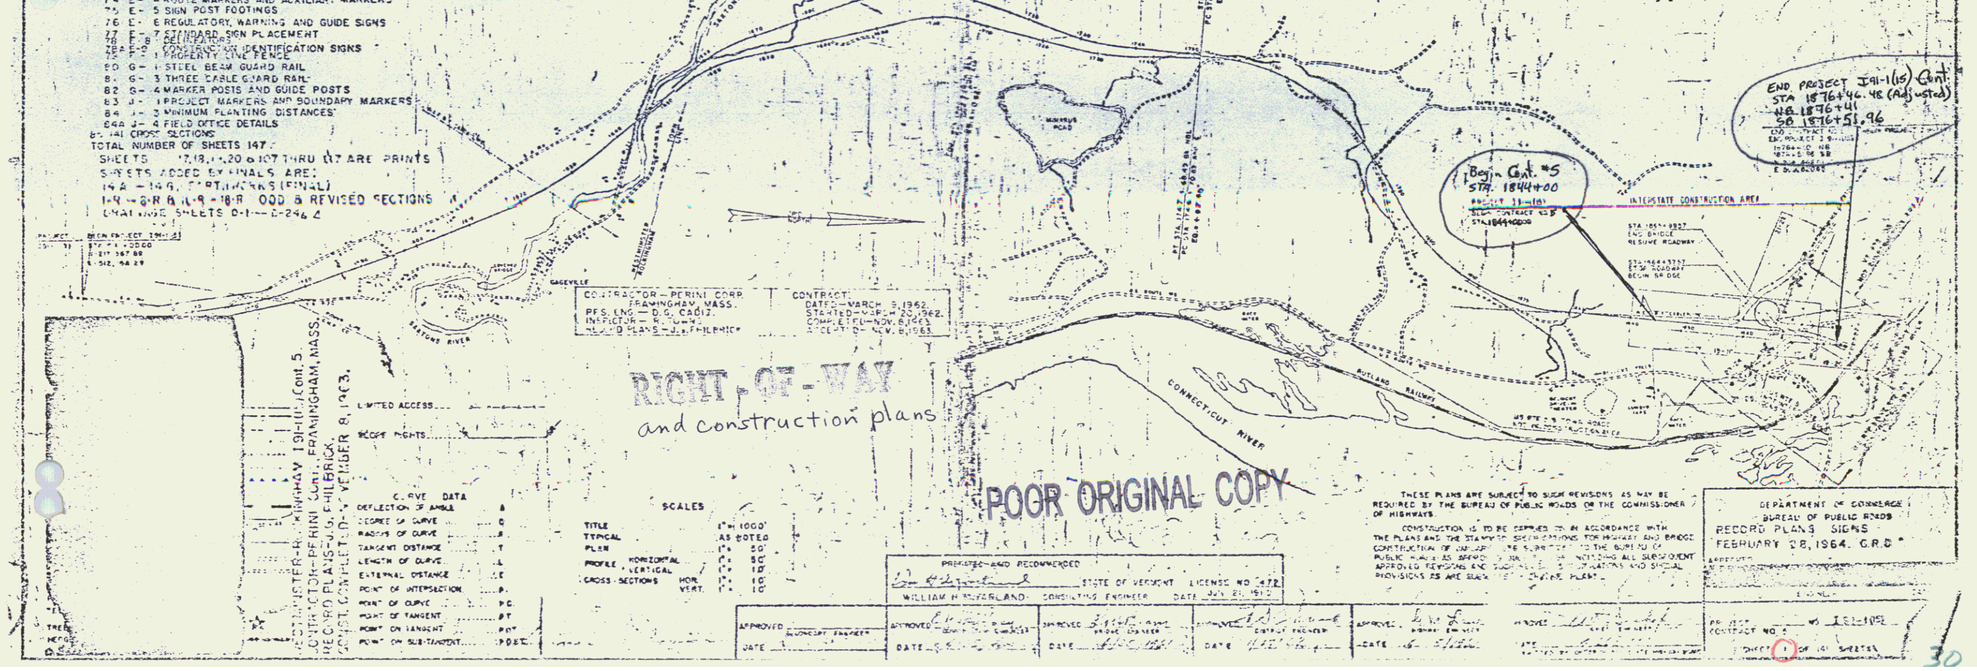

LIMITED ACCESS

ROOF RIGHTS

CURVE DATA

DEFLECTION OF ANGLE	Δ
DEGREE OF CURVE	D
RADIUS OF CURVE	R
TANGENT DISTANCE	T
LENGTH OF CURVE	L
EXTERNAL DISTANCE	E
POINT OF INTERSECTION	P.I.
POINT OF CURVE	P.C.
POINT OF TANGENT	P.T.
POINT ON TANGENT	P.O.T.
POINT ON SUB-TANGENT	P.O.S.T.

SCALES

TITLE	1" = 1000'
TYPICAL	AS NOTED
PLAN	1" = 50'
PROFILE HORIZONTAL	1" = 50'
PROFILE VERTICAL	1" = 10'
CROSS-SECTIONS HOR.	1" = 10'
CROSS-SECTIONS VERT.	1" = 10'

PREPARED AND RECOMMENDED
STATE OF VERMONT LICENSE NO. 472

THESE PLANS ARE SUBJECT TO SUCH REVISIONS AS MAY BE REQUIRED BY THE BUREAU OF PUBLIC ROADS OR THE COMMISSIONER OF HIGHWAYS.

CONSTRUCTION IS TO BE PERFORMED IN ACCORDANCE WITH THE PLANS AND THE STANDARD SPECIFICATIONS FOR HIGHWAY AND BRIDGE CONSTRUCTION OF [illegible] OF THE BUREAU OF PUBLIC ROADS AS AMENDED TO DATE, INCLUDING ALL SUBSEQUENT APPROVED REVISIONS AND SUPPLEMENTAL SPECIFICATIONS AND SPECIAL PROVISIONS AS ARE SHOWN [illegible] CONTRACT PLANS.

APPROVED [illegible] ENGINEER — DATE [illegible]
APPROVED [illegible] ENGINEER — DATE [illegible]
APPROVED [illegible] ENGINEER — DATE [illegible]
APPROVED [illegible] ENGINEER — DATE [illegible]
APPROVED [illegible] ENGINEER — DATE [illegible]

BUREAU OF PUBLIC ROADS
RECORD PLANS SIGNS
FEBRUARY 28, 1964. C.R.D.

PROJECT NO. I 91-1(15)E
CONTRACT NO. 5
SHEET 1 OF 147 SHEETS

30