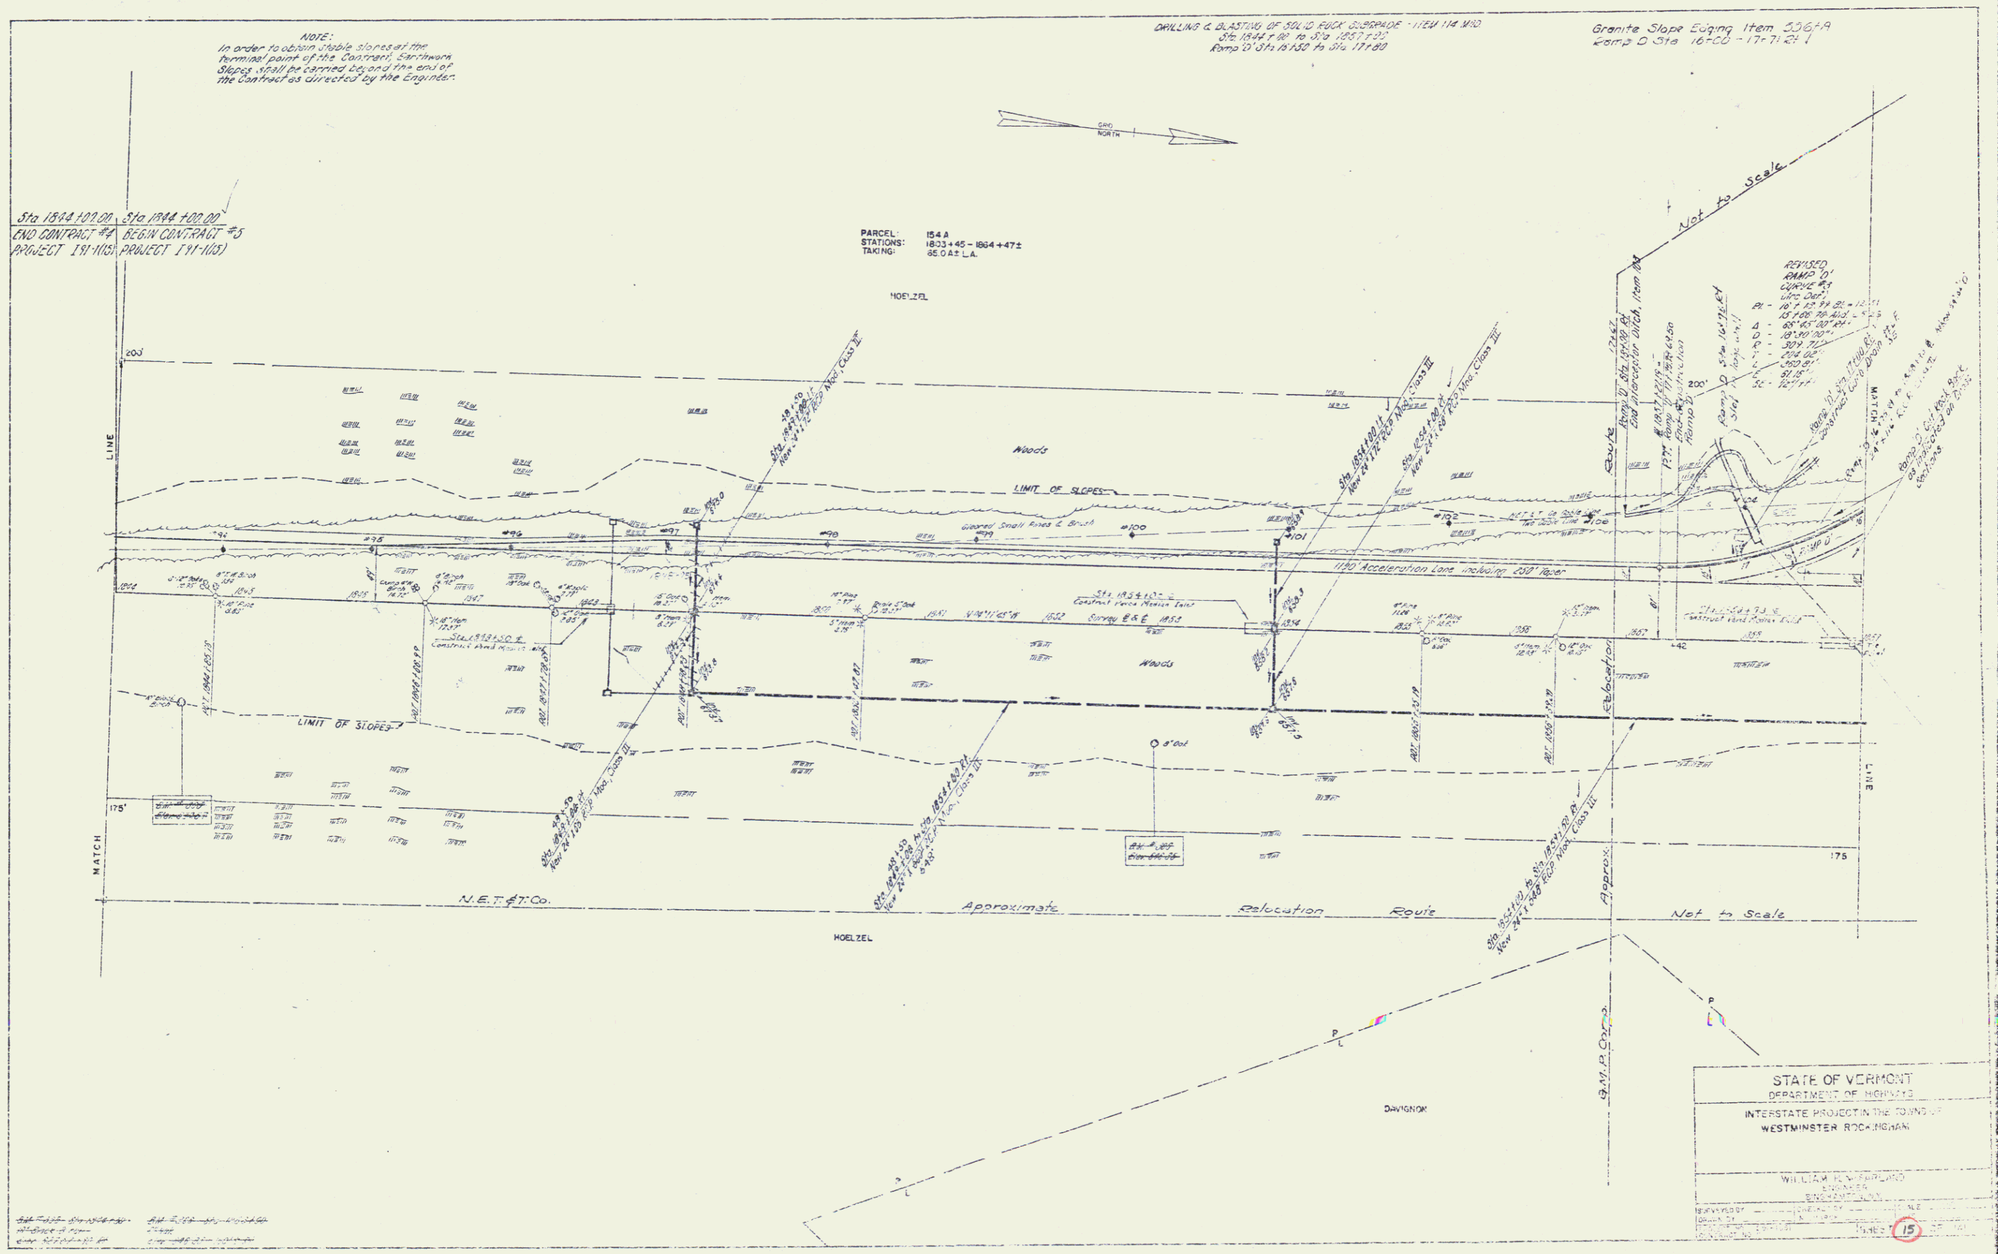
NOTE:
In order to obtain stable slopes at the terminal point of the Contract, Earthwork Slopes shall be carried beyond the end of the Contract as directed by the Engineer.
DRILLING & BLASTING OF SOLID ROCK SUBGRADE - ITEM 114 V10
Sta 1844+98 to Sta 1857+00
Ramp D Sta 16+50 to Sta 17+00
Granite Slope Edging Item 536.4A
Ramp D Sta 16+00 - 17+71.24 ±
GRID NORTH
Not to Scale
Sta 1844+00.00, Sta 1844+00.00
END CONTRACT #4 BEGIN CONTRACT #5
PROJECT I 91-1(15) PROJECT I 91-1(15)
PARCEL: 154 A
STATIONS: 1833+45 - 1864+47±
TAKING: 85.0 A± L.A.
HOELZEL
Woods
LIMIT OF SLOPES
Granite Small Knee & Brush
1120 Acceleration Lane including 250' Taper
Survey E.&E. 1853
Construct Fence Metric Text
Sta 1853+00 to Sta 1857+00 Rock Cut Nov. Class III
Sta 1844+00 to Sta 1853+00 Rock Cut Nov. Class III
Sta 1857+00 to Sta 1864+00 Rock Cut Nov. Class III
Approx. Relocation Route
Approx. Relocation
REVISED RAMP D
CURVE #1
Curve Data
Ramp D Sta 16+71.24
End Intersection Ditch, Item 204
Construct Ditch Block Item 204
