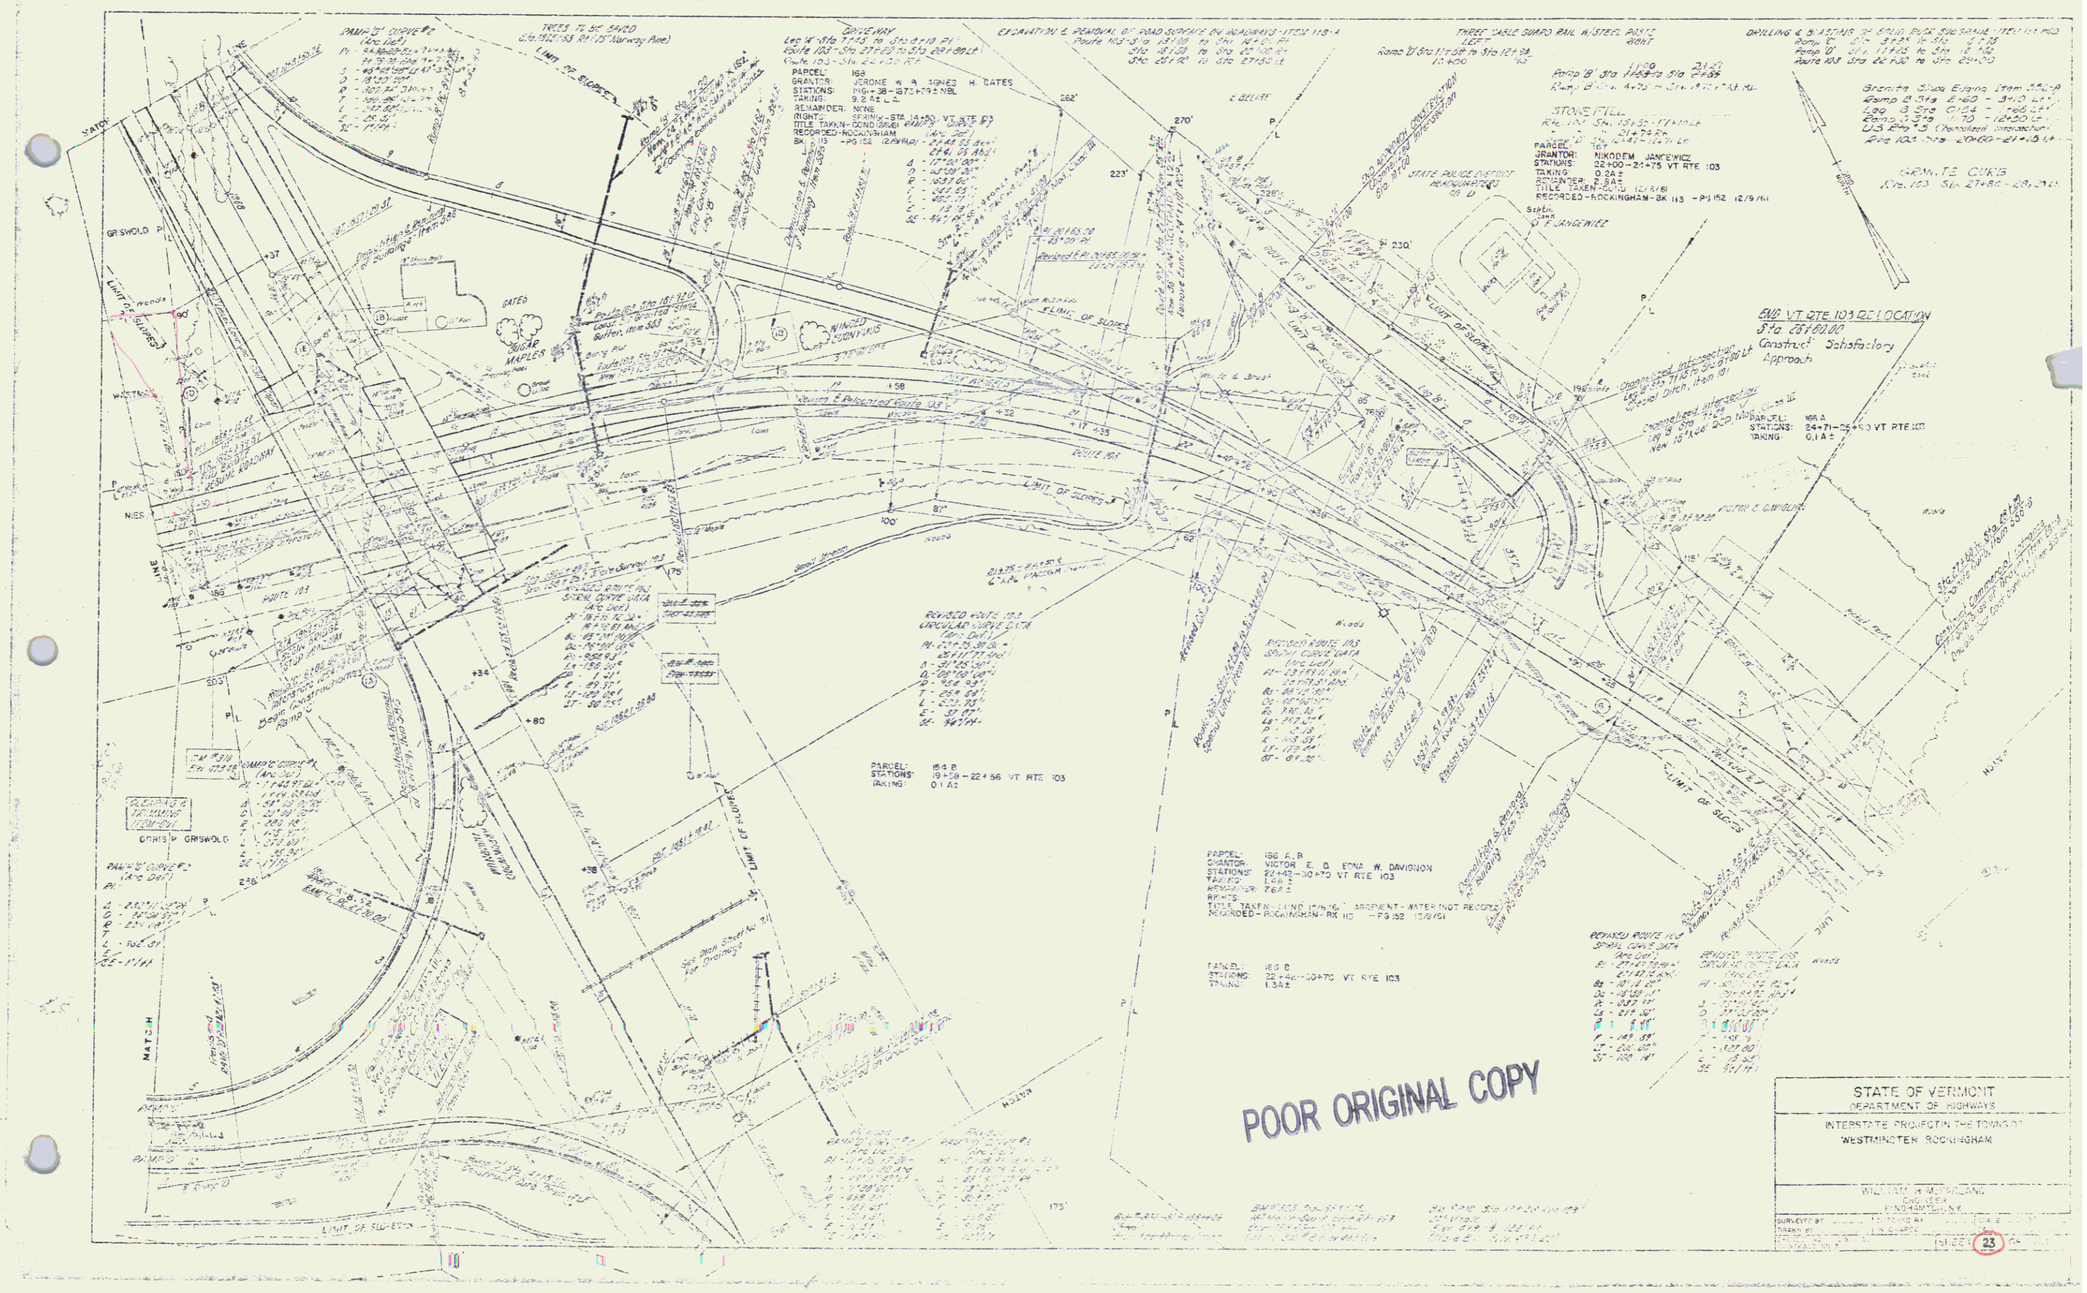
STATE OF VERMONT
DEPARTMENT OF HIGHWAYS
INTERSTATE PROJECT IN THE TOWN OF
WESTMINSTER ROCKINGHAM
POOR ORIGINAL COPY