* THREE CABLE GUARD RAIL w/ STEEL POSTS
1954 + 00 – 1961 + 33 Rt. N.B.

* STANDARD STEEL BEAM GUARD RAIL
1960 + 24 – 1960 + 78 Lt. S.B.

* BITUMINOUS CONCRETE CURB, TYPE II, ITEM 655
1956 + [illegible] – [illegible] N.B. Rt.

OUTLET CHANNEL – 1957 + 80 – 1961 + 41 N.B. Rt.

CONCRETE GUTTER
1961 + 78 N.B. Rt.
1961 + 71 N.B. Y Inlet Extension to Median
1961 + 75 N.B. Lt.
1958 + 70 N.B. Lt.

DRILLING & BLASTING OF SOLID ROCK SUBGRADE
S.B. 1962 + 50 – 1963 + 50
N.B. 1961 + 50 – 1966 + 50

LANDSCAPE MATERIAL
1959 + 50 – 1960 + 50 Rt.
Black Locust, S 250
Red Pine, S 50
White Pine, S 50
1961 + 00 – 1965 + 00 N.B. Lt. 40' – 52' (Median)
Pink Tatarian Honeysuckle 100

* Stage 2 Construction

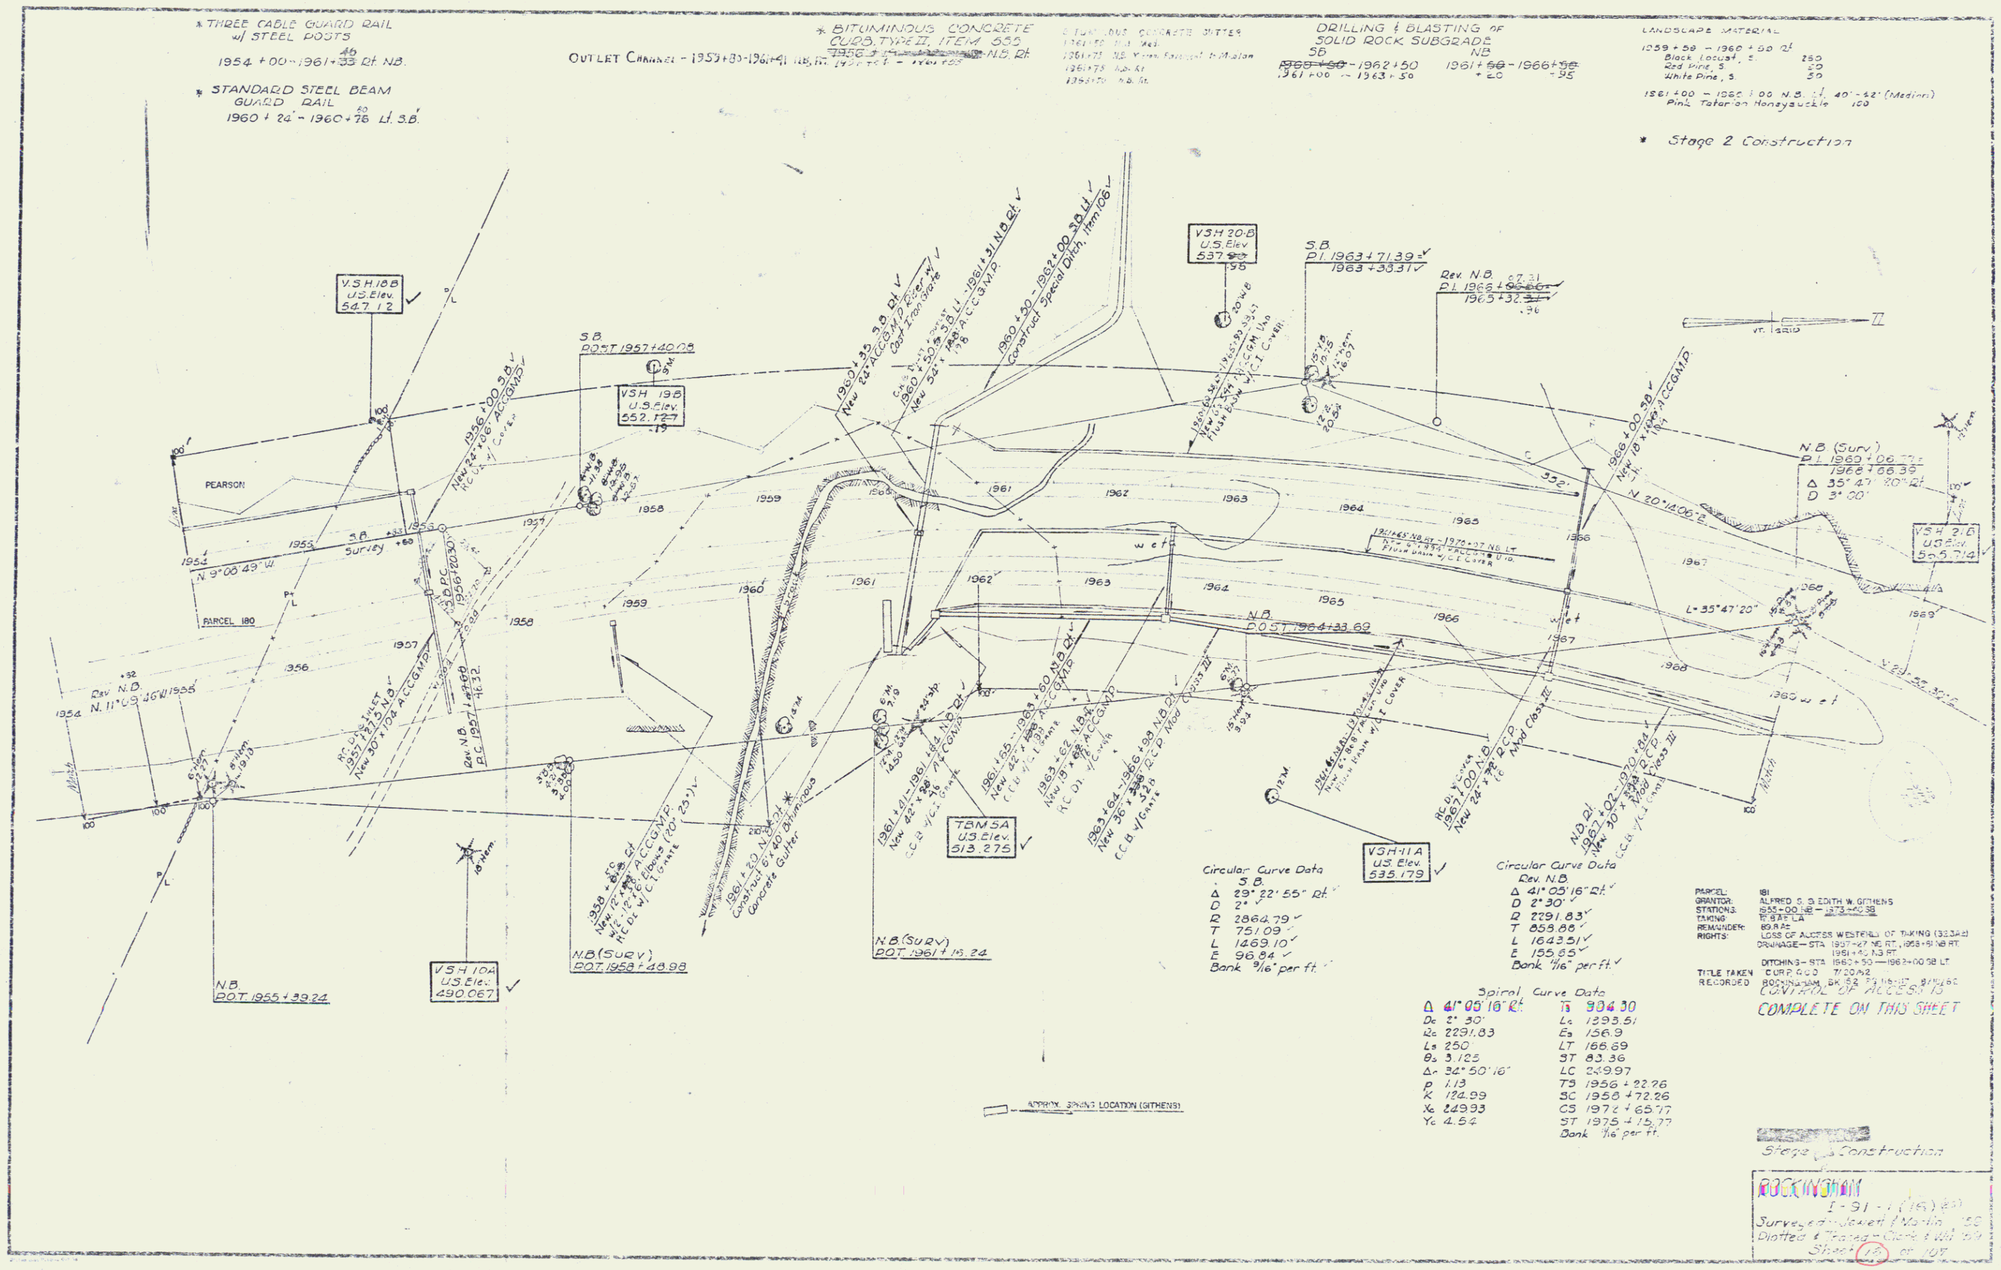

Circular Curve Data
S.B.
Δ 29° 22' 55" Rt.
D 2°
R 2864.79
T 751.09
L 1469.10
E 96.84
Bank 9/16" per ft.

Circular Curve Data
Rev. N.B.
Δ 41° 05' 16" Rt.
D 2° 30'
R 2291.83
T 858.85
L 1643.51
E 155.65
Bank 1/16" per ft.

Spiral Curve Data

Δ 41° 05' 16" Rt.	TS 904.30
Dc 2° 30'	Ls 1393.51
Rc 2291.83	Es 156.9
Ls 250	LT 166.69
θs 3.125	ST 83.36
Δc 34° 50' 16"	LC 249.97
p 1.13	TS 1956 + 22.26
k 124.99	SC 1958 + 72.26
Xs 249.93	CS 1972 + 65.77
Ys 4.52	ST 1975 + 15.77
	Bank 1/16" per ft.

PARCEL: 181
GRANTOR: ALFRED S. & EDITH W. GITHENS
STATIONS: 555 + 00 NB – 1973 + 40.38
TAKING: 19.84 ± L.A.
REMAINDER: 80.16 ±
RIGHTS: LOSS OF ACCESS WESTERLY OF TAKING (383.34 ±)
DRAINAGE – STA 1957 + 47 N.B. Rt., 1958 + 91 N.B. Rt., 1961 + 42 N.B. Rt.
DITCHING – STA 1962 + 50 – 1962 + 00.98 Lt.
RECORDED ROCKINGHAM, DK. 52 PG. 118-119, 8/14/62

CONTROL OF ACCESS IS COMPLETE ON THIS SHEET

Stage 2 Construction

ROCKINGHAM
I-91 – (165) (61)
Surveyed – Robert J. Martin
Drafted & Traced – Clark & Wilson
Sheet 13 of 107