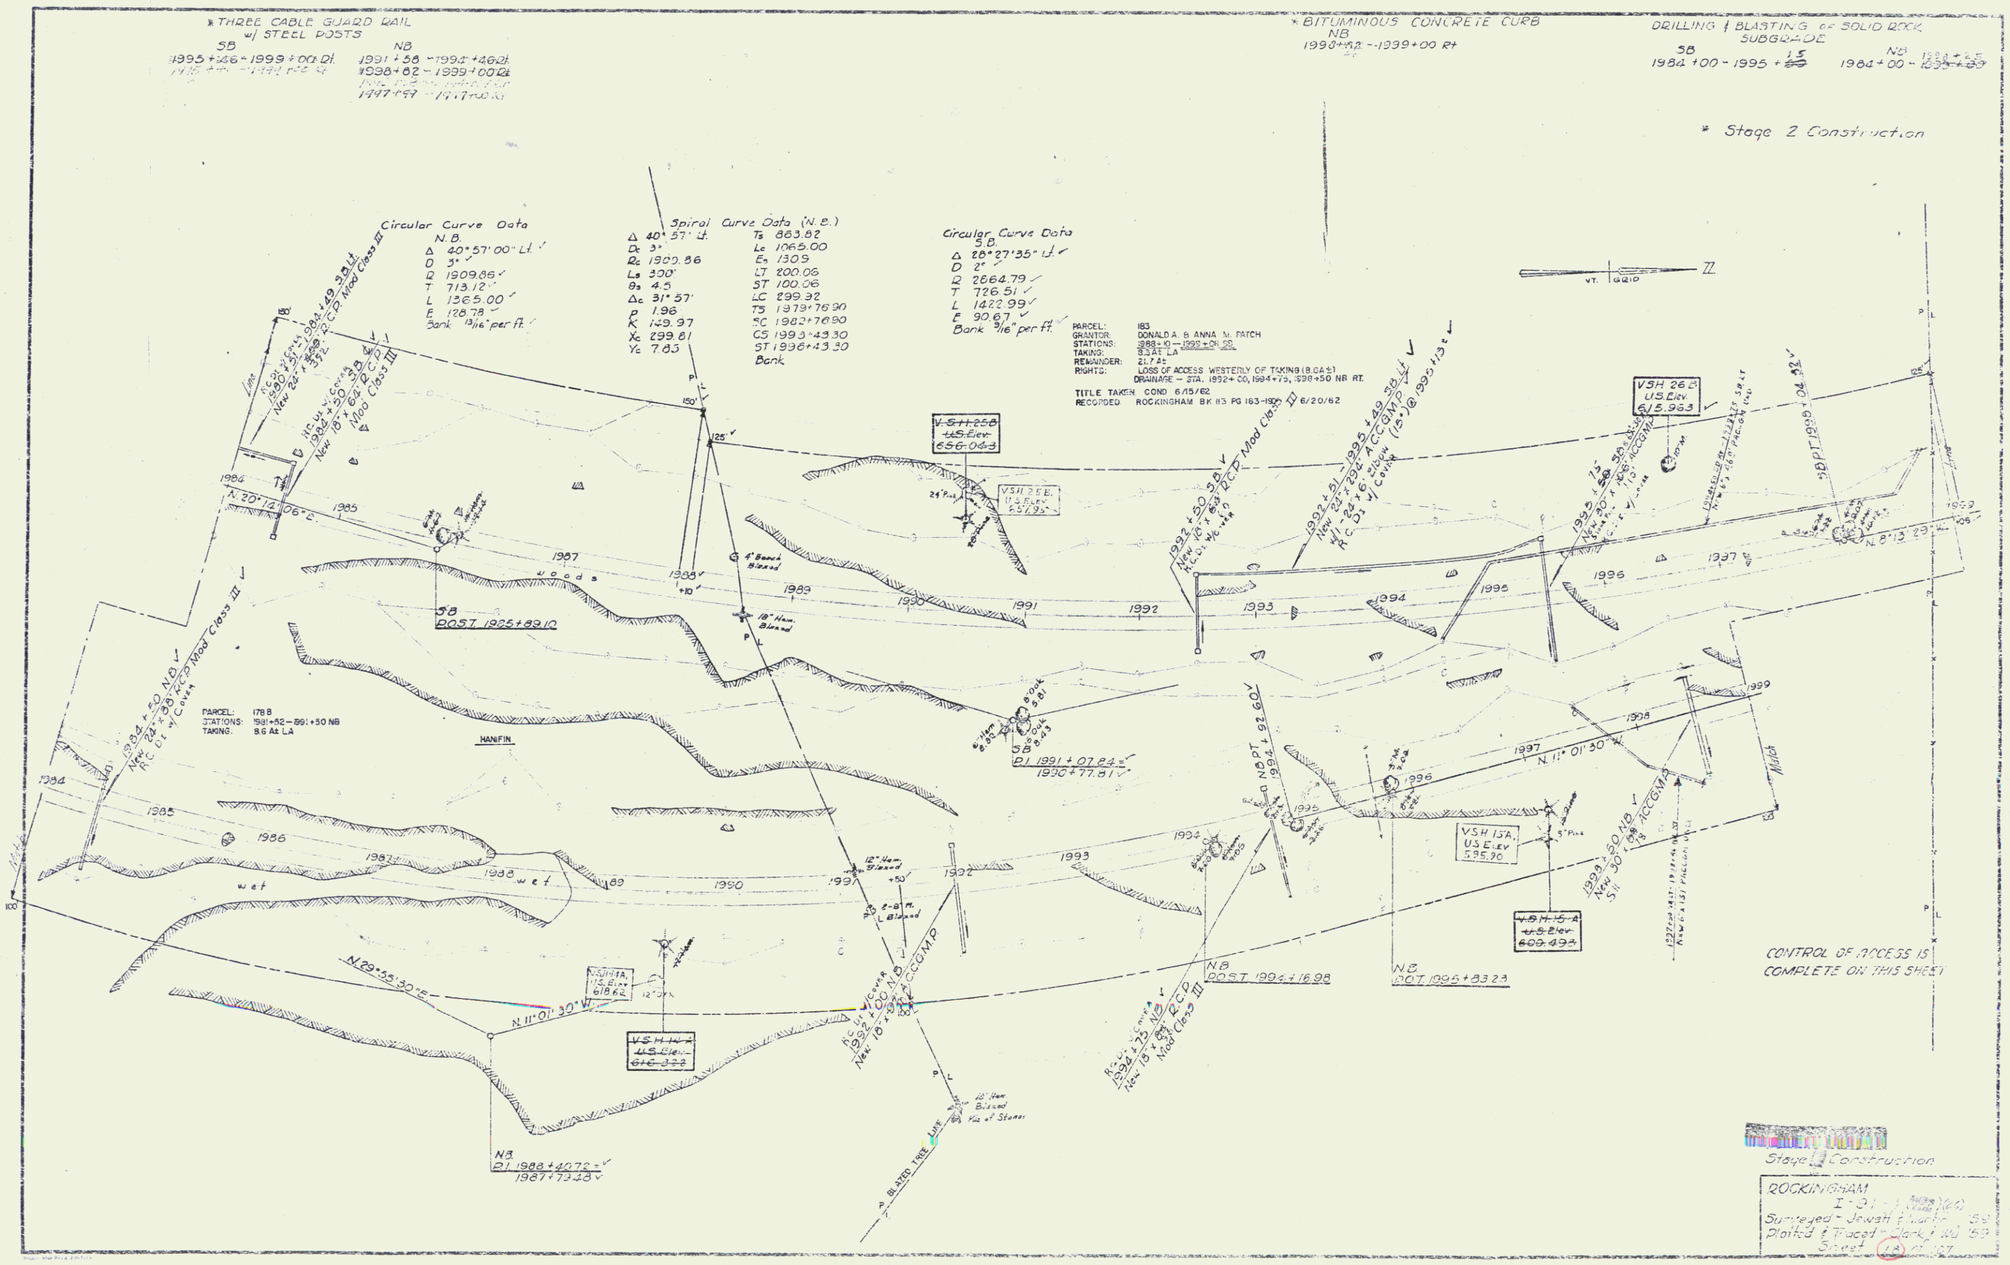
* THREE CABLE GUARD RAIL w/ STEEL POSTS
SB 1995+26 - 1999+00 Rt.
NB 1991+58 - 1995+46 Rt.
1998+82 - 1999+00 Rt.
* BITUMINOUS CONCRETE CURB NB 1998+62 - 1999+00 Rt
DRILLING & BLASTING OF SOLID ROCK SUBGRADE
SB 1984+00 - 1995+15
NB 1984+00 - 1995+15
* Stage 2 Construction
Circular Curve Data N.B.
Δ 40°57'00" Lt.
D 3°
R 1909.86
T 713.12
L 1365.00
E 126.78
Bank 9/16" per ft.
Spiral Curve Data (N.B.)
Δ 40°57' Lt.
Dc 3°
Rc 1909.86
Ls 300'
θs 4.5
Δc 31°57'
P 1.98
K 149.97
Xc 299.81
Yc 7.83
Ts 863.82
Lc 1065.00
Es 13.05
LT 200.06
ST 100.06
LC 299.92
TS 1979+76.90
SC 1982+76.90
CS 1995+43.30
ST 1996+43.30
Bank
Circular Curve Data S.B.
Δ 28°27'35" Lt.
D 2°
R 2864.79
T 726.51
L 1422.99
E 90.67
Bank 9/16" per ft.
PARCEL: 183
GRANTOR: DONALD A. & ANNA M. PATCH
STATIONS: 1988+10 — 1993+00 SB
TAKING: 8.3 AT L.A
REMAINDER: 21.7 AC
RIGHTS: LOSS OF ACCESS WESTERLY OF TAKING (8.04 ±)
DRAINAGE — STA. 1992+00, 1994+75, 1998+50 NB RT.
TITLE TAKEN COND 6/15/62
RECORDED ROCKINGHAM BK 113 PG 163-190 6/20/62
PARCEL: 178 B
STATIONS: 1991+52 — 1991+50 NB
TAKING: 8.6 AT L.A
HANIFIN
SB POST 1925+89.10
SB P.I. 1991+07.24
1990+77.61
NB POST 1994+16.98
NB POST 1995+83.23
NB P.I. 1988+40.72
1987+73.18
N.11°01'30"W
N.29°55'30"E
N.20°14'06"E
N.8°13'29"W
CONTROL OF ACCESS IS COMPLETE ON THIS SHEET
Stage 1 Construction
ROCKINGHAM
Surveyed - Jewett & Hurlburt
Plotted & Traced - Clark
Sheet 12