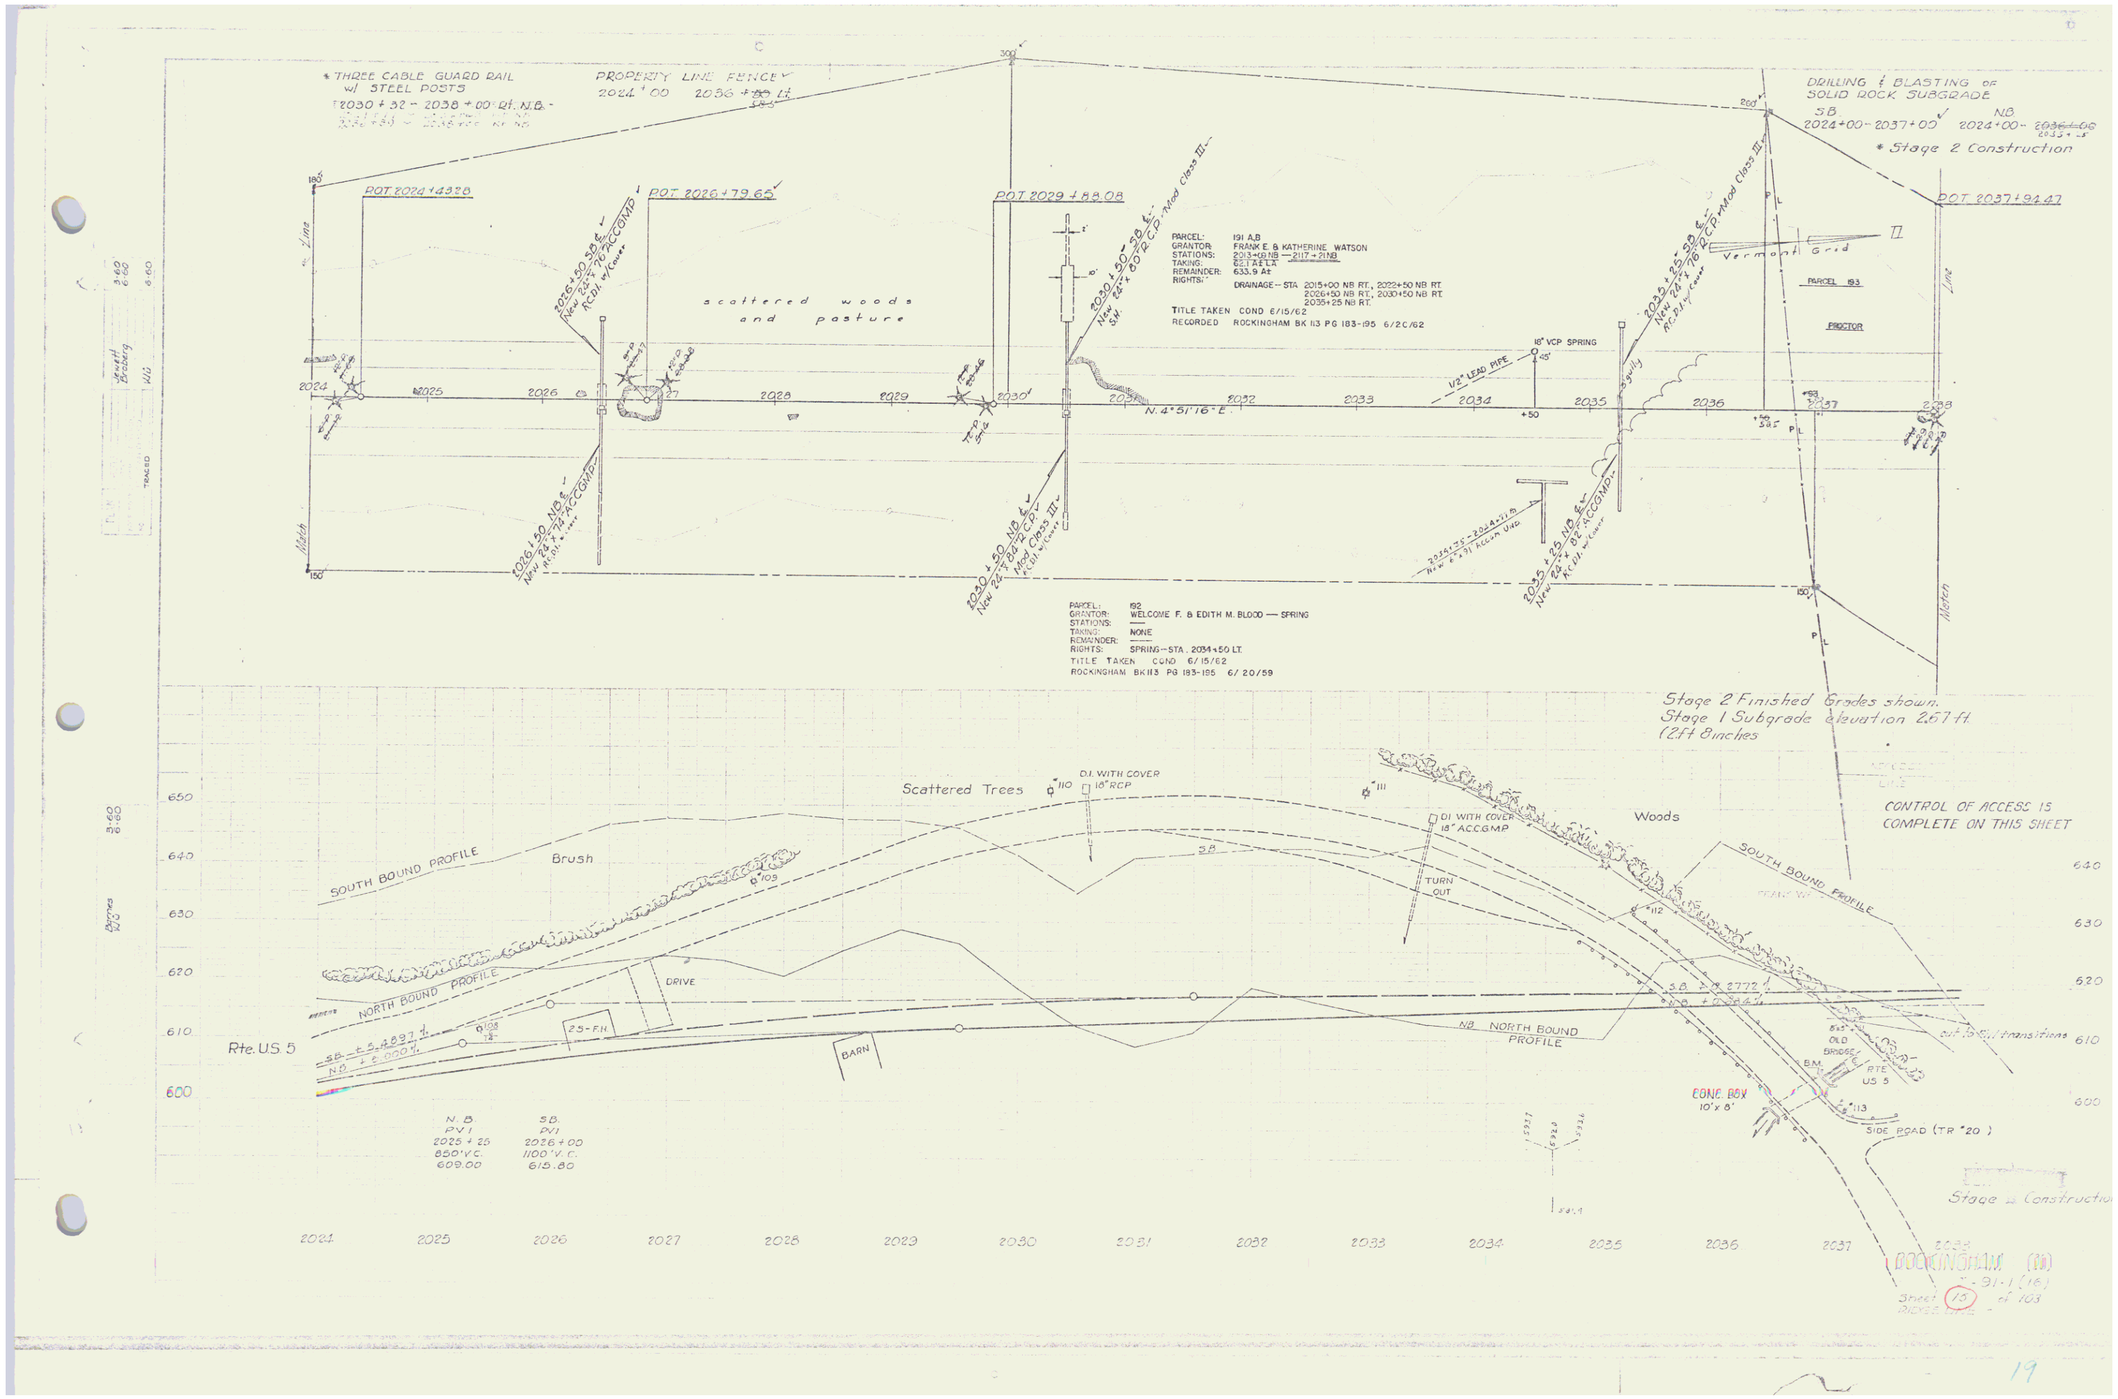
* THREE CABLE GUARD RAIL w/ STEEL POSTS
2030 + 32 - 2038 + 00 Rt. N.B.
PROPERTY LINE FENCE
2024 + 00 2036 + 50 Lt.
DRILLING & BLASTING OF SOLID ROCK SUBGRADE
SB 2024+00 - 2037+00
NB 2024+00 - 2035+00
* Stage 2 Construction
POT 2024+43.28
POT 2026+79.65
POT 2029+88.08
POT 2037+94.47
scattered woods and pasture
PARCEL: 191 A,B
GRANTOR: FRANK E. & KATHERINE WATSON
STATIONS: 2013+61 NB — 2117+21 NB
TAKING: 8.17 & 1.4 A±
REMAINDER: 633.9 A±
RIGHTS: DRAINAGE -- STA. 2015+00 NB RT., 2022+50 NB RT
2026+50 NB RT., 2030+50 NB RT
2035+25 NB RT.
TITLE TAKEN COND 6/15/62
RECORDED ROCKINGHAM BK 113 PG 183-195 6/20/62
Vermont Grid
PARCEL 193
PROCTOR
18" VCP SPRING
1/2" LEAD PIPE
N. 4°51'16" E.
PARCEL: 192
GRANTOR: WELCOME F. & EDITH M. BLOOD — SPRING
STATIONS: —
TAKING: NONE
REMAINDER: —
RIGHTS: SPRING-STA. 2034+50 LT.
TITLE TAKEN COND 6/15/62
ROCKINGHAM BK 113 PG 183-195 6/20/59
Stage 2 Finished Grades shown.
Stage 1 Subgrade elevation 2.67 ft (2ft 8inches
CONTROL OF ACCESS IS COMPLETE ON THIS SHEET
Scattered Trees
D.I. WITH COVER 18" RCP
D.I. WITH COVER 18" ACCGMP
Woods
Brush
SOUTH BOUND PROFILE
NORTH BOUND PROFILE
TURN OUT
DRIVE
BARN
Rte. US 5
NB NORTH BOUND PROFILE
CONC. BOX 10'x8'
OLD BRIDGE
SIDE ROAD (TR #20)
N. B. PVI 2025 + 25 850' V.C. 609.00
S.B. PVI 2026 + 00 1100' V.C. 615.80
Stage 2 Construction
Sheet 13 of 103

19