


SEE NEXT PAGE FOR WEST BOUNDARY

PLAN	BY	DATE
SURVEYED	Barabara	60
PLOTTED	Fisher	60
TRACED	W.L.	60

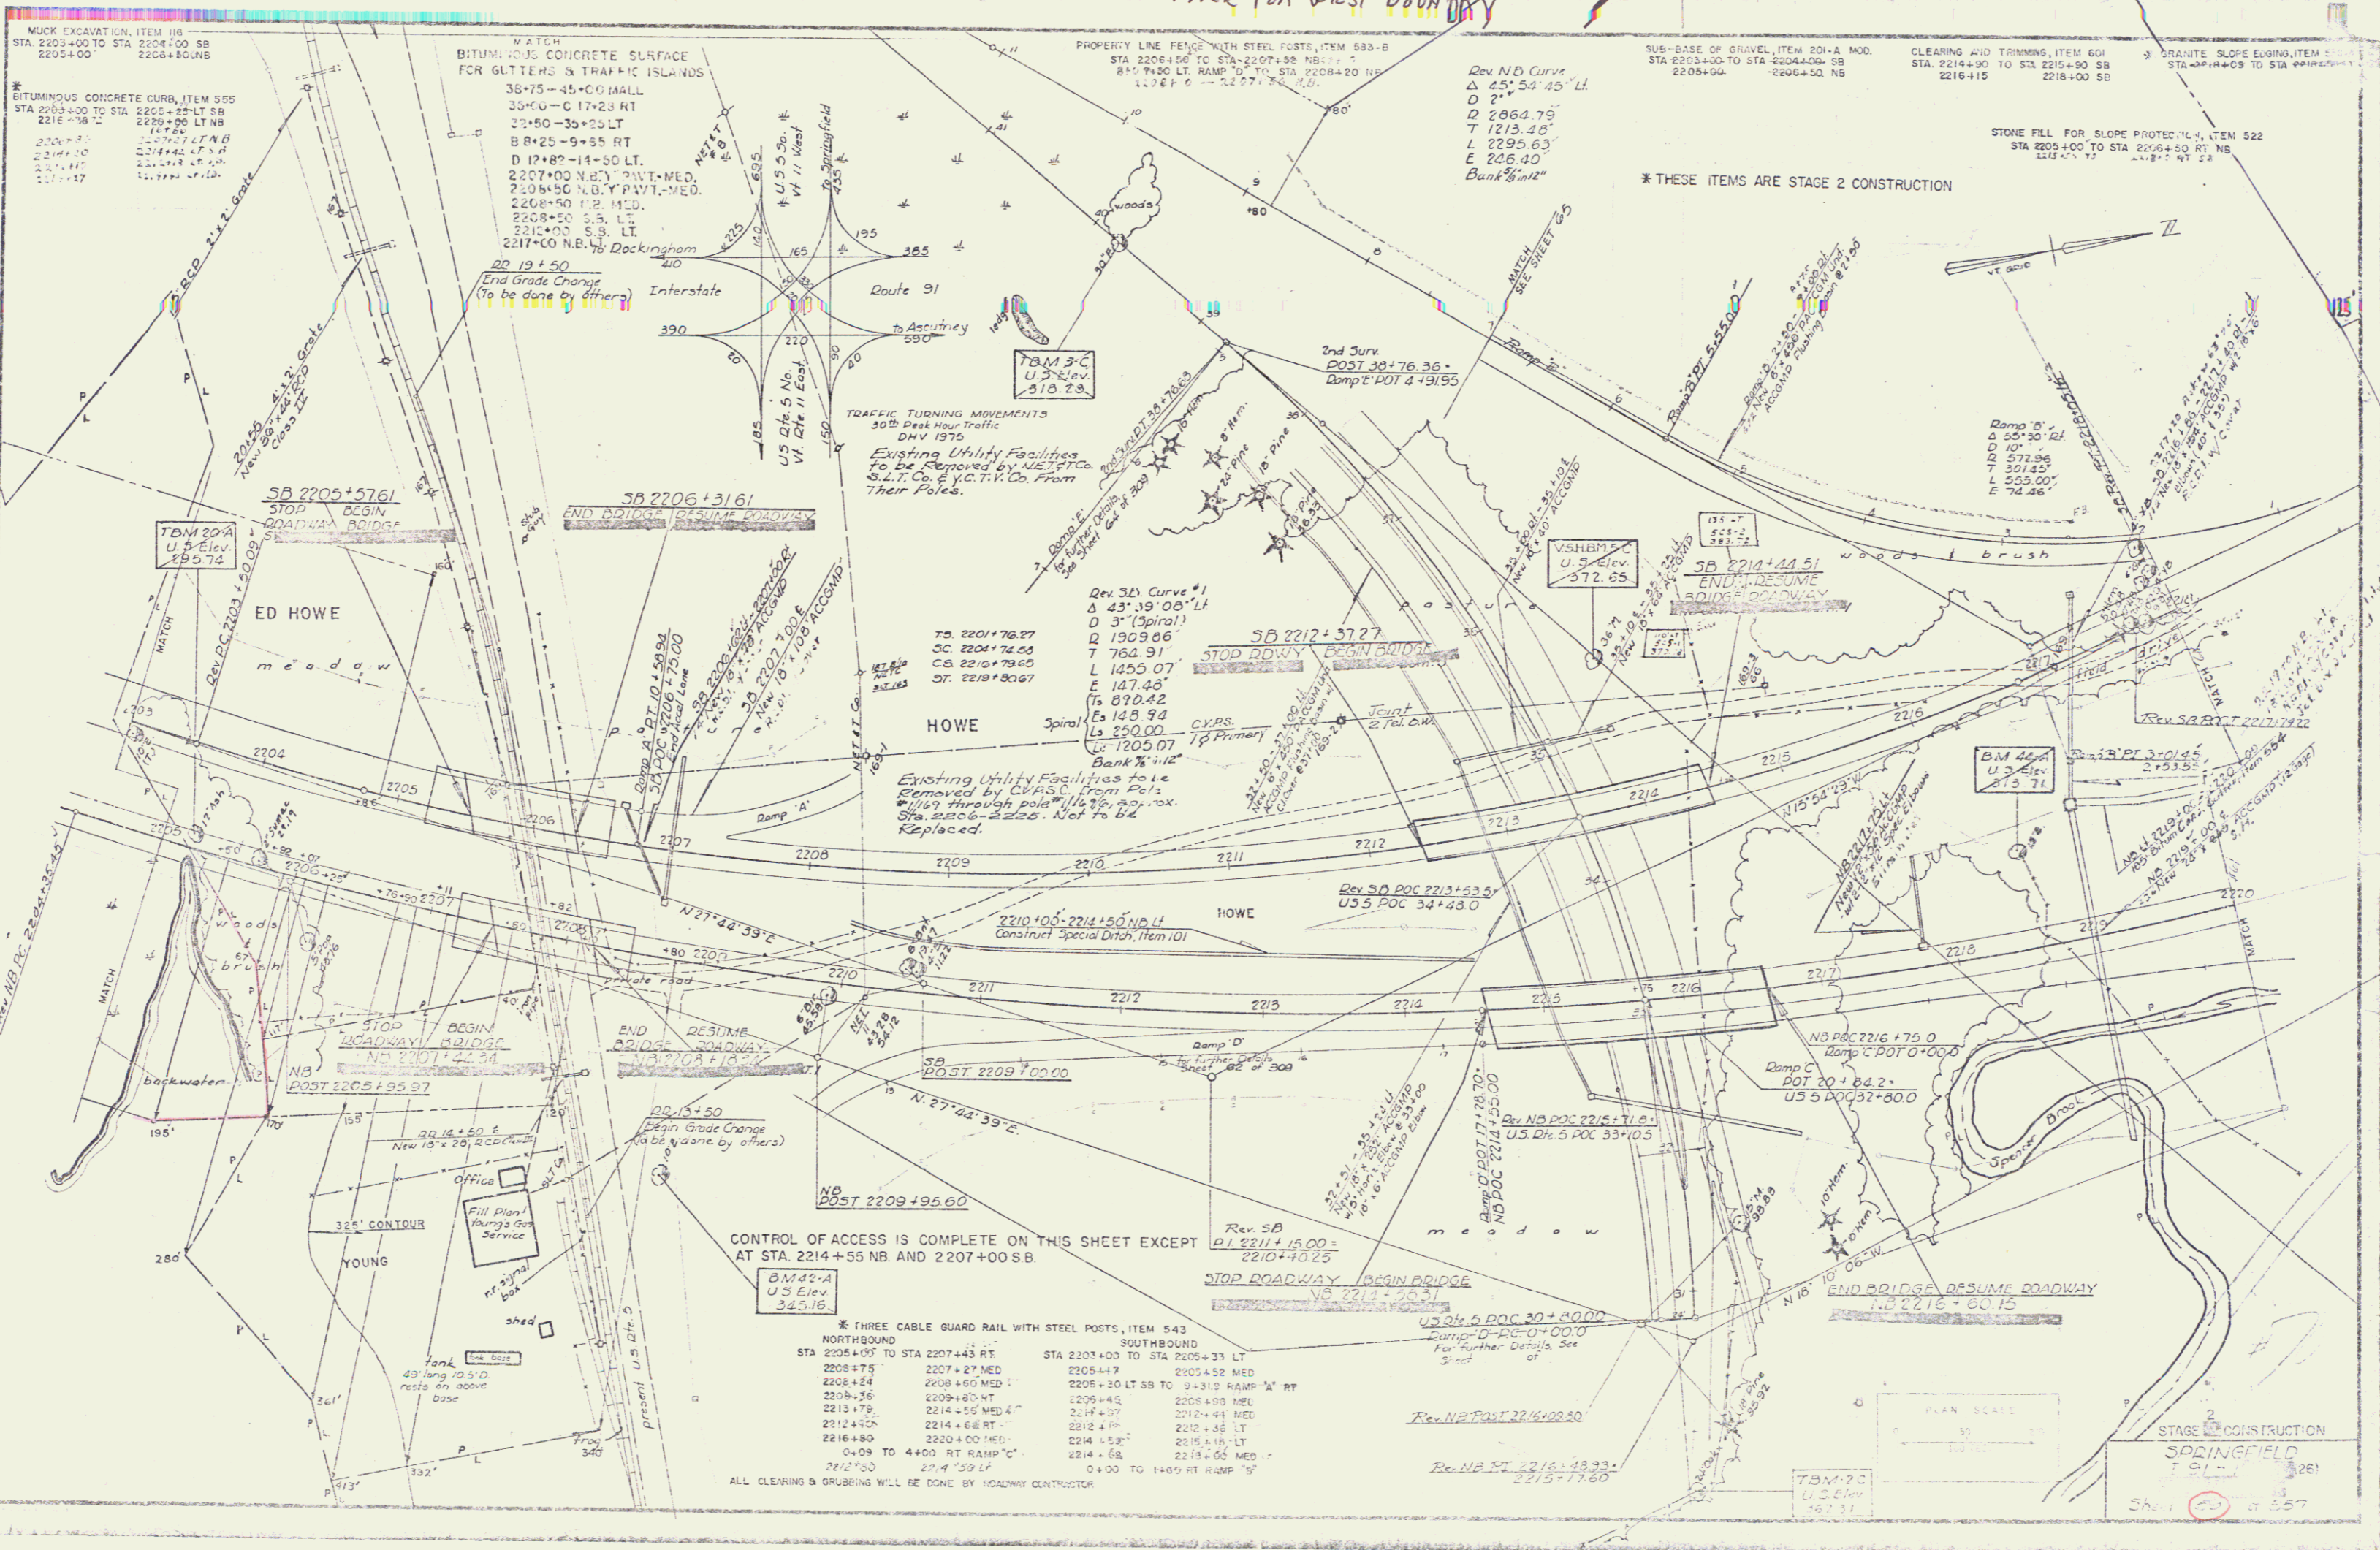

CONTROL OF ACCESS IS COMPLETE ON THIS SHEET EXCEPT AT STA. 2214+55 NB AND 2207+00 SB.

THREE CABLE GUARD RAIL WITH STEEL POSTS, ITEM 543

NORTHBOUND		SOUTHBOUND	
STA 2205+00 TO STA 2207+43 RT	STA 2203+00 TO STA 2205+33 LT	2205+47	2205+52 MED
2208+75	2207+27 MED	2205+30 LT SB TO 3+31.2 RAMP 'A' RT	2205+49 MED
2208+24	2208+60 MED	2205+43	2205+49 MED
2208+56	2209+60 RT	2205+37	2205+44 MED
2213+79	2214+65 MED 4"	2212+47	2212+46 LT
2212+50	2214+68 RT	2214+52	2215+19 LT
2216+80	2220+00 MED	2214+68	2218+05 MED
0+09 TO 4+00 RT RAMP 'C'	0+00 TO 1+00 RT RAMP 'S'		

ALL CLEARING & GRUBBING WILL BE DONE BY ROADWAY CONTRACTOR

STAGE 2 CONSTRUCTION
SPRINGFIELD
SHEET 257