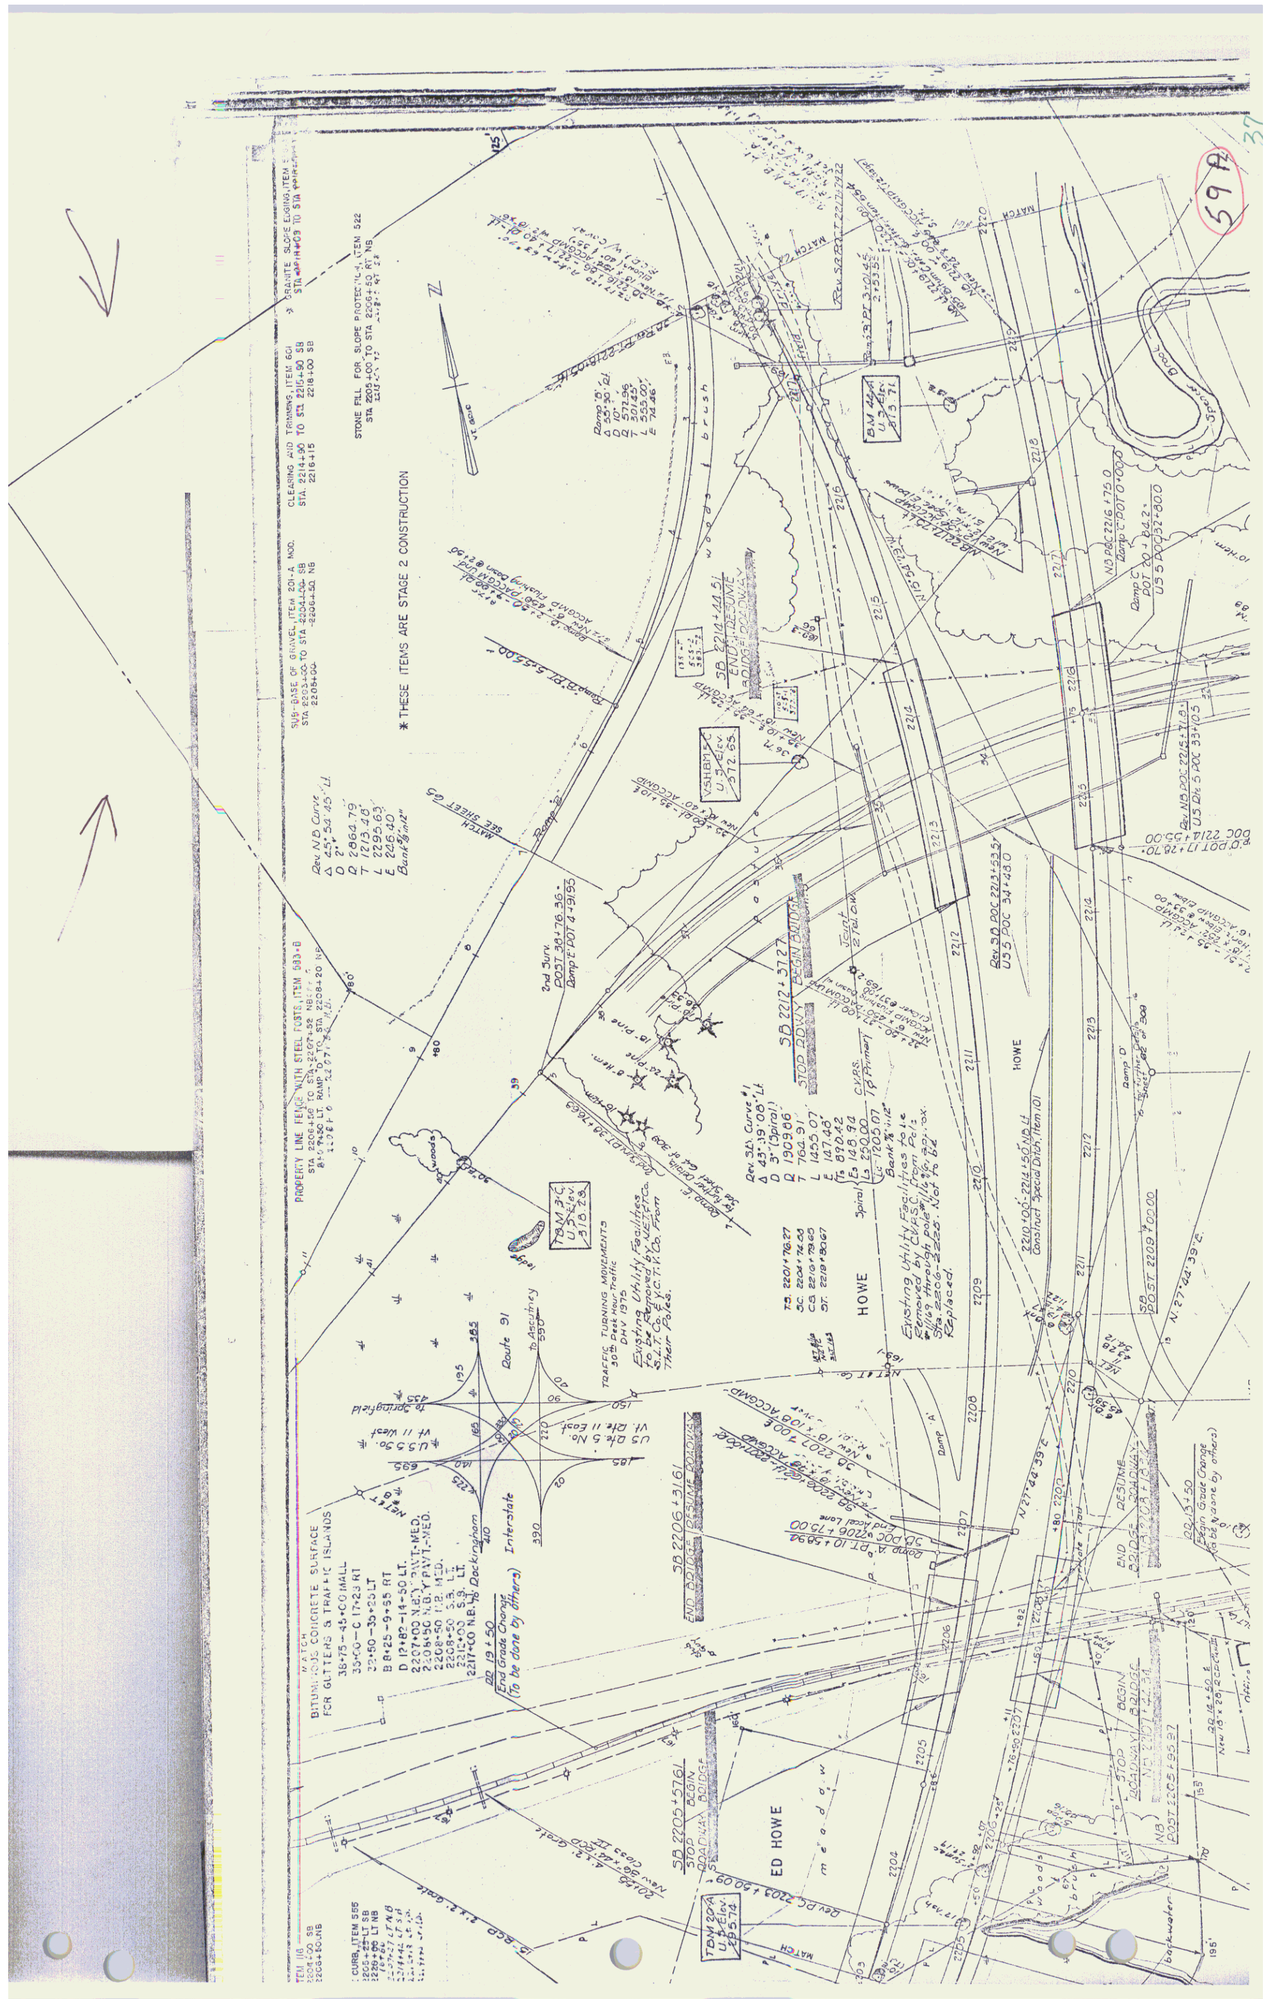
THESE ITEMS ARE STAGE 2 CONSTRUCTION
Interstate
Route 91
ED HOWE
HOWE
Existing Utility Facilities Removed only poles #14 & #20. Sta. 2206-2225. Not to be Replaced.
TRAFFIC TURNING MOVEMENTS
30th Peak Hour Traffic
DHV 1975
Existing Utility Facilities S.L.T. Co. & N.E.T.&T. Co. From Their Poles.
