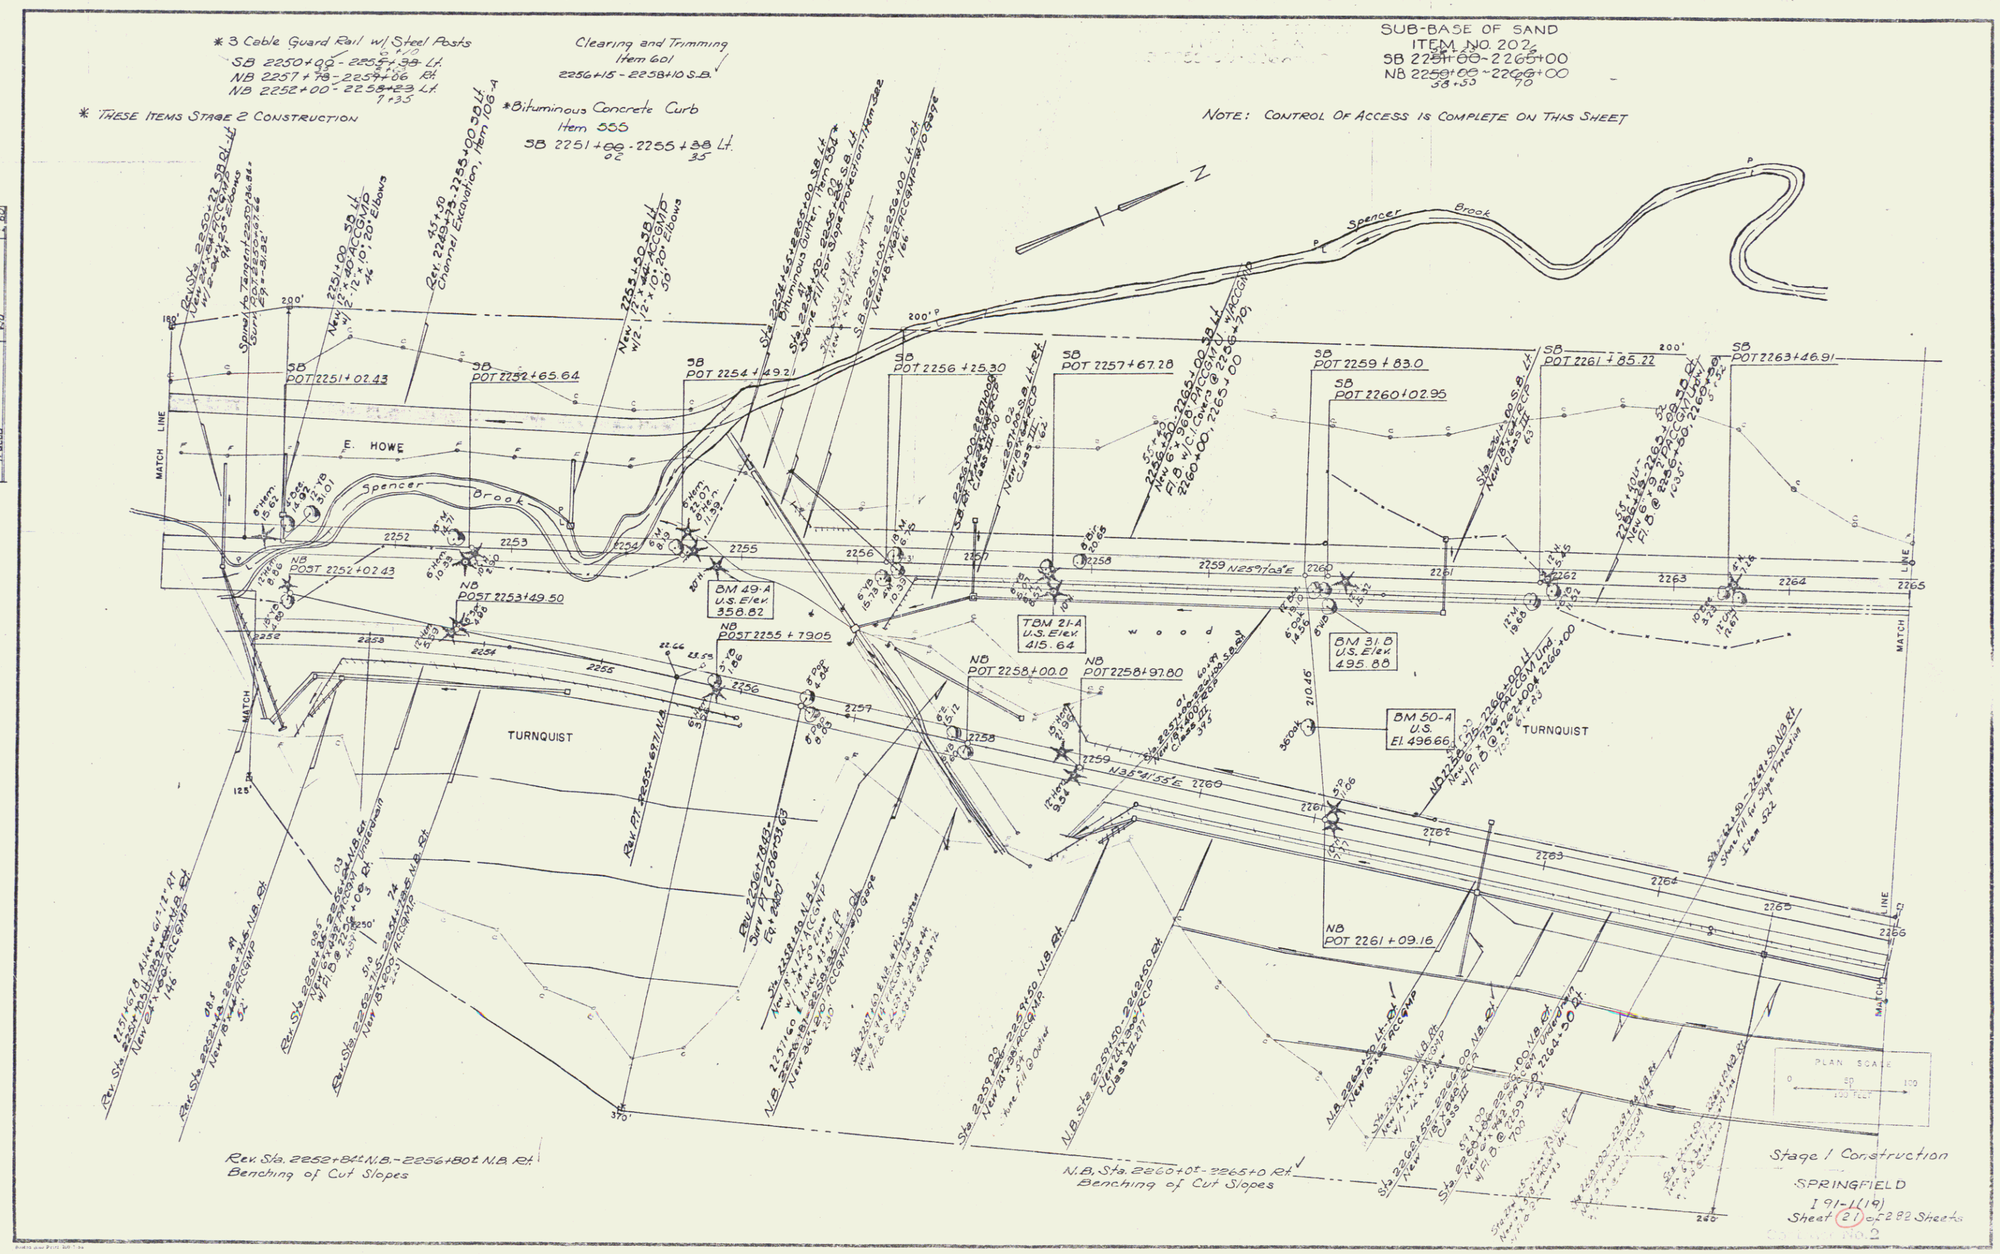

PLAN	BY	DATE
Surveyed		
Plotted	Panaiman	8-60
Traced	Erasec	9-60
	W.D.	2-60

4