STATE OF VERMONT

DEPARTMENT OF HIGHWAYS

PROPOSED IMPROVEMENT

INTERSTATE PROJECT

Interstate Route I 91

TOWNS OF SPRINGFIELD-WEATHERSFIELD

COUNTY OF WINDSOR

Pin# 99R048

PROJECT I 91-1 (20) - CONTRACT NO. 1

BEGINNING AT A POINT 1.027 MILES SOUTHERLY OF THE SPRINGFIELD-WEATHERSFIELD TOWN LINE AND EXTENDING NORTHERLY 3.146 MILES.

LENGTH OF ROADWAY 16,197.51 FEET = 2.93 MILES
LENGTH OF BRIDGES 122.00 FEET = 0.023 MILE
LENGTH OF PROJECT 16,610.33 FEET = 3.146 MILES

DESIGN DESIGNATION

ADT	1973	3145
ADT	1994	10,200
DHV	1994	1156
T		5%
T		8%
V		60 MPH

STAGE 1 CONSTRUCTION

CONTRACTOR S.J. ROSSI CONST. CO. INC.
ROCKY TOP LANE
CHIEF ENGINEER R.C. FOSTER
PROJ. ENGINEER J.J. HANNON
RICHARD PLATT SURGICAL, JR.

COMPLETION DATE APRIL 7, 1994
STARTED NOVEMBER 14, 1994
COST TO DATE $ 10,000,000
ACCEPTED TIME 100 %

STEEL FURNISHED BETHLEHEM STEEL CO. ALBANY, NEW YORK
BRIDGE PAINT MASTER PHONIZE POWDER CO. CHICAGO, ILL.

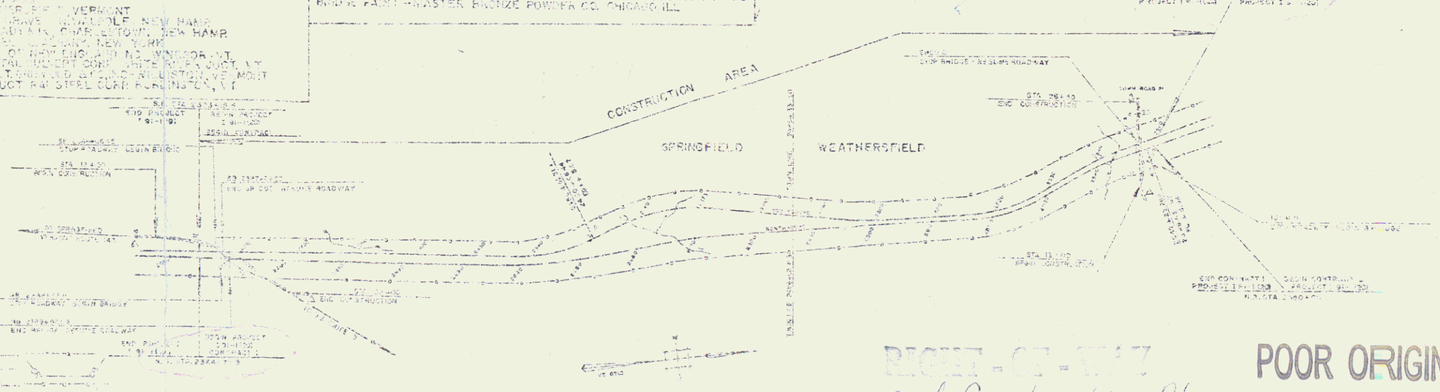

RIGHT-OF-WAY and Construction Plans

POOR ORIGINAL COPY

SCALE IN FEET

MP 44.90-51.74

1 of 211 con

Rt 143 in Springfield to Exit 9 in Hartland

Sta. 322+50