DRILLING and BLASTING of SOLID ROCK, ITEM 113
Rev. SB 2413+50 - 2415+00

DRILLING & BLASTING of SOLID ROCK SUBGRADE, ITEM 113, Mod.
NB 2410+50 - 2417+00
SB 2406+50 - 2415+00

*CONSTRUCT U-TURN
NB 2402+00

PROPERTY LINE FENCE
ITEM 503
Rev. SB 2393+00 - 2414+00 Lt
NB 2401+90 - 2417+00 Rt
Rev. NB 2402+40 - 2403+15 Lt

Note:
Prior to the commencement of construction, construct Property Line Fence with Steel Posts, Item 503-B
SB 2393+00 - 2415+00 Lt
NB 2401+00 - 2417+00 Rt

* BITUMINOUS CONCRETE CURB
ITEM 609.4
NB 2403+50 - 2407+48 Lt
Rev. SB 2398+00 - 2406+88 Lt

* THREE CABLE GUARD RAIL w/STEEL POSTS, ITEM 543
NB 2401+00 - 2409+80 Lt
Rev. SB 2393+00 - 2402+35 Lt
Rev. SB 2393+65 - 2403+65 Rt

* DENOTES STAGE 2 ITEMS.

NOTE: CONTROL OF ACCESS IS COMPLETE ON THIS SHEET.

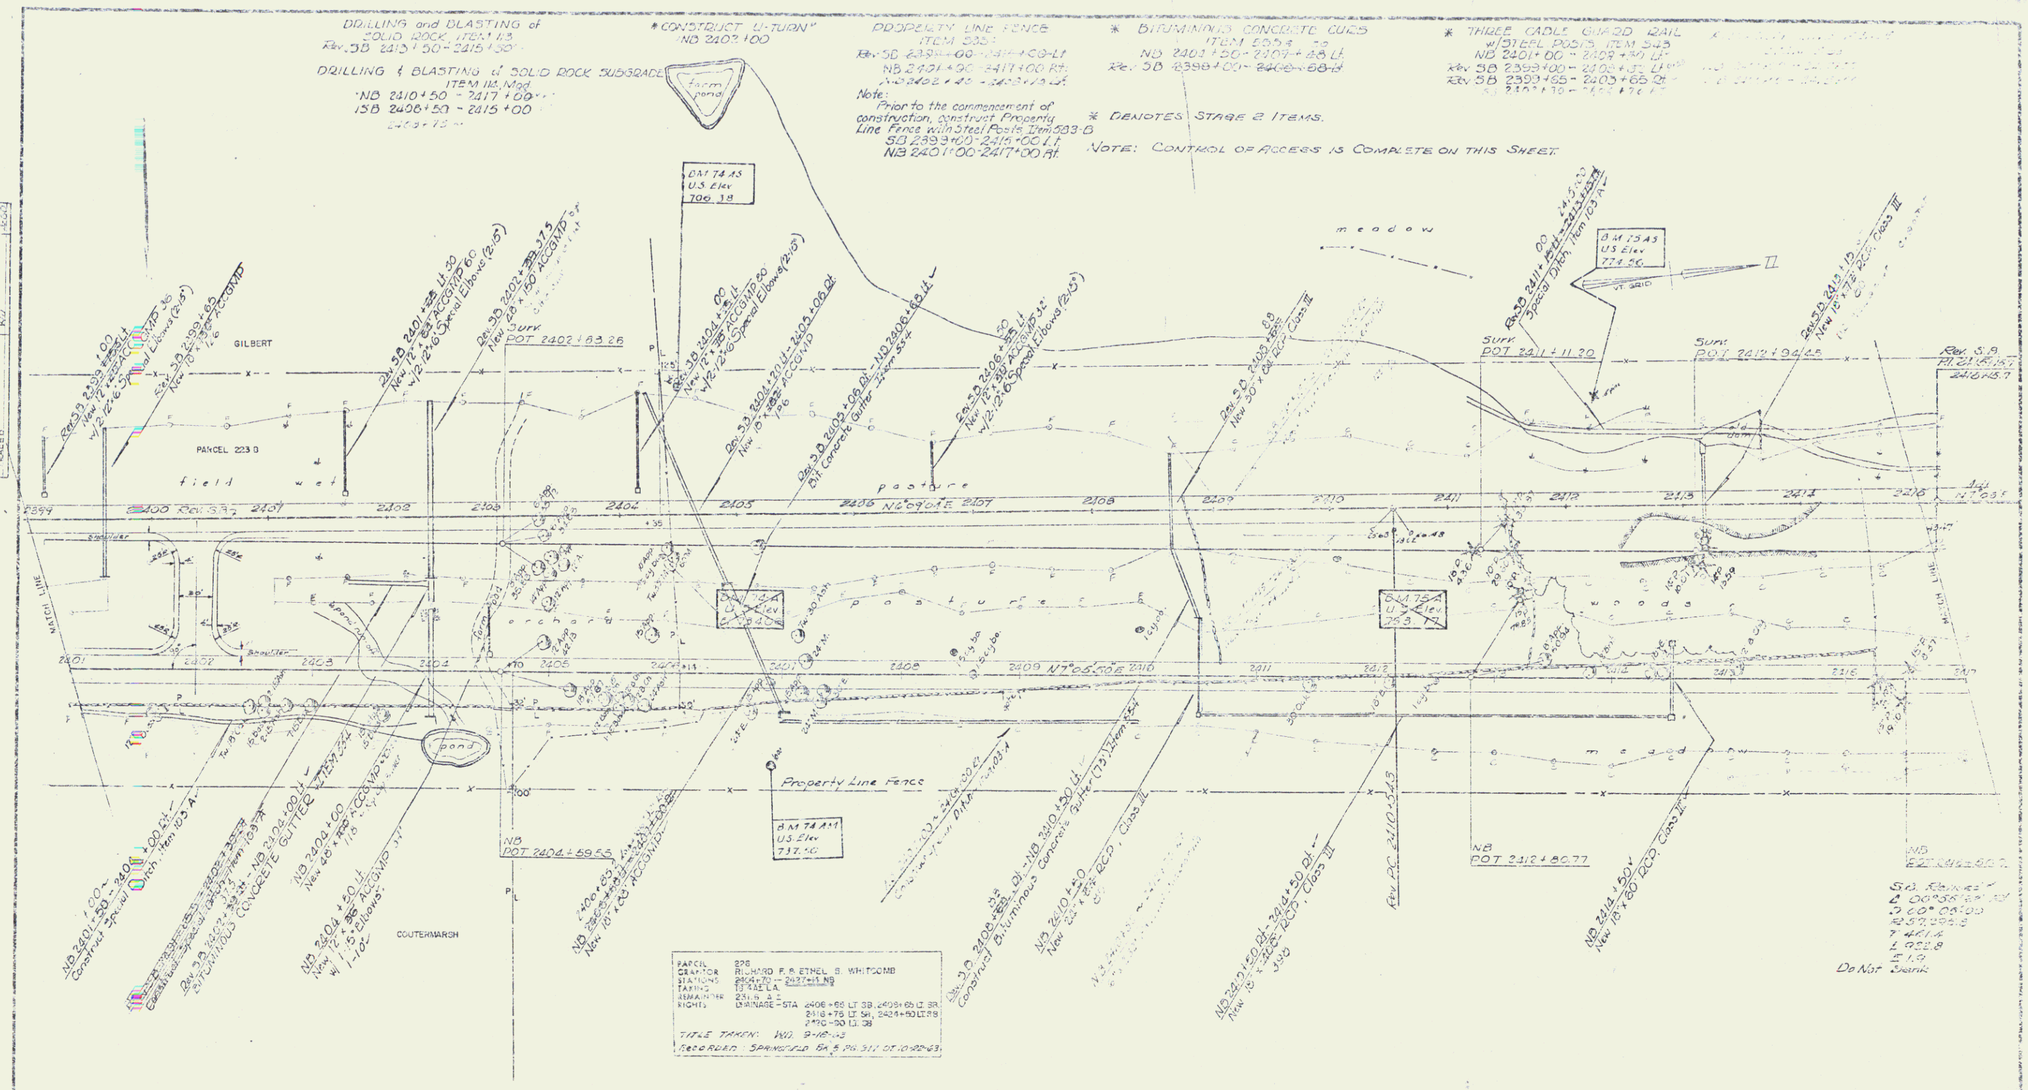

PARCEL	223
GRANTOR	RICHARD F. & ETHEL S. WHITCOMB
STATIONS	2404+70 - 2437+45 NB
TAKING	13.745 L.A.
REMAINDER	231.11 A.E.
RIGHTS	DRAINAGE - STA 2406+88 LT SB, 2408+65 LT SR, 2416+75 LT SR, 2424+50 LT RB, 2430+30 LT SB

TITLE TAKEN: W.D. 9-16-63
RECORDED: SPRINGFIELD BK 8 PG 317 DT. 10-22-63

Stage I Construction

SPRINGFIELD - WEATHERSFIELD
Project I No. 91-1 (28)
Sheet 22 of 24

Con-

3