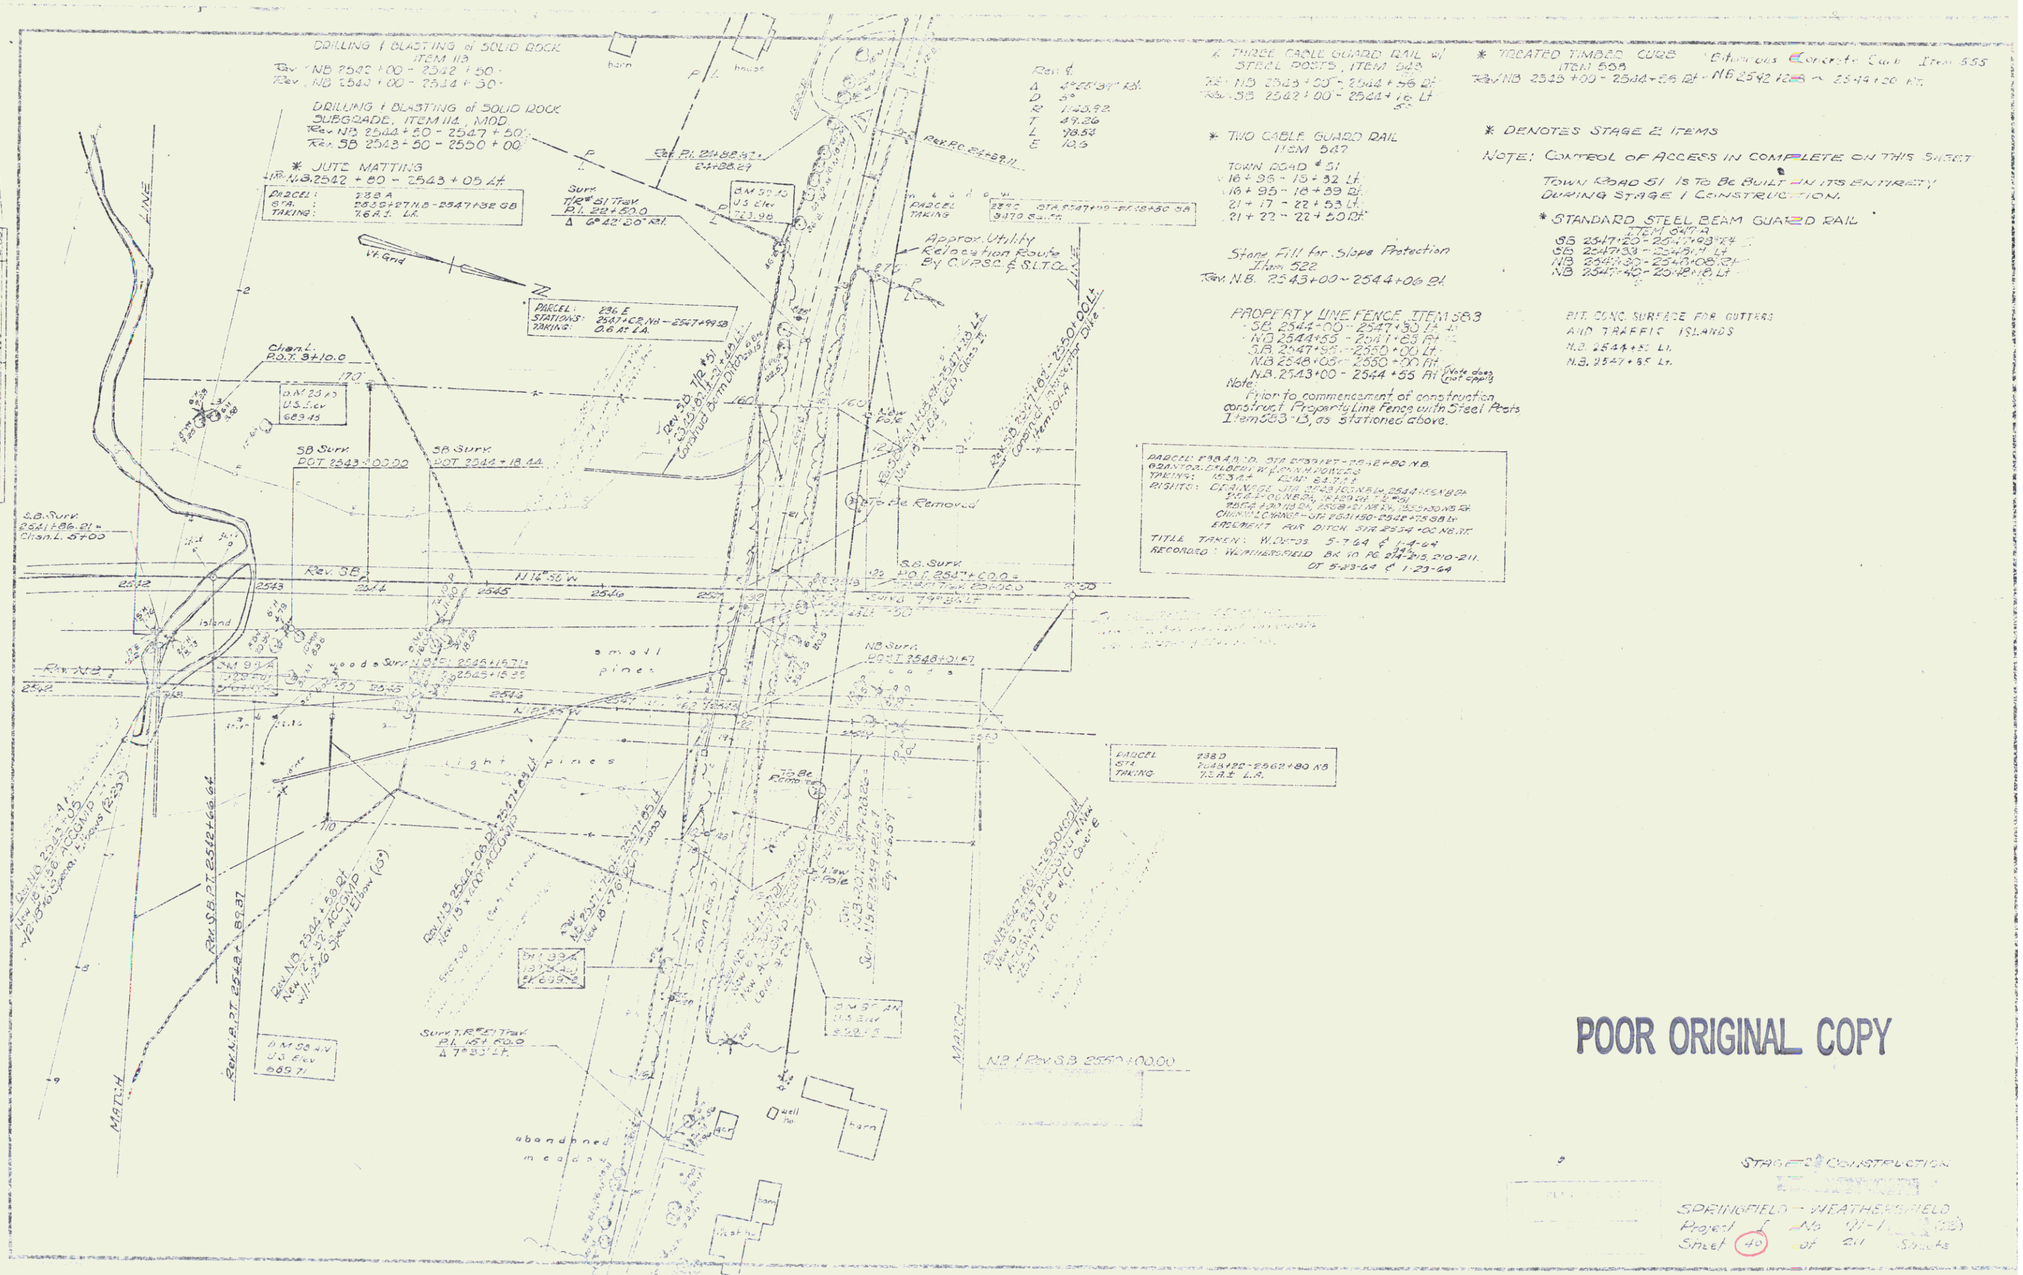
DRILLING & BLASTING of SOLID ROCK
ITEM 113
Rev. NB 2542 + 00 - 2542 + 50
Rev. NB 2544 + 00 - 2544 + 50
DRILLING & BLASTING of SOLID ROCK
SUBGRADE, ITEM 113 MOD.
Rev. NB 2544 + 50 - 2547 + 50
Rev. SB 2543 + 50 - 2550 + 00
* JUTE MATTING
NB 2542 + 50 - 2543 + 05 Lt.
PARCEL: 238 A
STA.: 2543+27 N.B. - 2547+32 SB
TAKING: 7.6 A.± L.A.
Rev. Rt
Δ 4°22'39" Rt.
D 5°
R 1143.92
T 49.26
L 98.54
E 1.06
* THREE CABLE GUARD RAIL w/ STEEL POSTS, ITEM 543
Rev. NB 2543 + 00 - 2544 + 56 Rt.
Rev. SB 2542 + 00 - 2544 + 16 Lt.
* TREATED TIMBER CURB ITEM 599
Rev. NB 2543 + 00 - 2544 + 56 Rt. - NB 2542 + 28 - 2544 + 20 Lt.
* TWO CABLE GUARD RAIL ITEM 543
TOWN ROAD # 51
16 + 96 - 15 + 32 Lt.
16 + 96 - 16 + 39 Rt.
21 + 17 - 22 + 63 Lt.
21 + 22 - 22 + 20 Rt.
* DENOTES STAGE 2 ITEMS
NOTE: CONTROL OF ACCESS IN COMPLETE ON THIS SHEET
TOWN ROAD 51 IS TO BE BUILT IN ITS ENTIRETY DURING STAGE 1 CONSTRUCTION.
* STANDARD STEEL BEAM GUARD RAIL ITEM 614.2
SB 2547+20 - 2547+63 Rt.
SB 2547+33 - 2547+91 Lt.
NB 2544+30 - 2544+08 Rt.
NB 2547+40 - 2547+18 Lt.
Stone Fill for Slope Protection
Item 522
Rev. N.B. 2543+00 - 2544+06 Rt.
PROPERTY LINE FENCE, ITEM 883
SB 2544+00 - 2547+30 Lt.
NB 2544+55 - 2547+25 Rt.
SB 2547+96 - 2550+00 Lt.
NB 2548+05 - 2550+00 Rt.
N.B. 2543+00 - 2544+55 Rt. (Note does not apply)
Note: Prior to commencement of construction construct Property Line Fence with Steel Posts Item 883-13, as stationed above.
BIT. CONC. SURFACE FOR GUTTERS AND TRAFFIC ISLANDS
N.B. 2544+55 Lt.
N.B. 2547+55 Lt.
Approx. Utility Relocation Route By C.V.P.S.C. & S.L.T.C.
Rev. SB 2550+00.00
Rev. NB 2550+00.00
Rev. N3 / Rev. SB 2550+00.00
Rev. SB 2543+00.00
Rev. NB 2543+00.00
Rev. N3
Rev. SB
Rev. NB
Island
small pines
light pines
abandoned meadow
barn
house
well
MATCH LINE
POOR ORIGINAL COPY
STAGE 2 CONSTRUCTION
SPRINGFIELD - WEATHERSFIELD
Project F-NG 91-1
Sheet 40 of 211 Sheets

12