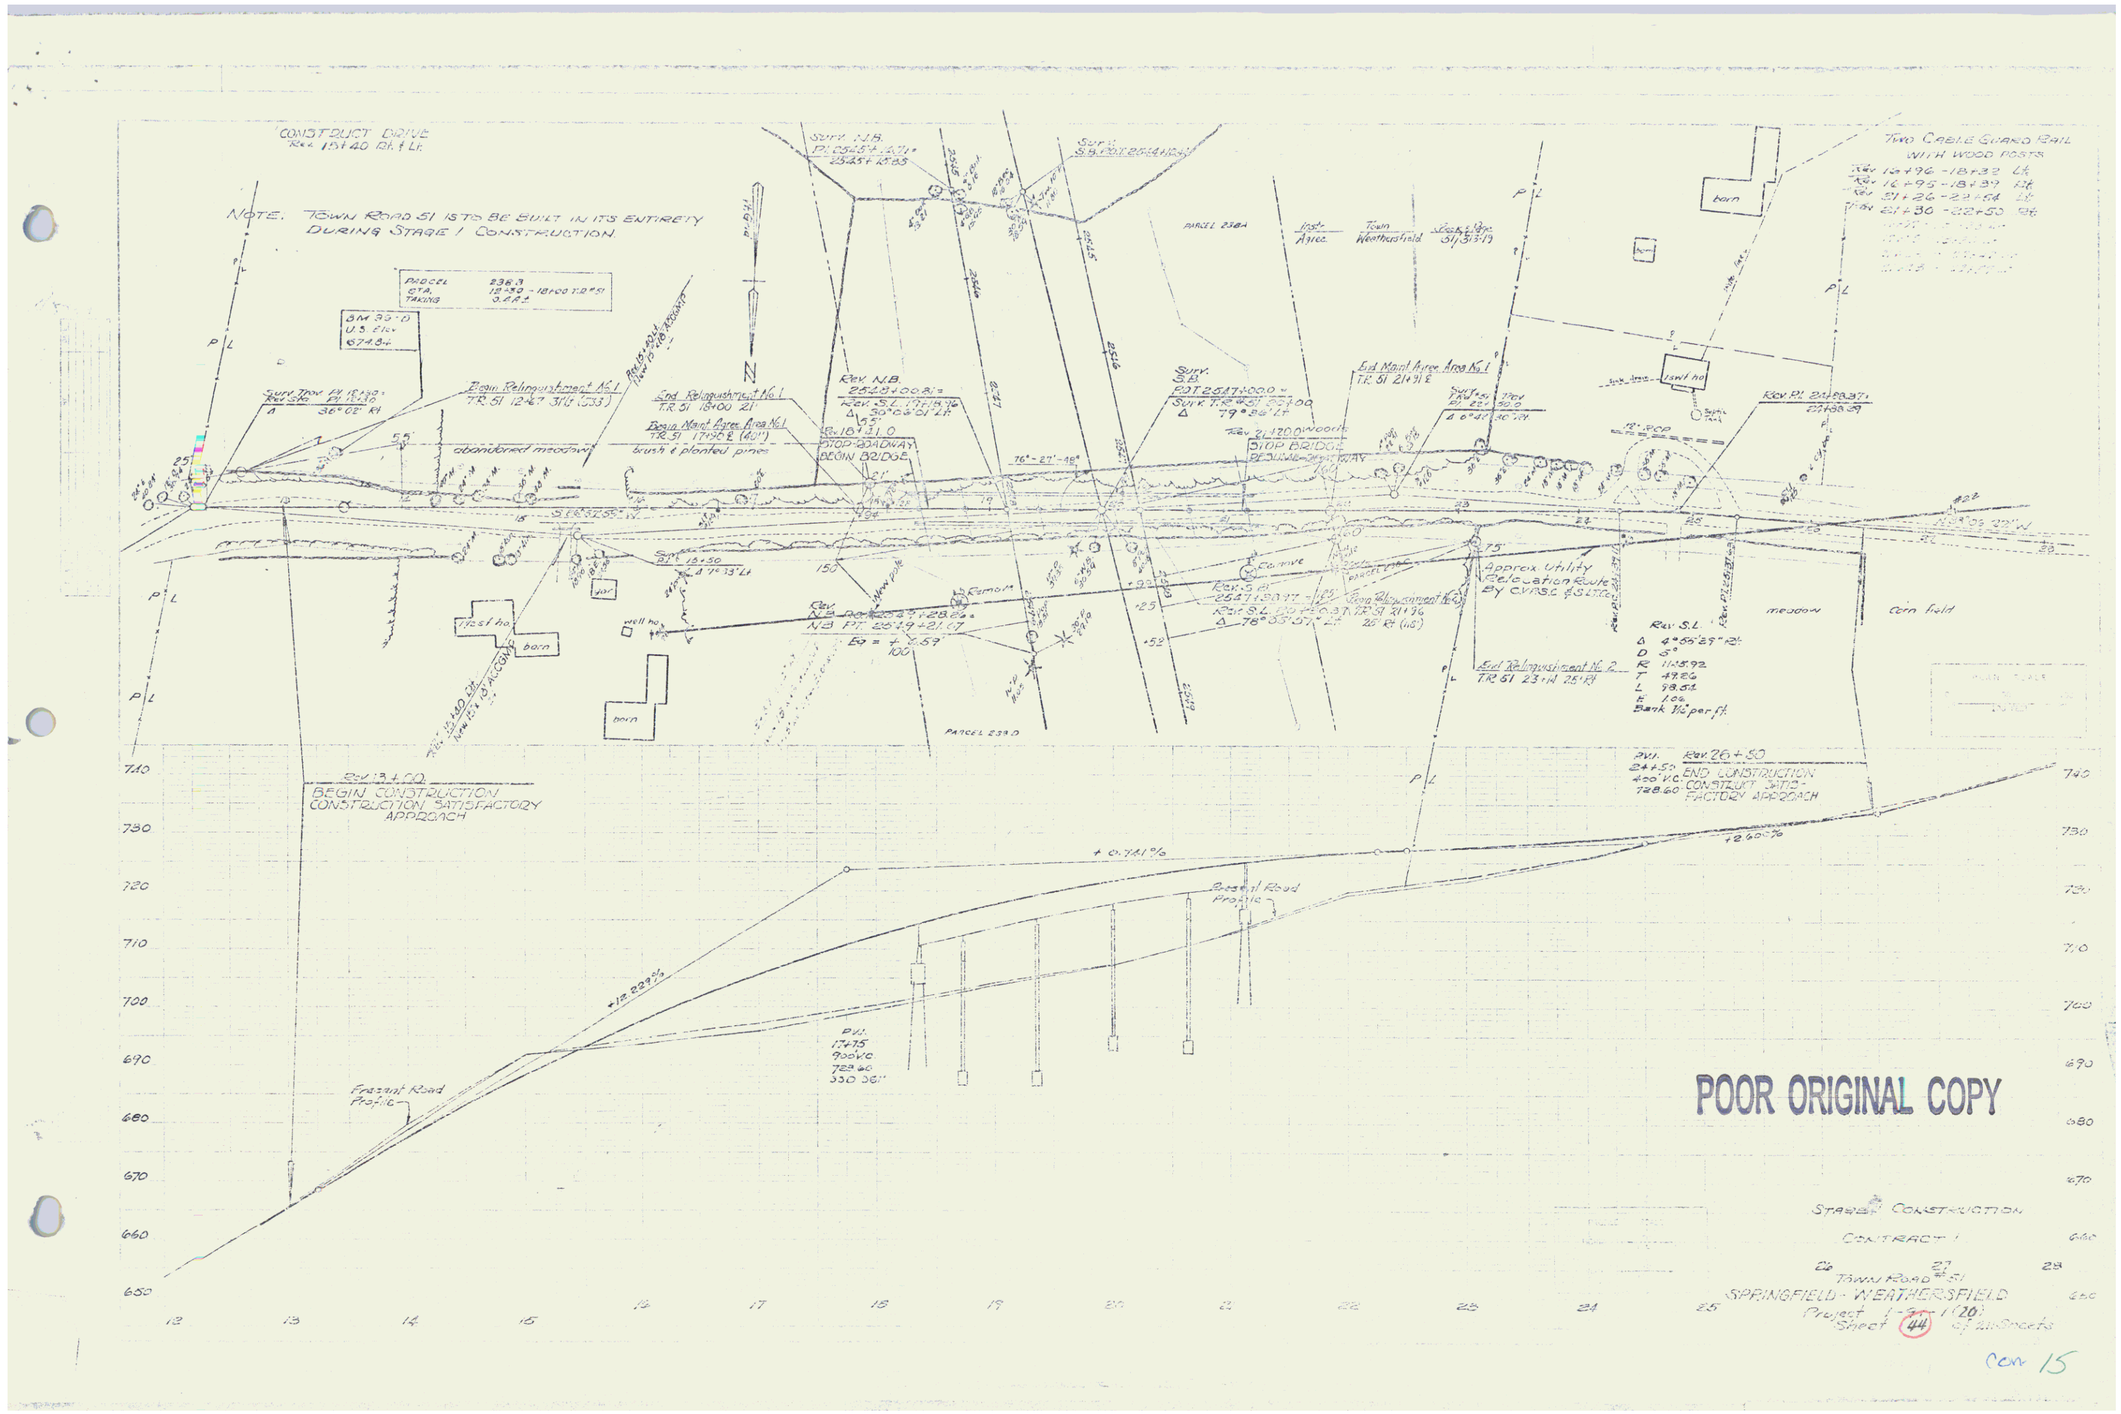

POOR ORIGINAL COPY

STAGE CONSTRUCTION
CONTRACT 1
TOWN ROAD #51
SPRINGFIELD - WEATHERSFIELD
Project I-77-1(20)
Sheet 44 of 111 Sheets

Con 15