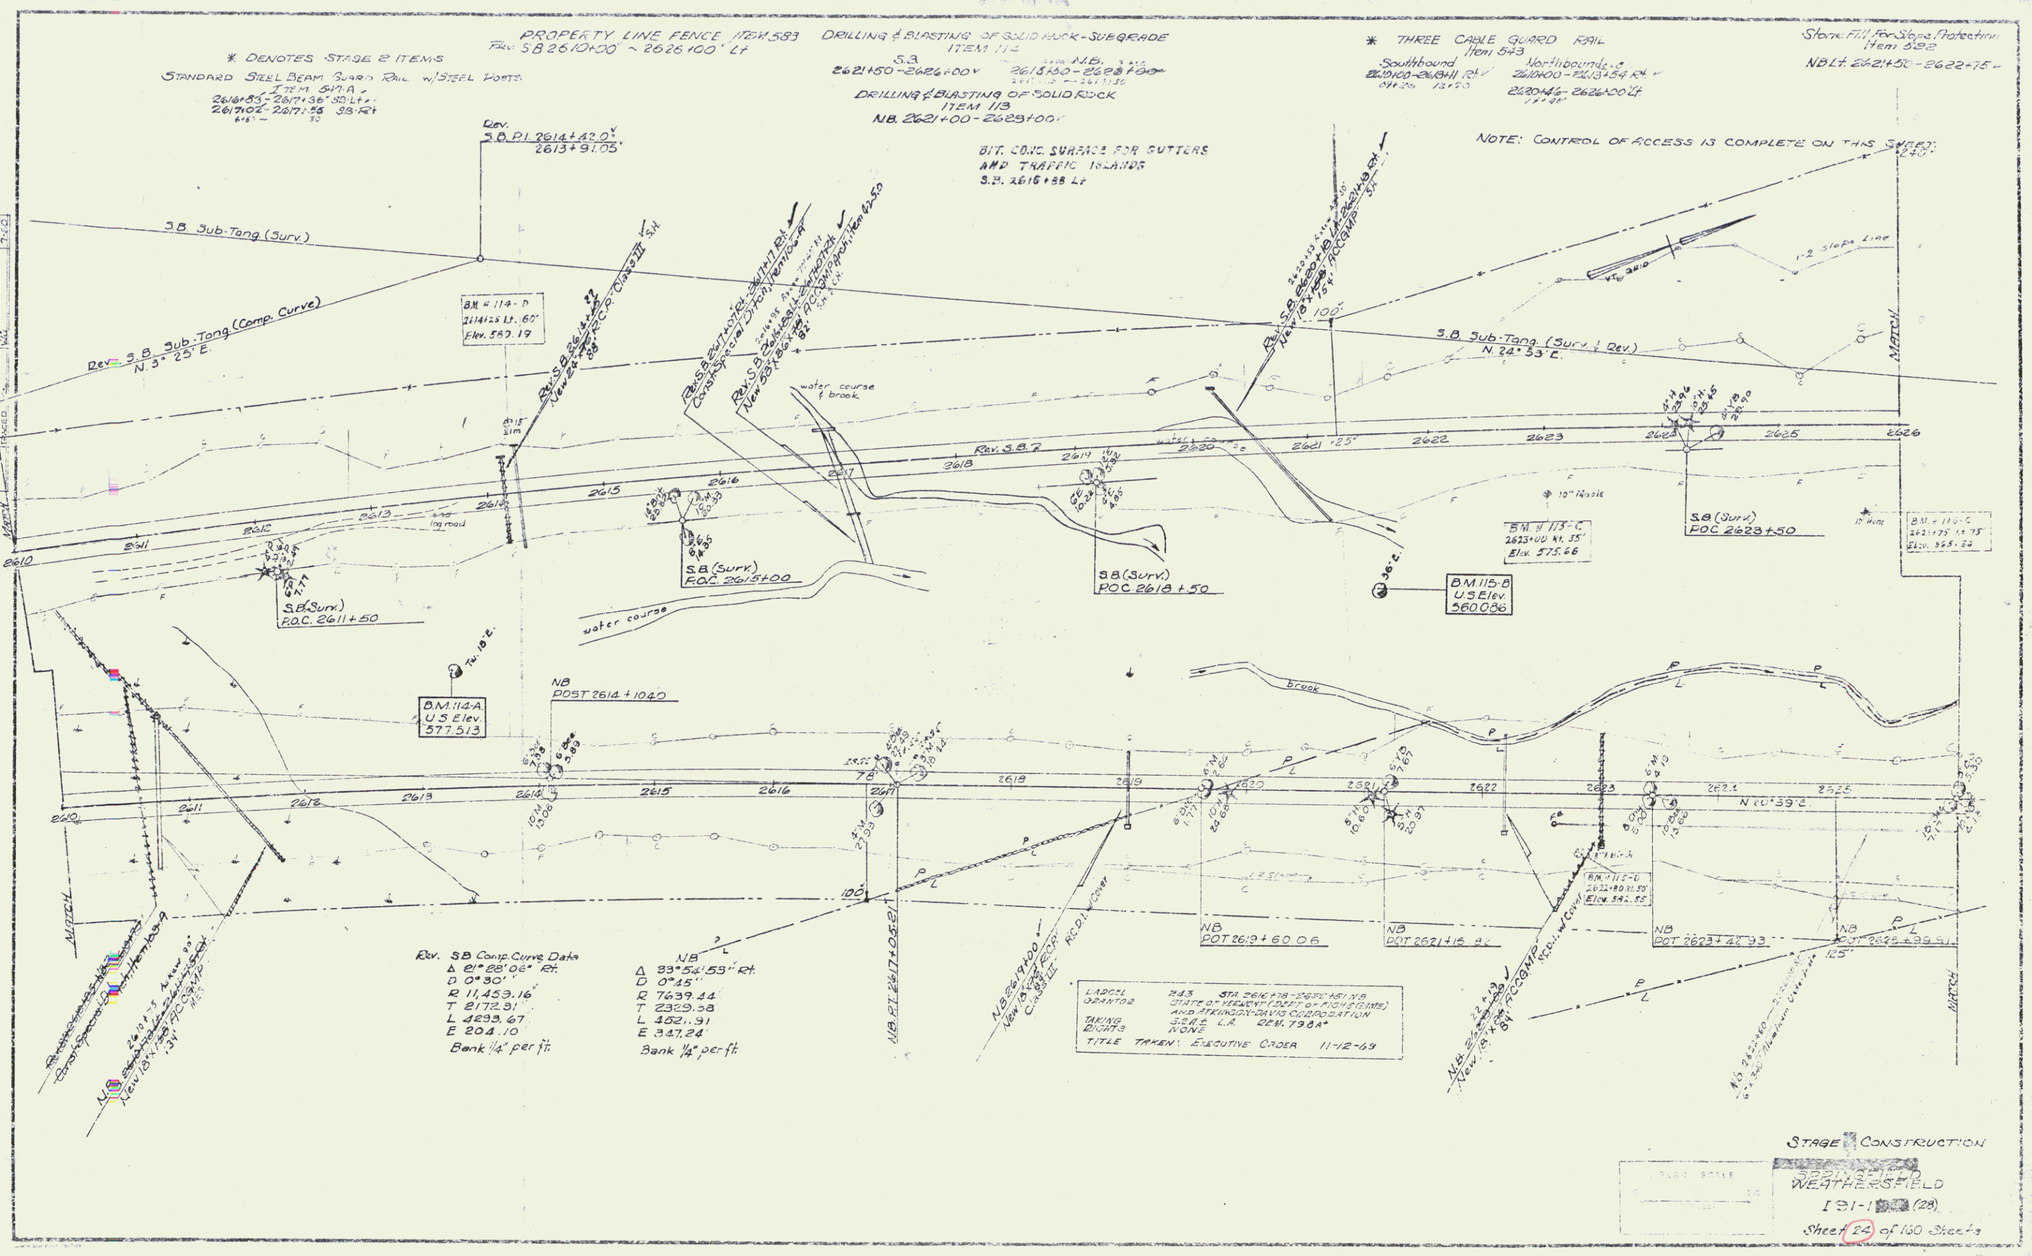
* DENOTES STAGE 2 ITEMS
STANDARD STEEL BEAM GUARD RAIL w/STEEL POSTS
ITEM 541-A
PROPERTY LINE FENCE ITEM 583
Rev. SB 2610+00 ~ 2626+00' Lt
DRILLING & BLASTING OF SOLID ROCK-SUBGRADE
ITEM 112
S.B. 2621+50 - 2626+00
DRILLING & BLASTING OF SOLID ROCK
ITEM 113
N.B. 2621+00 - 2629+00
BIT. CONC. SURFACE FOR GUTTERS AND TRAFFIC ISLANDS
S.B. 2616+88 Lt
* THREE CABLE GUARD RAIL
Item 543
Southbound
Northbound
Stone Fill for Slope Protection
Item 612
NB Lt. 2621+50 - 2622+75
NOTE: CONTROL OF ACCESS IS COMPLETE ON THIS SHEET
S.B. Sub-Tang (Surv.)
S.B. Sub-Tang (Comp. Curve)
N 3° 25' E
S.B. Sub-Tang (Surv. & Rev.)
N 24° 33' E
Rev. S.B.T.
water course & brook
S.B. (Surv.) P.O.C. 2611+50
S.B. (Surv.) P.O.C. 2615+00
S.B. (Surv.) POC 2618+50
S.B. (Surv.) POC 2623+50
BM 113-C
2623+00 Rt. 35'
Elev. 575.66
BM 115-B
U.S. Elev.
560.036
BM 114-A
U.S. Elev.
577.513
BM 114-D
2614+25 Lt. 60'
Elev. 587.19
NB POST 2614+10 40
NB POST 2619+60 O.G.
NB POST 2621+15 B.V.
NB POST 2623+42.33
NB POST 2625+99.41
N 60° 39' E
Brook
Rev. SB Comp. Curve Data
Δ 21° 28' 06" Rt.
D 0° 30'
R 11,459.16'
T 2172.31'
L 4298.67'
E 204.10'
Bank 1/4" per ft.
NB
Δ 33° 54' 53" Rt.
D 0° 45'
R 7639.44'
T 2329.38'
L 4521.91'
E 347.24'
Bank 1/4" per ft.
LAPCH 243 STA. 2616+78 - 2625+51 N.B.
5244702 STATE OF VERMONT (DEPT. OF FISH & GAME) AND ATKINSON-DAVIS CORPORATION
TAKING RIGHTS SCALE L.A. DEM. 796A*
NONE
TITLE TAKEN: EXECUTIVE ORDER 11-12-69
STAGE 1 CONSTRUCTION
WEATHERSFIELD
I 91-1 (28)
Sheet 24 of 160 Sheets

21