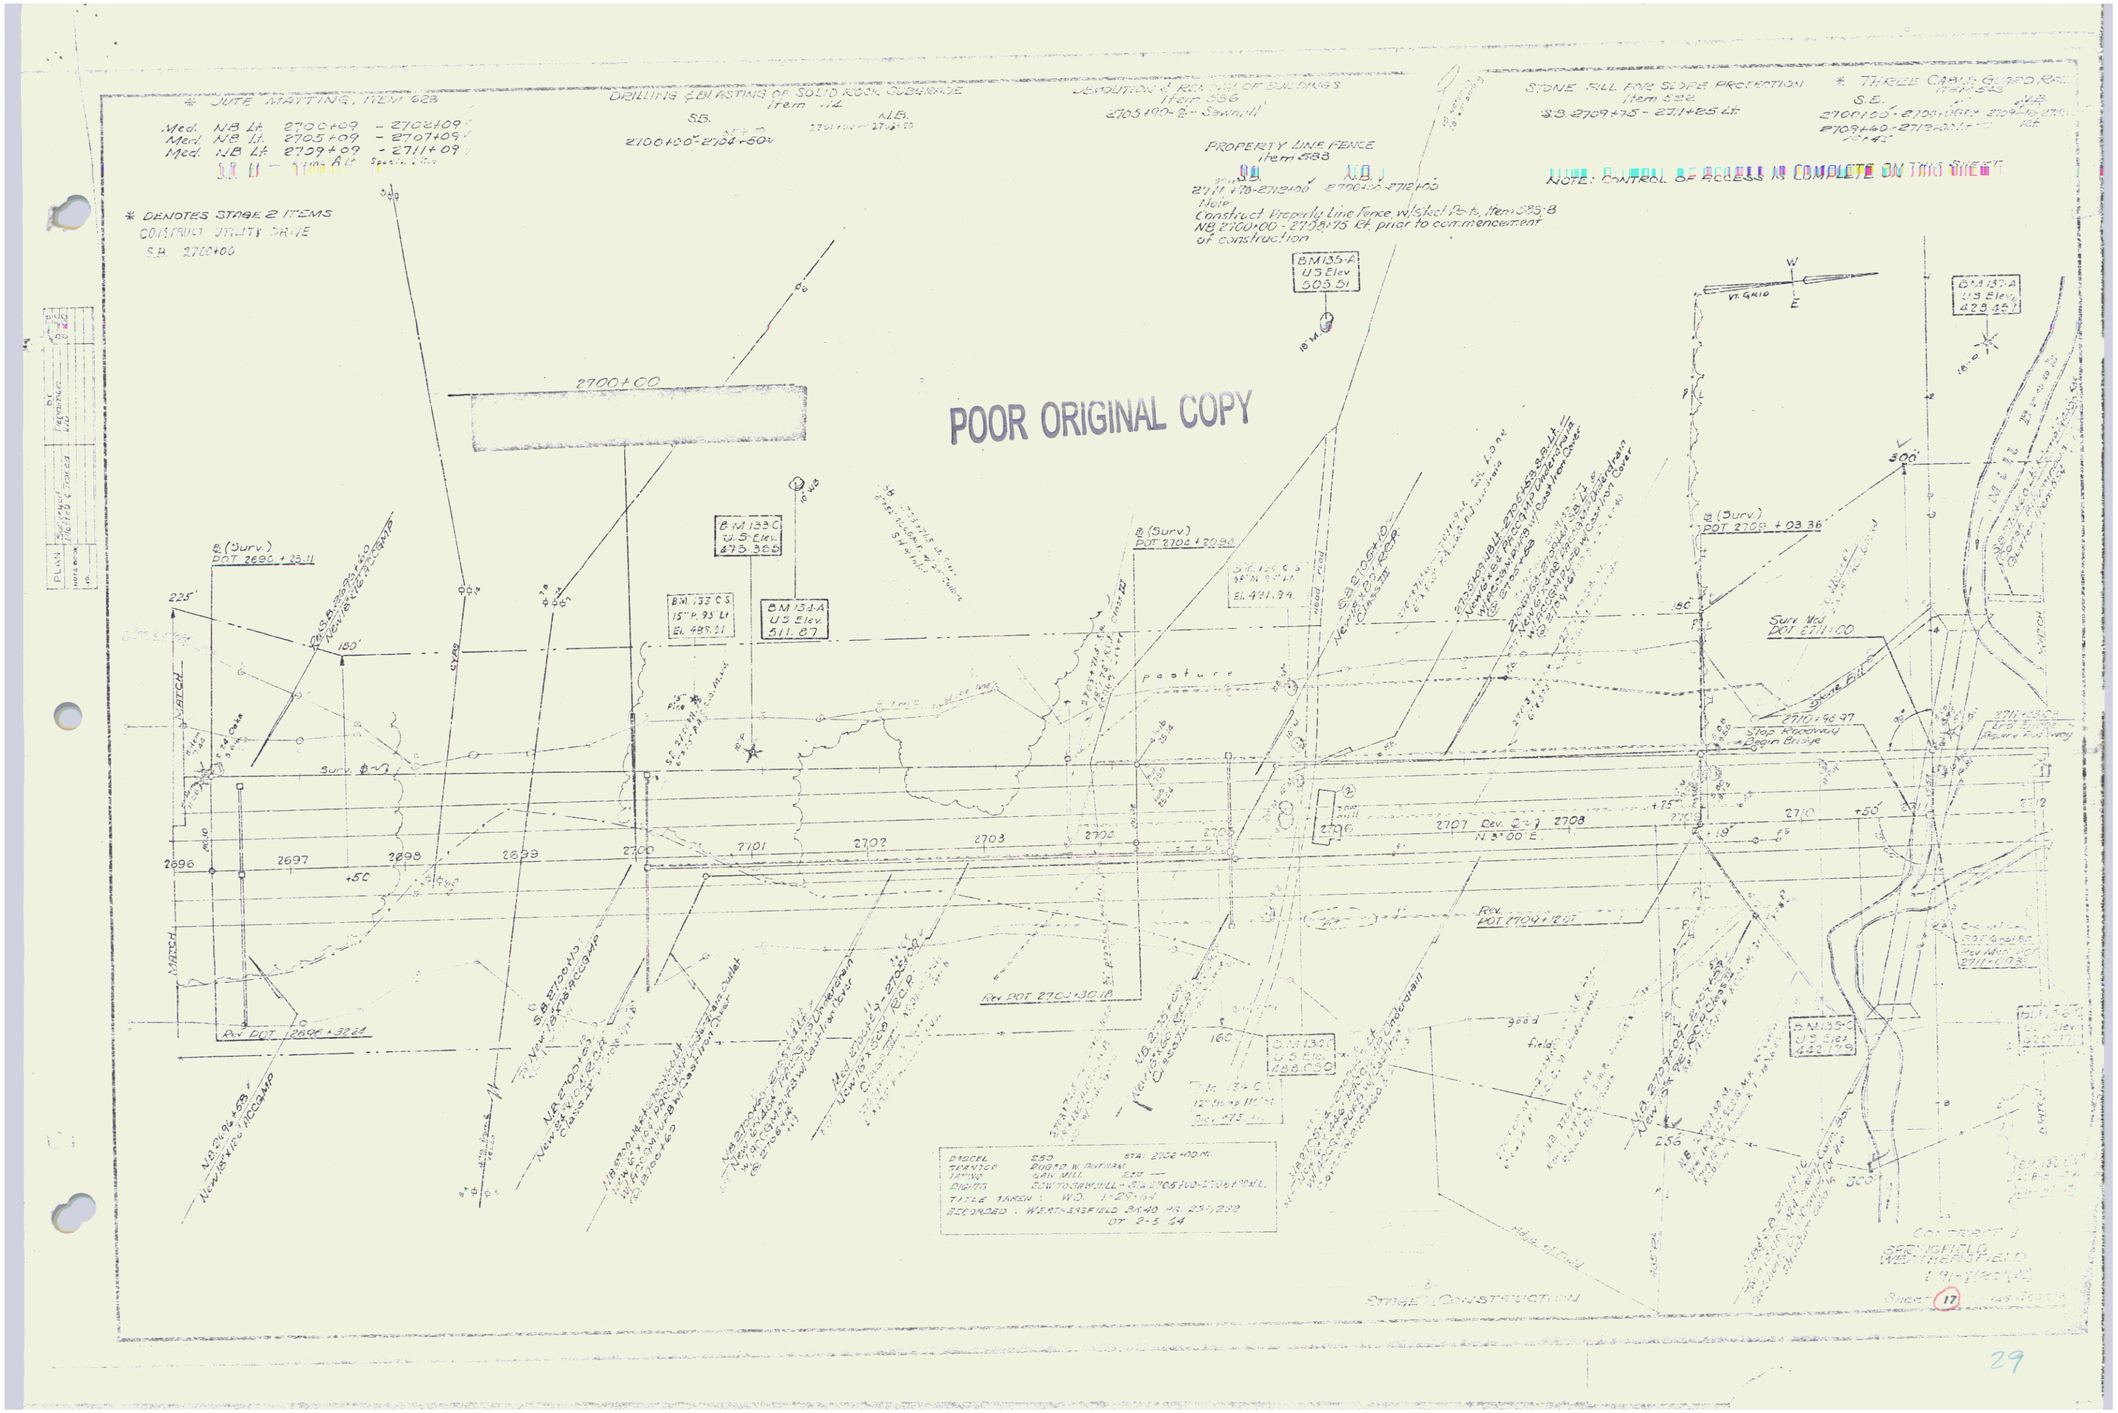
* JUTE MATTING, ITEM 628
Med. NB Lt 2700+09 - 2702+09
Med. NB Lt. 2705+09 - 2707+09
Med. NB Lt 2709+09 - 2711+09
* DENOTES STAGE 2 ITEMS
CONSTRUCT UTILITY DRIVE
S.B. 2700+00
DRILLING & BLASTING OF SOLID ROCK SUBGRADE
Item 112
S.B.
2100+00 - 2104+60
N.B.
DEMOLITION & REMOVAL OF BUILDINGS
Item 586
2705+00 - Rt - Sawmill
PROPERTY LINE FENCE
Item 588
S.B.
2711+70 - 2712+00
N.B.
2700+00 - 2716+00
Note
Construct Property Line Fence w/Select Posts, Item 588.8
NB 2700+00 - 2708+75 Rt prior to commencement of construction
STONE FILL FOR SLOPE PROTECTION
Item 592
S.B. 2709+75 - 2711+25 Lt
* THREE CABLE GUARD RAIL
Item 630
S.B.
2700+25 - 2703+00 Lt
2709+60 - 2712+00 Lt
NOTE: CONTROL OF ACCESS IS COMPLETE ON THIS SHEET
2700+00
POOR ORIGINAL COPY
BM 135-A
U.S. Elev
305.51
BM 133-C
U.S. Elev.
475.368
BM 133 C.S.
15" P. 95 Lt
El. 485.21
BM 134-A
U.S. Elev
511.87
BM 135-A
U.S. Elev
428.46
B (Surv.)
POT 2690 + 35.11
B (Surv.)
POT 2702 + 20.90
B (Surv.)
POT 2709 + 03.36
Surv. Mod.
POT 2711+00
Stop Roadway
Begin Bridge
Rev. POT 2696 + 32.64
Rev. POT 2702 + 30.18
Rev. POT 2709 + 18.01
2696
2697
2698
2699
2700
2701
2702
2703
2704
2705
2706
2707
2708
2709
2710
2711
2712
2707 Rev. 2+1
N 3° 00' E.
pasture
field
Stage 1 Construction
PARCEL 250
OWNER ROGER W. DUTHAM
TAKING SAW MILL
DATE —
DATA SCW TO SAW MILL - Sta. 2705+00 - 2706+00 L.
TITLE TAKEN: W.O. 1-20-54
RECORDED: WEATHERSFIELD BK 40 PG. 251/232
OCT 2-5-54
STA: 2706+00 Rt.
Contract 7
WEATHERSFIELD
Sheet 17