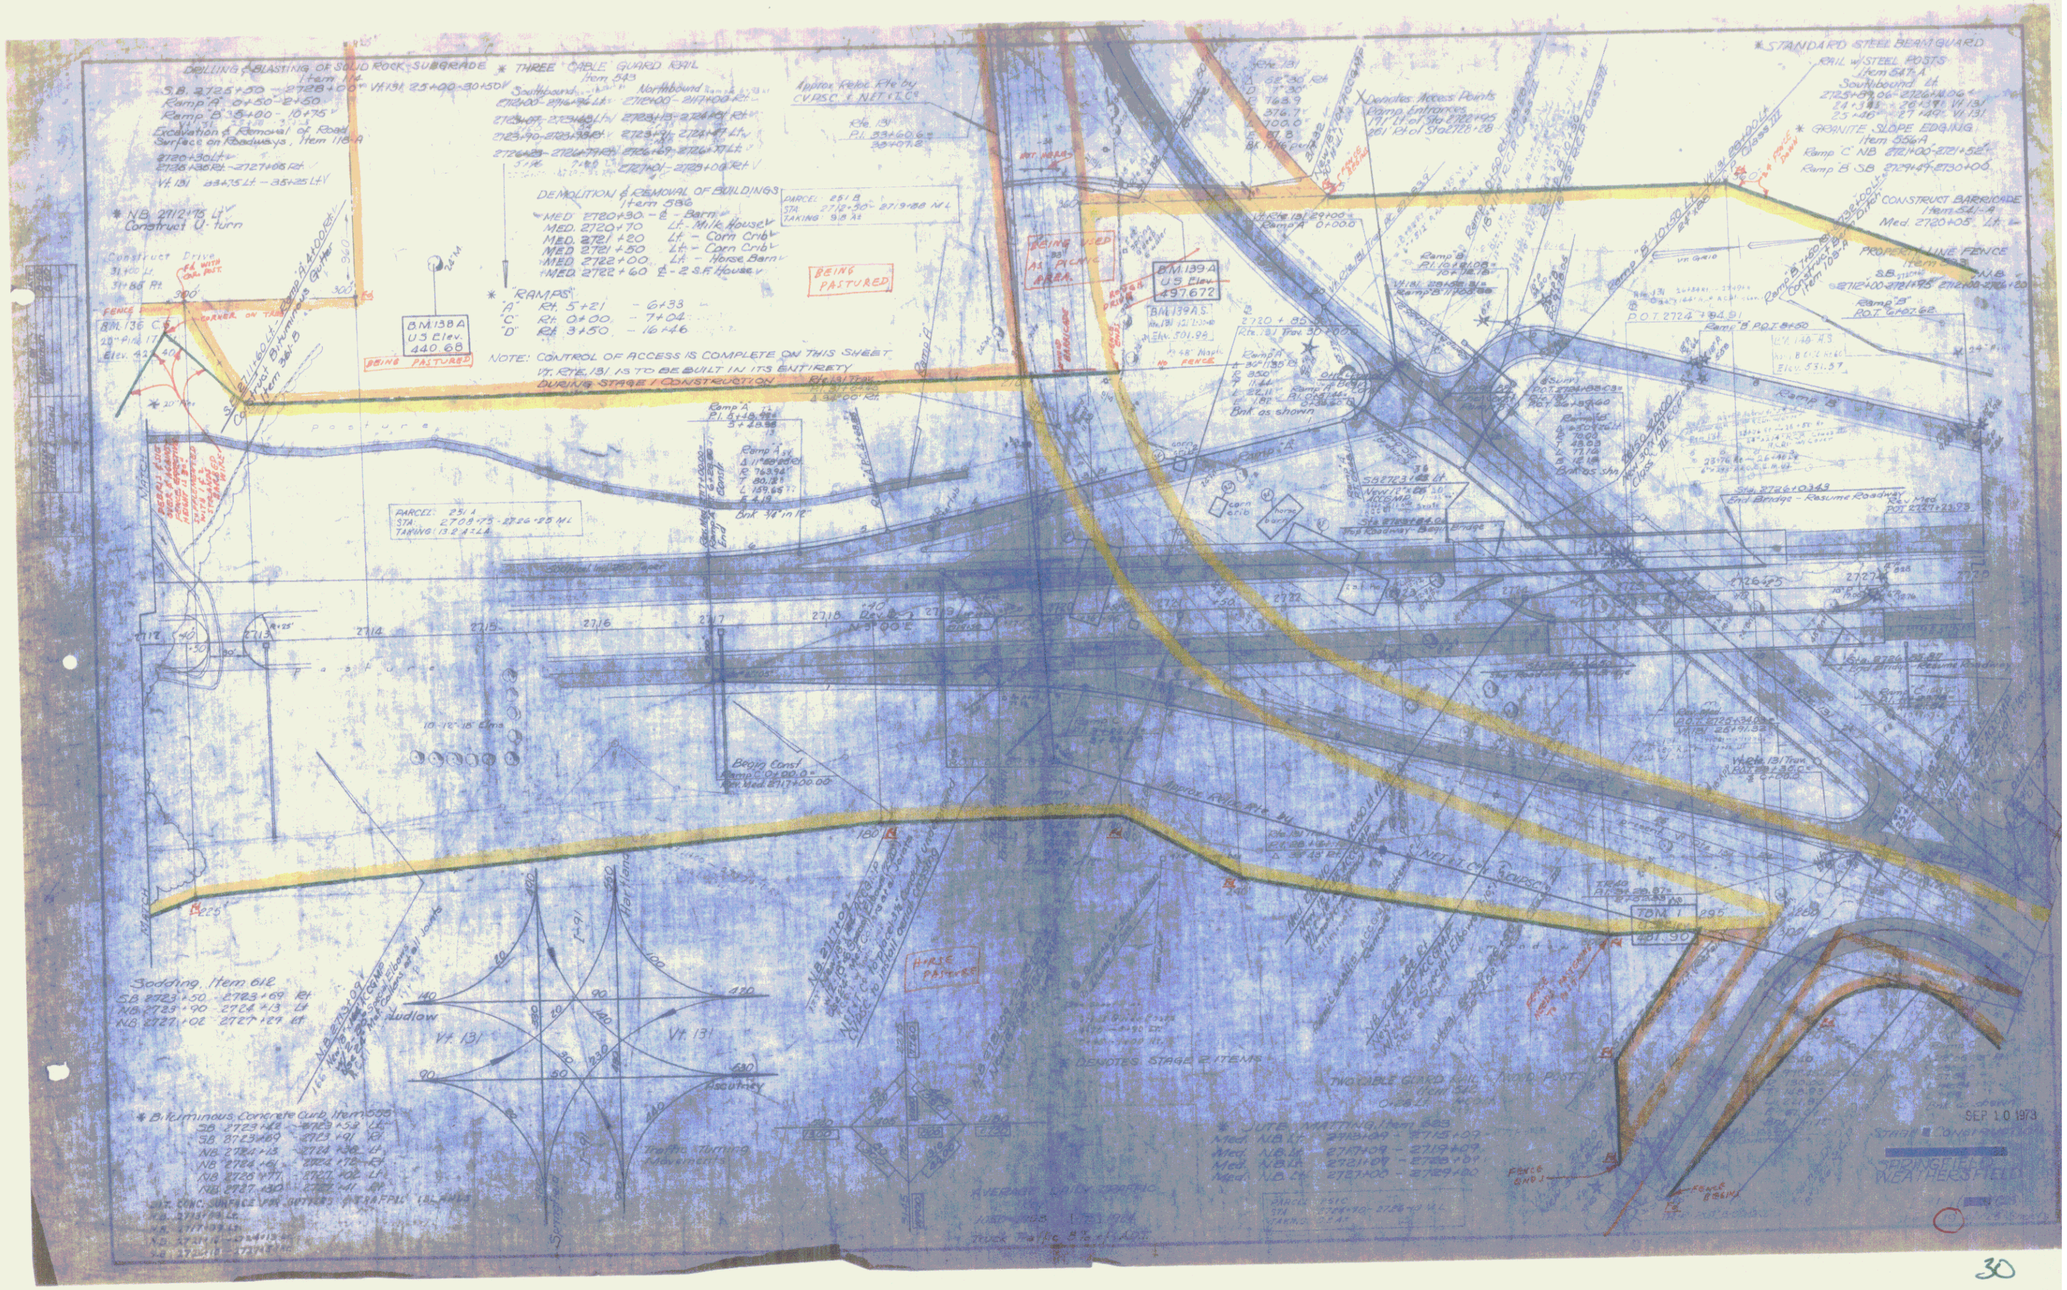
DRILLING & BLASTING OF SOLID ROCK SUBGRADE
Item 204
S.B. 2725+50 - 2728+00 Vt. 131 25+00-30+50
Ramp "A" 0+50 - 2+50
Ramp "B" 35+00 - 10+75
Excavation & Removal of Road Surface on Roadways, Item 116-A
* THREE CABLE GUARD RAIL
Item 649
Southbound
Northbound
DEMOLITION & REMOVAL OF BUILDINGS
Item 596
MED. 2720+90 - E - Barn
MED. 2720+70 Lt. - Milk House
MED. 2721 +20 Lt. - Corn Crib
MED. 2721 +50 Lt. - Corn Crib
MED. 2722 +00 Lt. - Horse Barn
MED. 2722 +60 E - 2 S.F. House
* RAMPS
"A" Rt. 5+21 - 6+33
"C" Rt. 0+00 - 7+04
"D" Rt. 3+50 - 16+46
NOTE: CONTROL OF ACCESS IS COMPLETE ON THIS SHEET.
Vt. Rte. 131 IS TO BE BUILT IN ITS ENTIRETY
DURING STAGE 1 CONSTRUCTION
BM 138A
U.S. Elev.
440.68
BEING PASTURED
BM 139A
U.S. Elev.
497.672
BEING USED AS PICNIC AREA
HORSE PASTURE
* STANDARD STEEL BEAM GUARD RAIL w/STEEL POSTS
Item 647-A
Southbound Lt.
* GRANITE SLOPE EDGING
Item 556-A
Ramp "C" NB 2721+00-2721+52
Ramp "B" SB 2729+57-2730+06
CONSTRUCT BARRICADE
Item 541-A
Med. 2720+05 Lt.
PROTECTIVE FENCE
Item 710-A
Ramp "B" POT 2724+84.91
Ramp "B" POT 8+50
Ramp "D" POT 2+07.62
Sodding, Item 612
SB 2723+50 - 2723+69 Rt.
NB 2723+90 - 2724 +13 Lt.
NB 2727+02 - 2727+121 Lt.
Vt. 131
Ludlow
