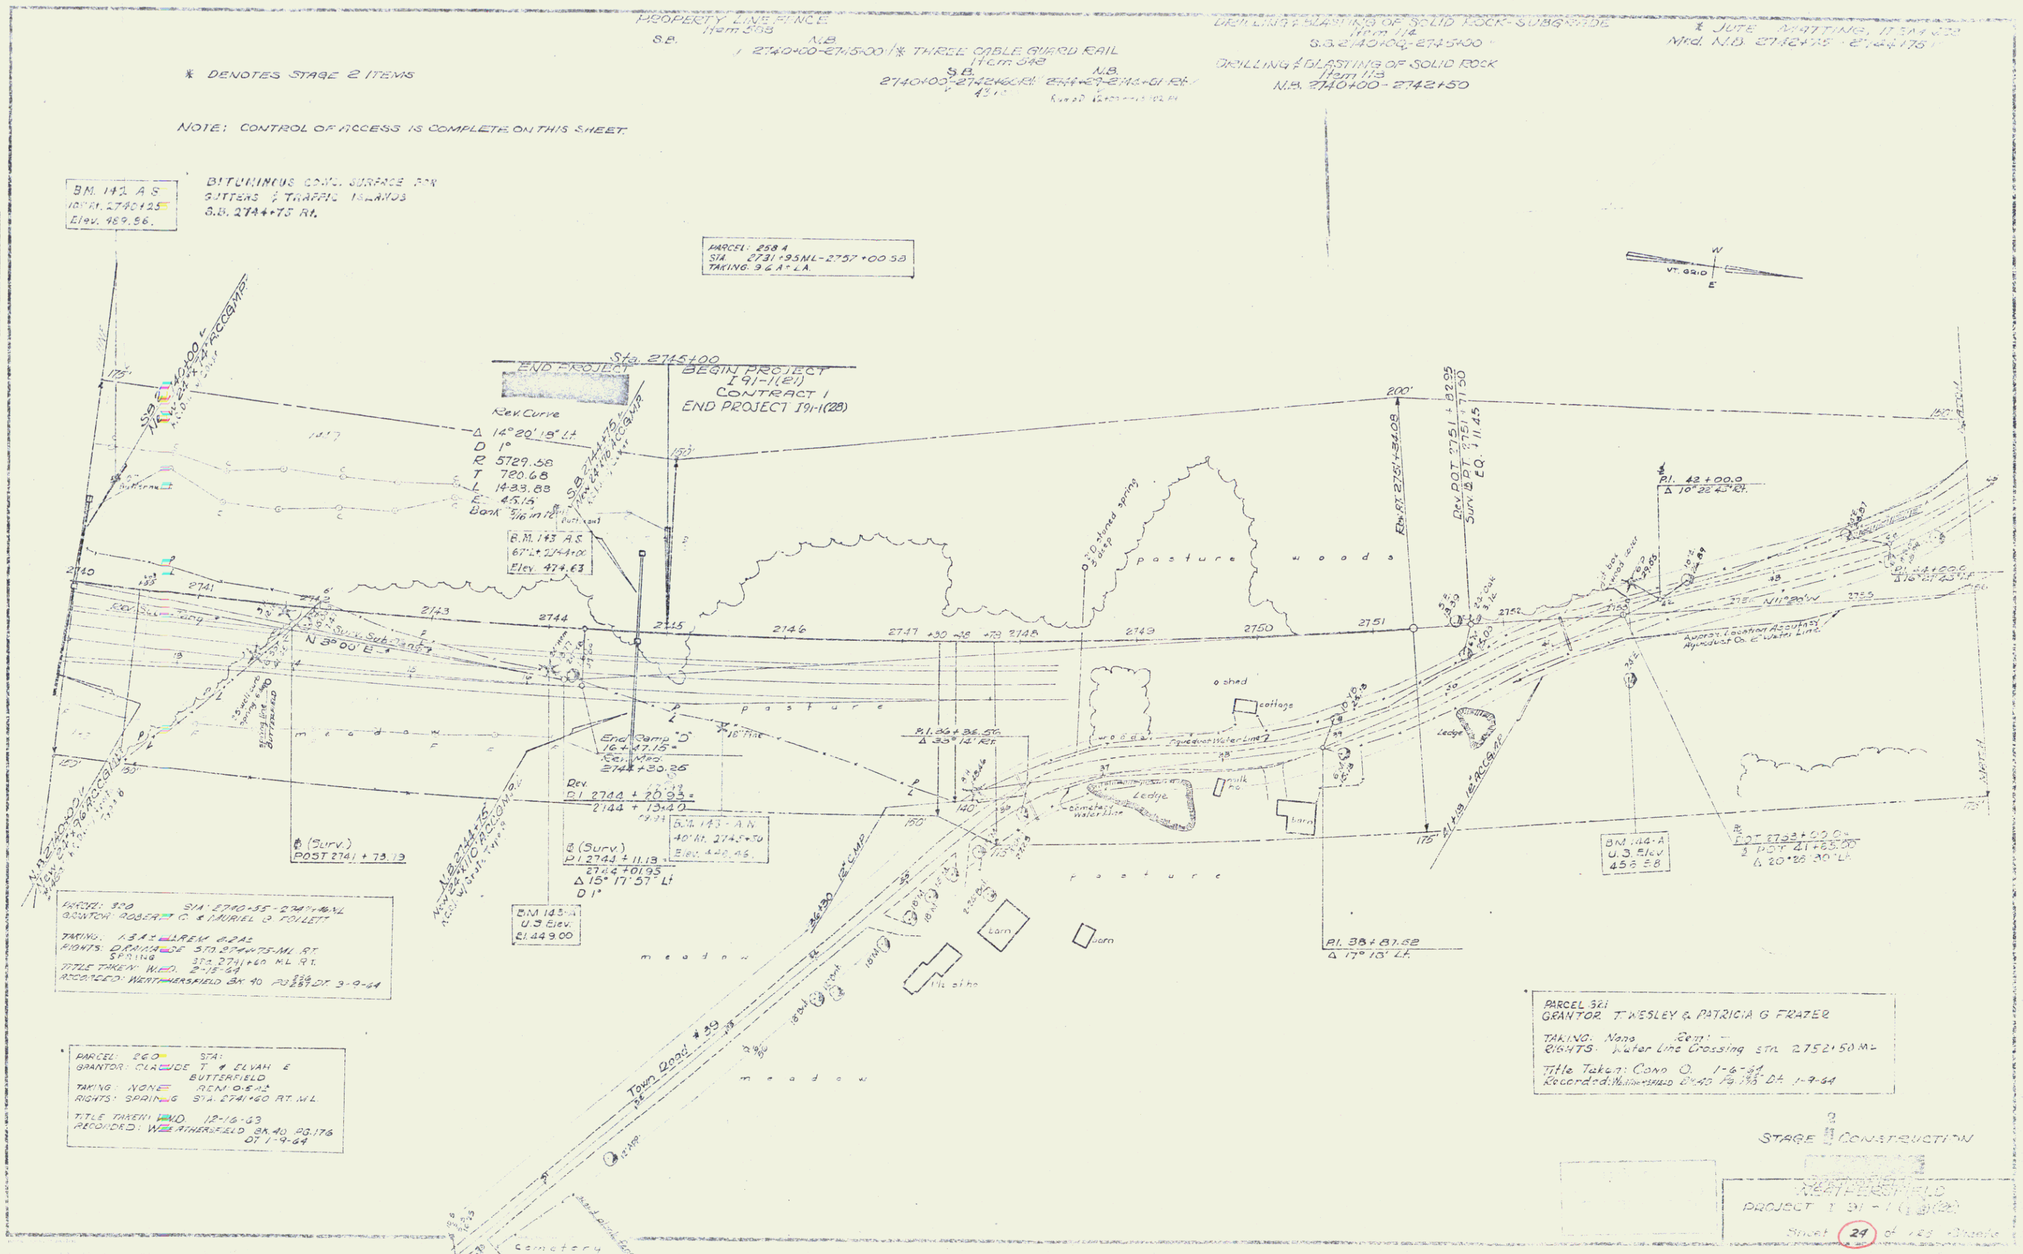
PROPERTY LINE FENCE
Item 518
S.B. N.B.
2740+00-2745+00
* THREE CABLE GUARD RAIL
Item 548
S.B. N.B.
2740+00-2742+60 RT.
DRILLING & BLASTING OF SOLID ROCK-SUBGRADE
Item 114
S.B. 2740+00-2745+00
DRILLING & BLASTING OF SOLID ROCK
Item 114
N.B. 2740+00-2742+50
* JUTE DRAINING FABRIC
Mid. N.B. 2742+75-2744+75
* DENOTES STAGE 2 ITEMS
NOTE: CONTROL OF ACCESS IS COMPLETE ON THIS SHEET.
BM. 142 A S
Elev. 489.56.
BITUMINOUS CONC. SURFACE FOR
GUTTERS & TRAFFIC ISLANDS
S.B. 2744+75 RT.
PARCEL: 258 A
STA 2731+95 NL-2757+00 SB
TAKING: 9.6 A± L.A.
W
VT. GRID
E
STA. 2745+00
END PROJECT
BEGIN PROJECT
F 91-1(21)
CONTRACT 1
END PROJECT F91-1(28)
Rev. Curve
Δ 14° 20' 18" Lt.
D 1°
R 5729.58
T 720.68
L 1433.88
E 45.15
Bank 5/16 in 12
B.M. 143 A S
67' L. 2744+00
Elev. 474.63
Rev. DOT 2751+82.95
Surv. DOT 2751+77.50
EQ. 11.45
Ex. RT. 2751+94.08
P.I. 48+00.0
Δ 10° 22' 40" Rt.
P.I. 44+69.6
Δ 16° 21' 25" Rt.
Pasture
Woods
Meadow
N 50° 00' E
N 11° 00' W
Avipat Locaton Accuracy
Approx. 20' E. Water Line
Shed
Cottage
Ledge
Barn
Silo site
Cemetery
Town Road #29
End Ramp "D"
16+17.15
Rev. Med.
2744+30.26
Rev.
P.I. 2744+20.93
2144+13.40
P.I. 2744+11.13
2744+01.95
Δ 15° 17' 57" Lt.
D 1°
P.I. 38+87.62
Δ 17° 13' Lt.
P.I. 36+30.50
Δ 33° 12' Rt.
BM. 143 A N
40' Rt. 2745+70
Elev. 440.46
BM. 144 A
U.S. Elev.
456.58
BM. 145 A
U.S. Elev.
Elev. 449.00
12" CMP
PARCEL: 300 STA: 2740+55-2741+40 NL
GRANTOR: ROBERT C. & MURIEL D. TOILETT
TAKING: 1.8 A± LREM 6241
RIGHTS: DRAINAGE STA. 2741+75-ML RT.
SPRING STA. 2741+40 ML RT.
TITLE TAKEN: WD. 2-15-64
RECORDED: WEATHERSFIELD BK. 40 PG. 289 DT. 3-9-64
PARCEL: 260 STA:
GRANTOR: CLAUDE T. & ELVAH E. BUTTERFIELD
TAKING: NONE REM. 0.5 A±
RIGHTS: SPRING STA. 2741+60 RT. WL
TITLE TAKEN: WD. 12-16-63
RECORDED: WEATHERSFIELD BK. 40 PG. 176 DT. 1-9-64
PARCEL 321
GRANTOR: T. WESLEY & PATRICIA G. FRAZER
TAKING: None Rem.: —
RIGHTS: Water Line Crossing STA. 2752+50 ML
Title Taken: Cons. O. 1-6-64
Recorded: Weathersfield Bk. 40 Pg. 193 Dt. 1-9-64
STAGE 2 CONSTRUCTION
WEATHERSFIELD
PROJECT F 91-1(28)
Sheet 24 of 125 Sheets

35