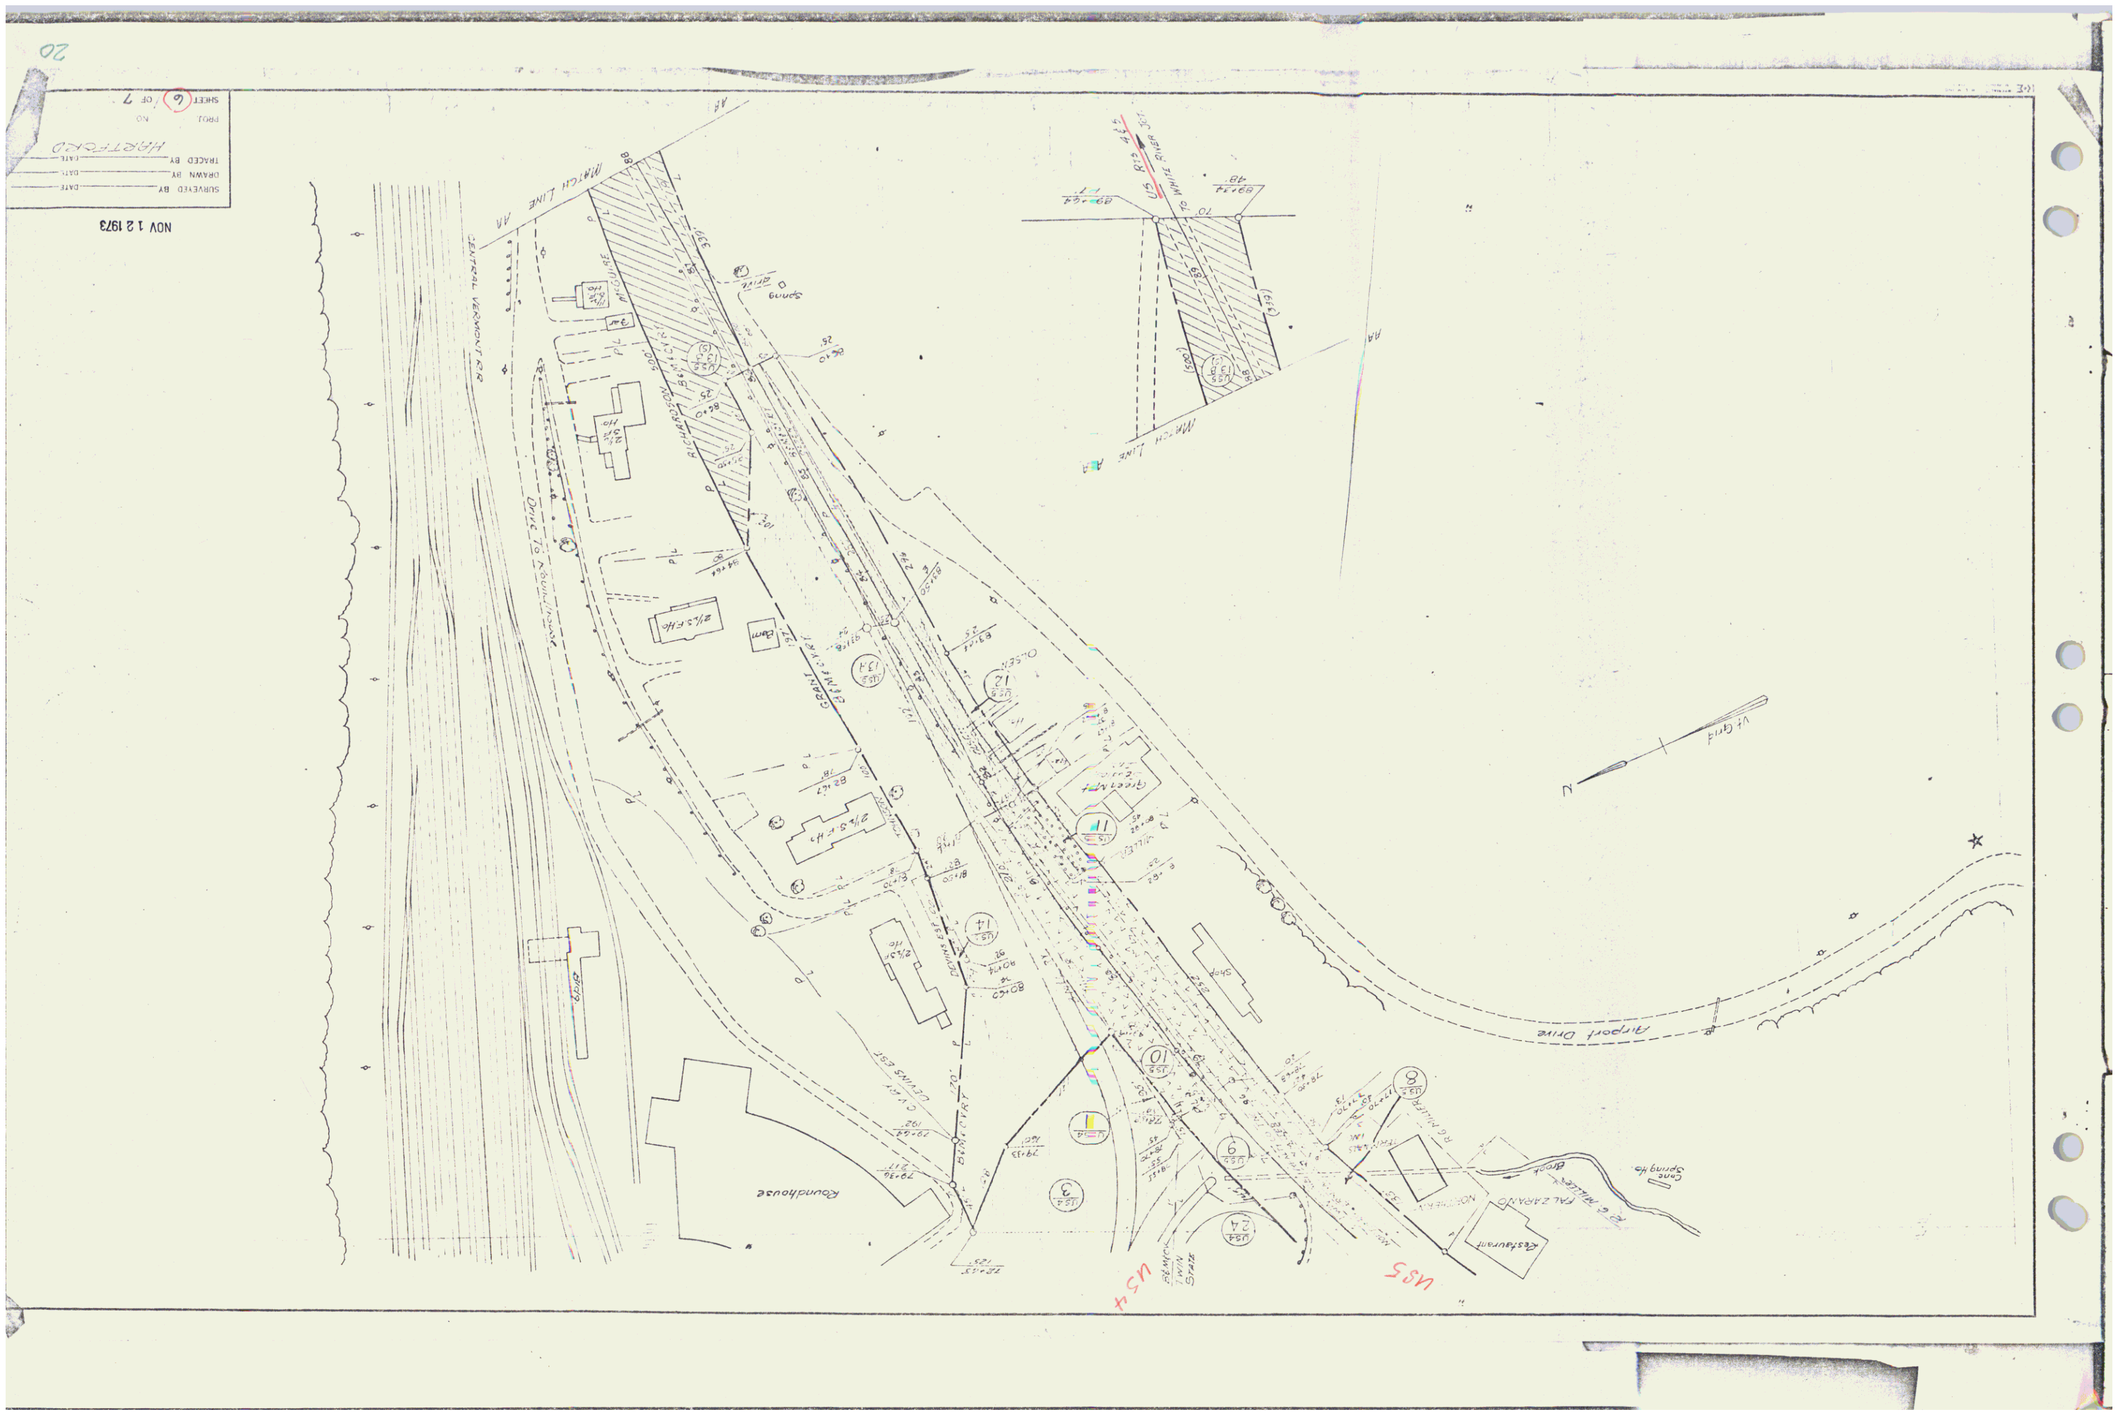
NOV 12 1973
SURVEYED BY
DRAWN BY
TRACED BY
DATE
PROJ. NO.
SHEET 6 OF 7
20
CENTRAL VERMONT R.R.
MATCH LINE AA
MATCH LINE AA
Roundhouse
Airport Drive
Restaurant
