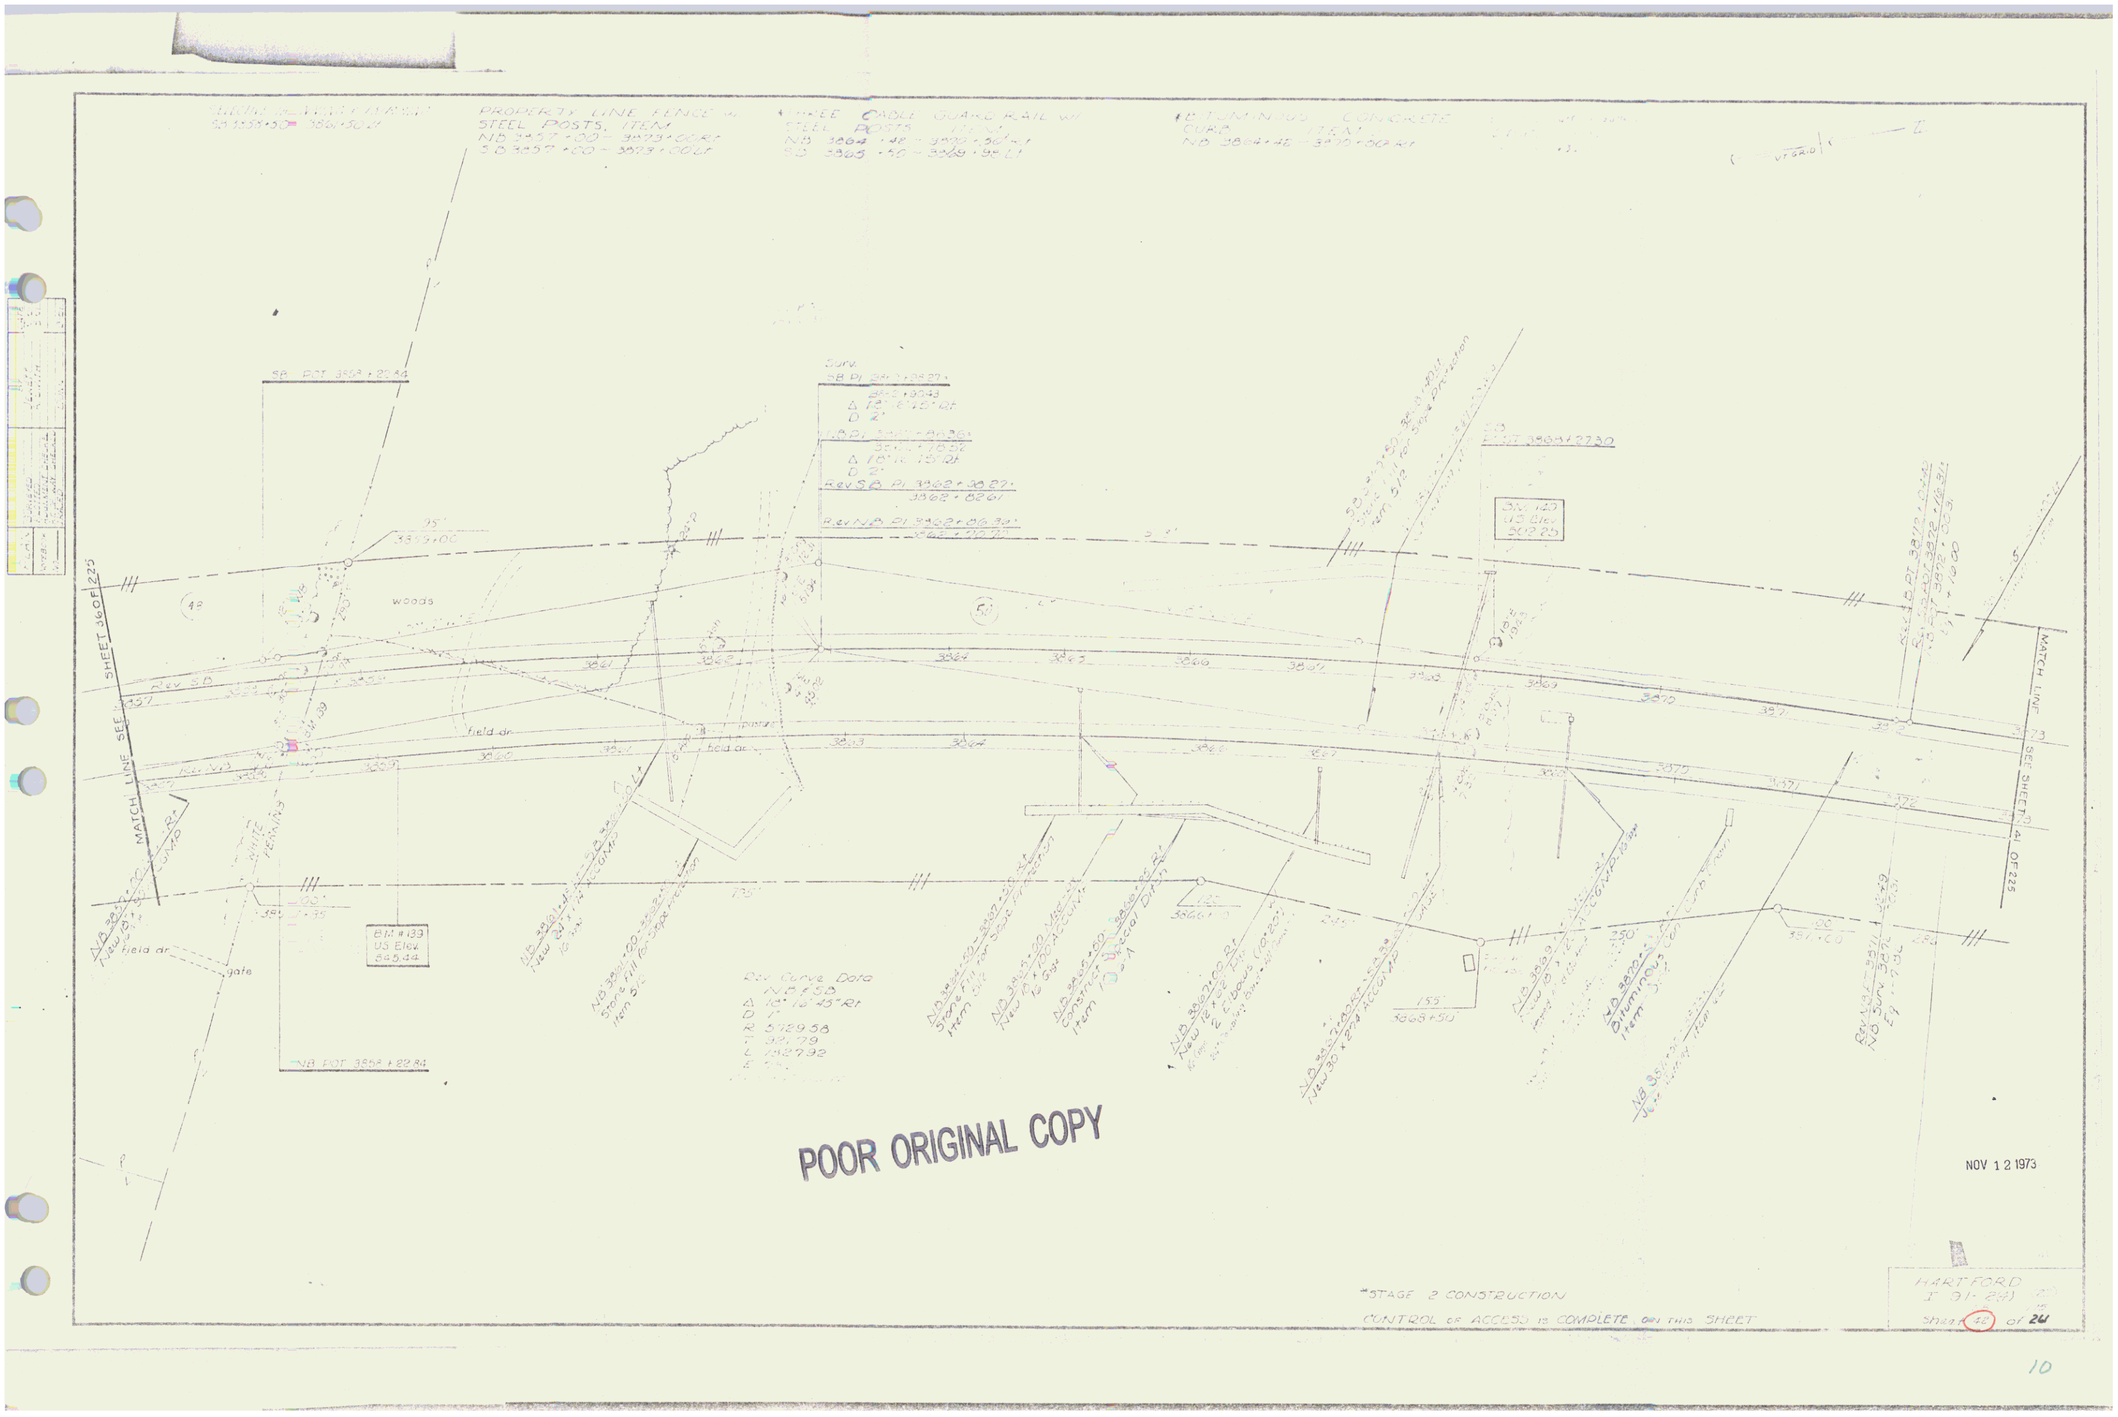
PROPERTY LINE FENCE w/ STEEL POSTS, ITEM
THREE CABLE GUARD RAIL w/ STEEL POSTS
SB PI 3862+38.87
Rev SB PI 3862+38.87
Rev NB PI 3862+86.30
SB PI 3868+27.30
BM #133 US Elev. 885.44
BM #139 US Elev. 502.25
Rev Curve Data
Δ 18° 16' 45" Rt
D 1°
R 5729.58
T 92.79
L 182.92
woods
field dr
gate
MATCH LINE SEE SHEET 360 of 225
NB PGT 3858+22.84
Rev NB
Rev SB
Rev NB PI 3868+50
Rev NB PI 3872+00
