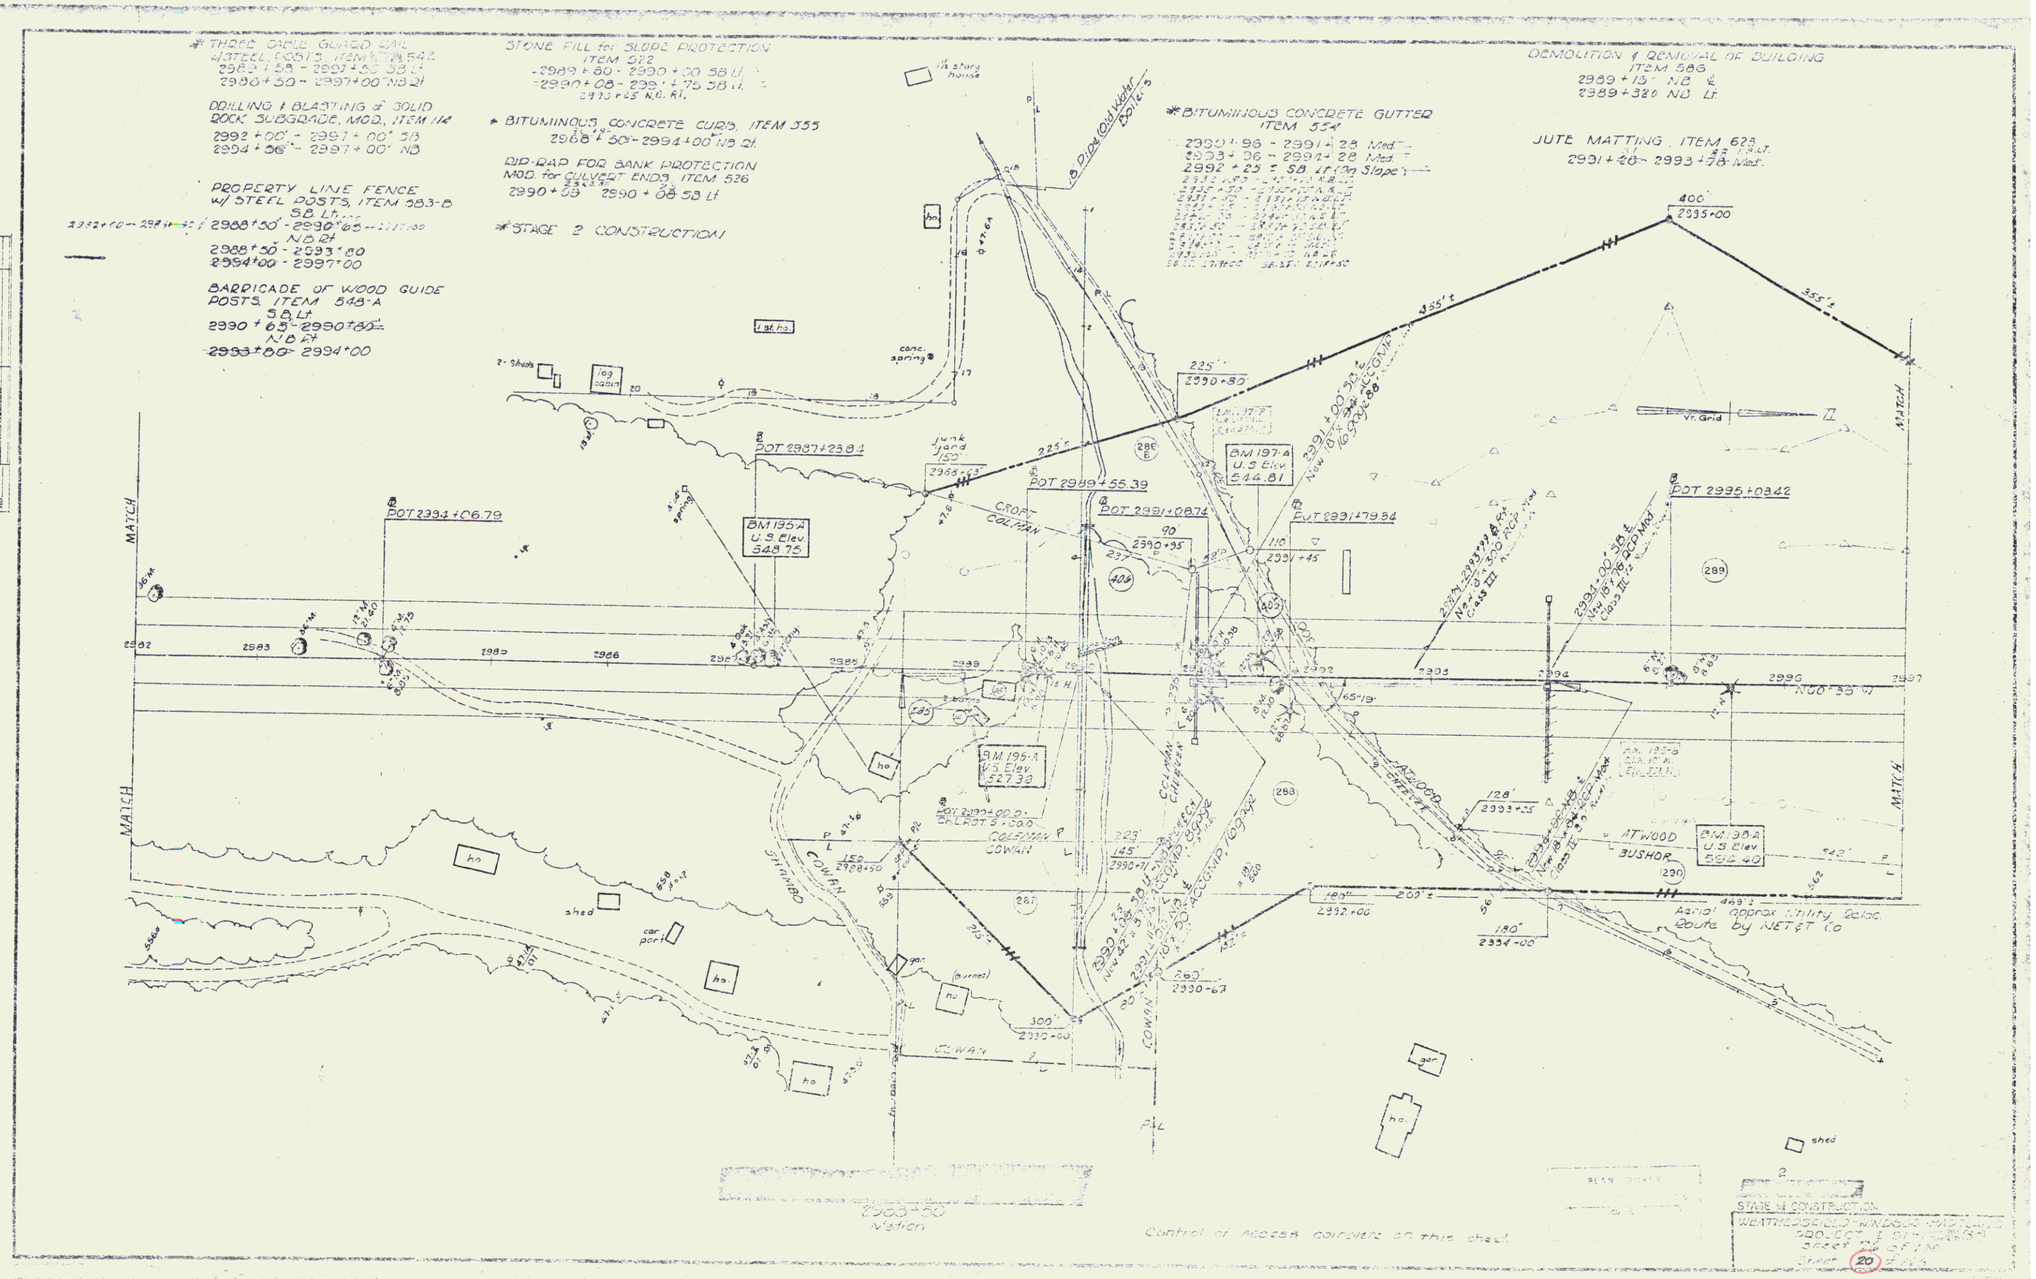
* THREE CABLE GUARD RAIL w/ STEEL POSTS, ITEM 606.542
2989 + 50 - 2993 + 50 SB Lt
2990 + 50 - 2997 + 00 NB Rt
DRILLING & BLASTING of SOLID ROCK SUBGRADE, MOD., ITEM 112
2992 + 00 - 2997 + 00 SB
2994 + 50 - 2997 + 00 NB
PROPERTY LINE FENCE w/ STEEL POSTS, ITEM 683-B
SB Lt
2988 + 50 - 2990 + 65
NB Rt
2988 + 50 - 2993 + 80
2994 + 00 - 2997 + 00
BARRICADE OF WOOD GUIDE POSTS, ITEM 548-A
SB Lt
2990 + 65 - 2990 + 80
NB Rt
2993 + 80 - 2994 + 00
STONE FILL for SLOPE PROTECTION
ITEM 672
2989 + 50 - 2990 + 00 SB Lt
2990 + 08 - 2991 + 75 SB Lt
2993 + 25 NB Rt
* BITUMINOUS CONCRETE CURB, ITEM 355
2988 + 50 - 2994 + 00 NB Rt
RIP-RAP FOR BANK PROTECTION
MOD. for CULVERT ENDS, ITEM 526
2990 + 03 - 2990 + 08 SB Lt
* STAGE 2 CONSTRUCTION
* BITUMINOUS CONCRETE GUTTER
ITEM 354
2990 + 96 - 2991 + 28 Med.
2993 + 06 - 2994 + 28 Med.
2992 + 25 - SB Lt (On Slope)
DEMOLITION & REMOVAL OF BUILDING
ITEM 586
2989 + 13 NB Lt
2989 + 320 NB Lt
JUTE MATTING, ITEM 628
2991 + 26 - 2993 + 78 Med.
400'
2995 + 00
355' ±
225'
2990 + 80
POT 2987 + 23.84
POT 2989 + 55.39
POT 2991 + 08.74
POT 2991 + 79.84
POT 2995 + 08.42
BM 195-A
U.S. Elev.
548.75
BM 197-A
U.S. Elev.
544.81
BM 198-A
U.S. Elev.
594.40
junk yard
Vr. Grid
MATCH
COWAN
ATWOOD
BUSHOR
Aerial approx utility reloc. route by NE T&T Co
Control of access controls on this sheet
STATE HIGHWAY CONSTRUCTION
WEATHERSFIELD - WINDSOR
PROJECT
SHEET 20 OF 150
29