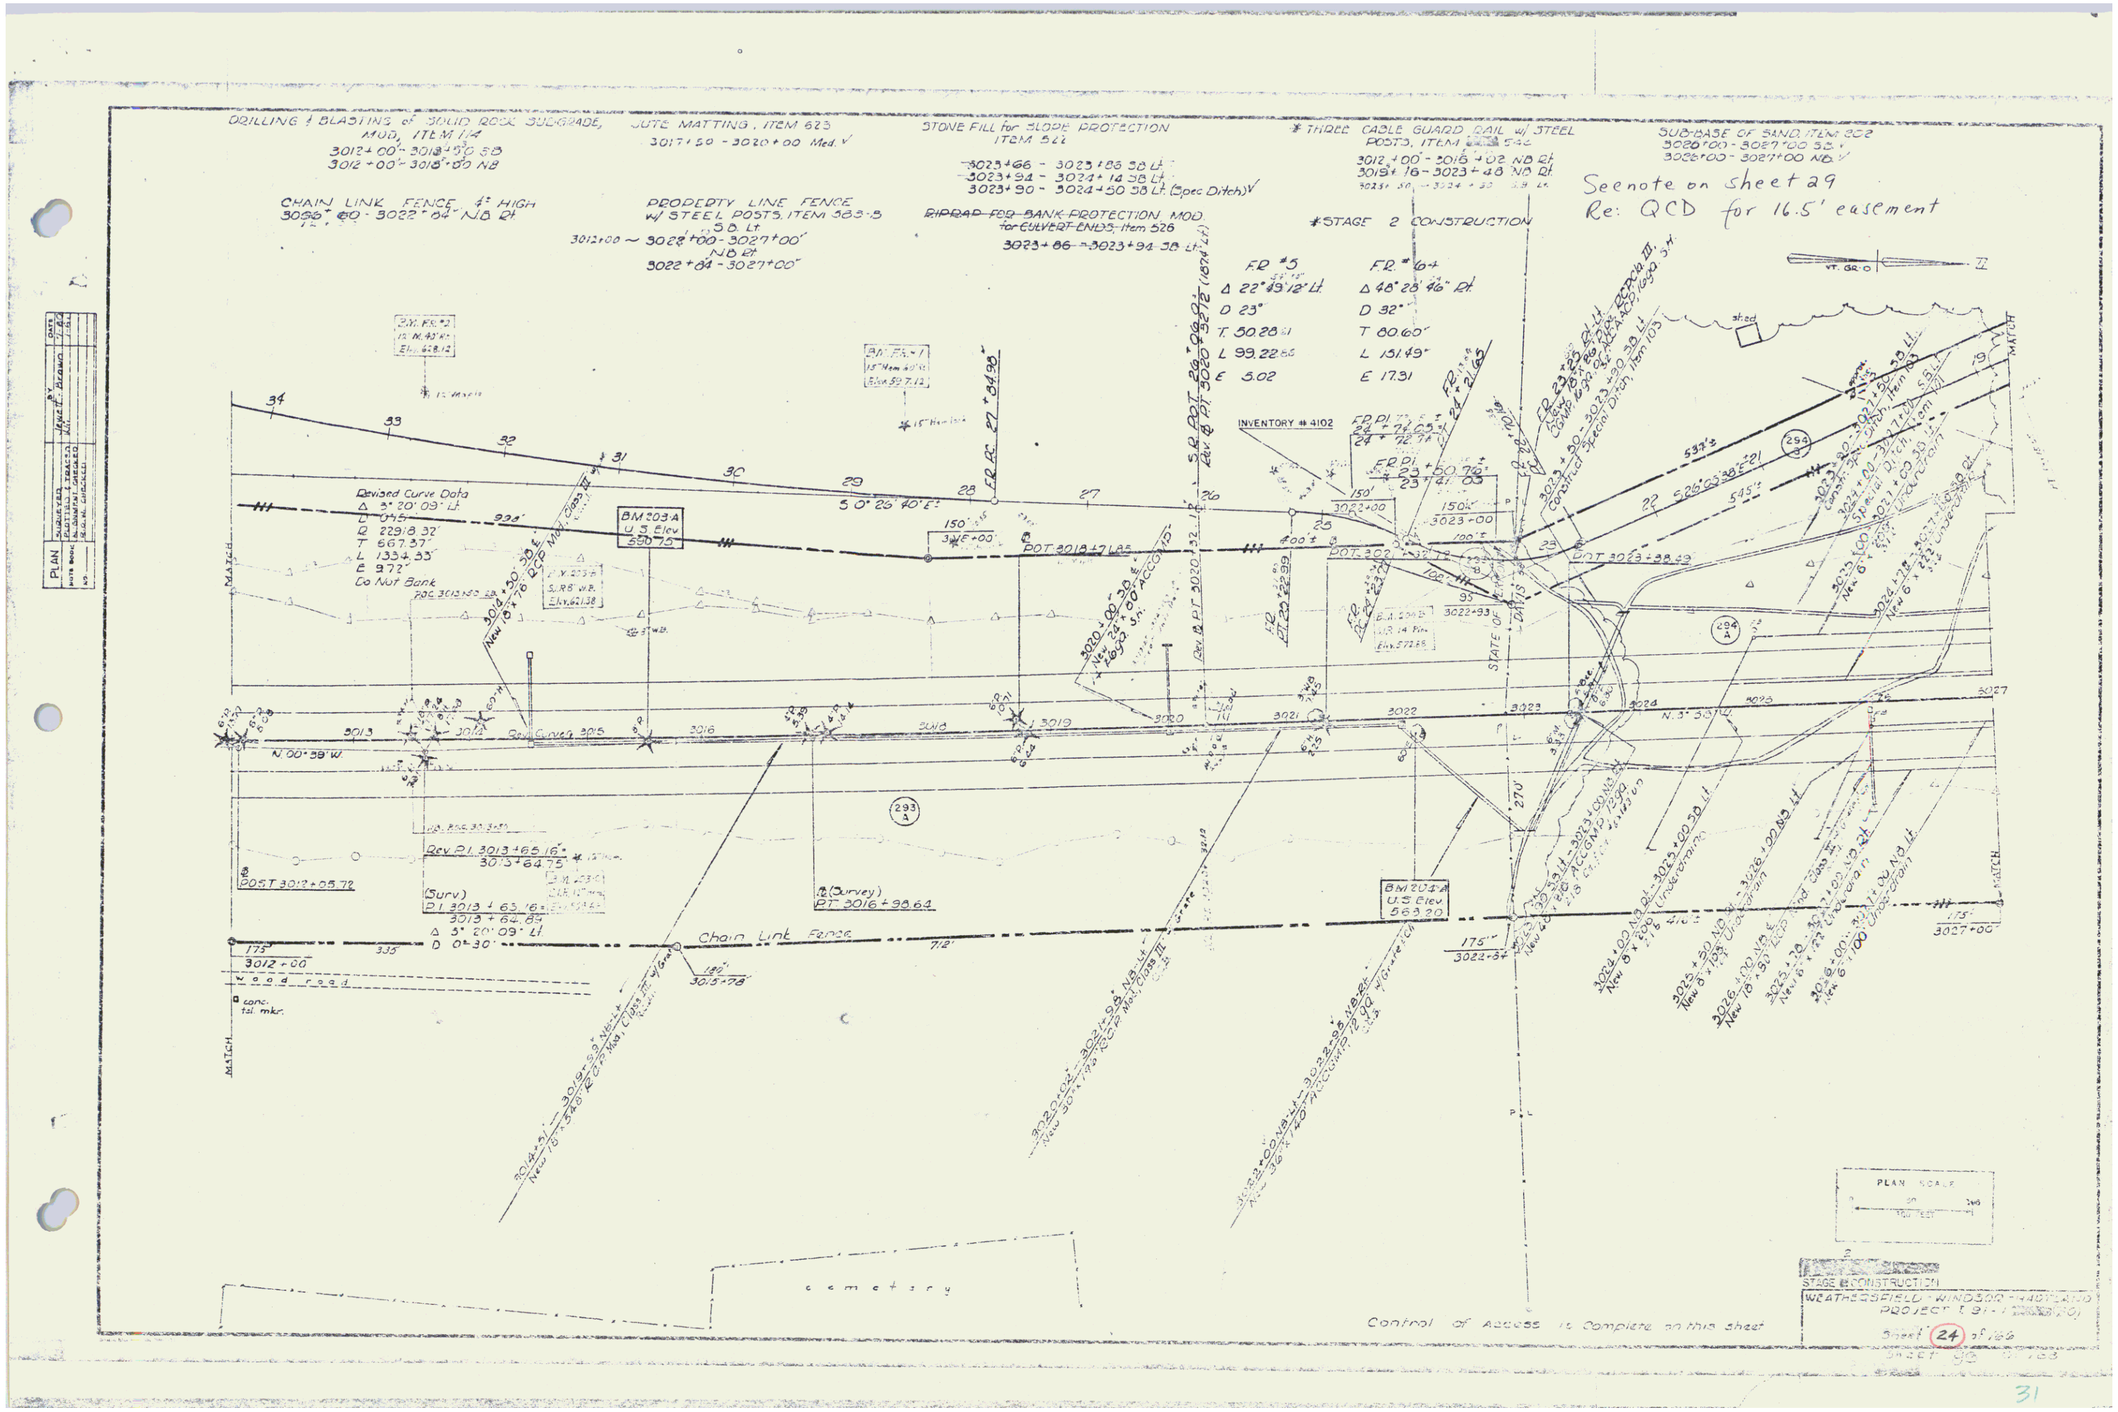
DRILLING & BLASTING of SOLID ROCK SUBGRADE, MOD, ITEM 114
3012+00 - 3018+50 SB
3012+00 - 3018+00 NB
JUTE MATTING, ITEM 623
3017+50 - 3020+00 Med.
STONE FILL for SLOPE PROTECTION ITEM 522
3023+66 - 3023+86 SB Lt
3023+94 - 3024+14 SB Lt
3023+90 - 3024+50 SB Lt (Spec Ditch)
* THREE CABLE GUARD RAIL w/ STEEL POSTS, ITEM 540
3012+00 - 3018+02 NB Rt
3018+18 - 3023+48 NB Rt
SUB-BASE OF SAND, ITEM 302
3026+00 - 3027+00 SB
3026+00 - 3027+00 NB
See note on sheet 29
Re: QCD for 16.5' easement
CHAIN LINK FENCE, 4' HIGH
3025 - 3022+04 NB Rt
PROPERTY LINE FENCE w/ STEEL POSTS, ITEM 383-3
SB Lt
3012+00 ~ 3028+00 - 3027+00
NB Rt
3022+04 - 3027+00
RIPRAP FOR BANK PROTECTION MOD for CULVERT ENDS, Item 526
3023+86 - 3023+94 SB Lt
* STAGE 2 CONSTRUCTION
FR #5
Δ 22° 49' 12" Lt
D 23°
T 50.28
L 99.22
E 5.02
FR #6+
Δ 48° 28' 46" Rt
D 32°
T 80.60'
L 151.49'
E 17.31
INVENTORY # 4102
Revised Curve Data
Δ 3° 20' 09" Lt
D 0°45'
R 2291.8 32'
T 667.37'
L 1334.33'
E 9.72'
Do Not Bank
BM 203-A
U.S. Elev. 580.75
BM 204-A
U.S. Elev. 568.30
Chain Link Fence
wood road
cemetery
Control of Access is Complete on this sheet
PLAN SCALE
STAGE 2 CONSTRUCTION
WEATHERSFIELD - WINDSOR - HARTLAND
PROJECT
Sheet 24 of 166

31