SODDING, ITEM 612 & TOPSOIL, ITEM 621
3089 + 75 - 3092 + 27 SB Lt.

* THREE CABLE GUARD RAIL, ITEM [redacted] 542
3076 + 66 - 3080 + 98 NB Rt.

* STANDARD STEEL BEAM GUARD RAIL w/ STEEL POSTS, ITEM [redacted] 545-A
3083 + 11 - 3083 + 65 N.B. Rt.
3083 + 32 - 3083 + 86 S.B. Lt.

STONE FILL FOR SLOPE PROTECTION ITEM 522
3079 + 95 - 3080 + 05 NB Rt.

JUTE MATTING, ITEM 623
3075 + 75 - 3076 + 50 Median

* STAGE 2 CONSTRUCTION

~~RIP RAP for BANK PROTECTION~~ ~~for CULVERT END~~ ~~ITEM 526~~
3083 + 54 - 3083 + 64 SB Lt.

PROPERTY LINE FENCE w/ STEEL POSTS, Mod. ITEM 583-B
S.B. Lt.
3089 + 52 - 3090 + 00
NB Rt.
3074 + 00 - 3090 + 00

DRILLING & BLASTING of SOLID ROCK SUB-GRADE, MOD. ITEM 114
3074 + 00 - 3078 + 50 SB
3080 + 50 - 3083 + 09 SB
3074 + 00 - 3076 + 50 NB

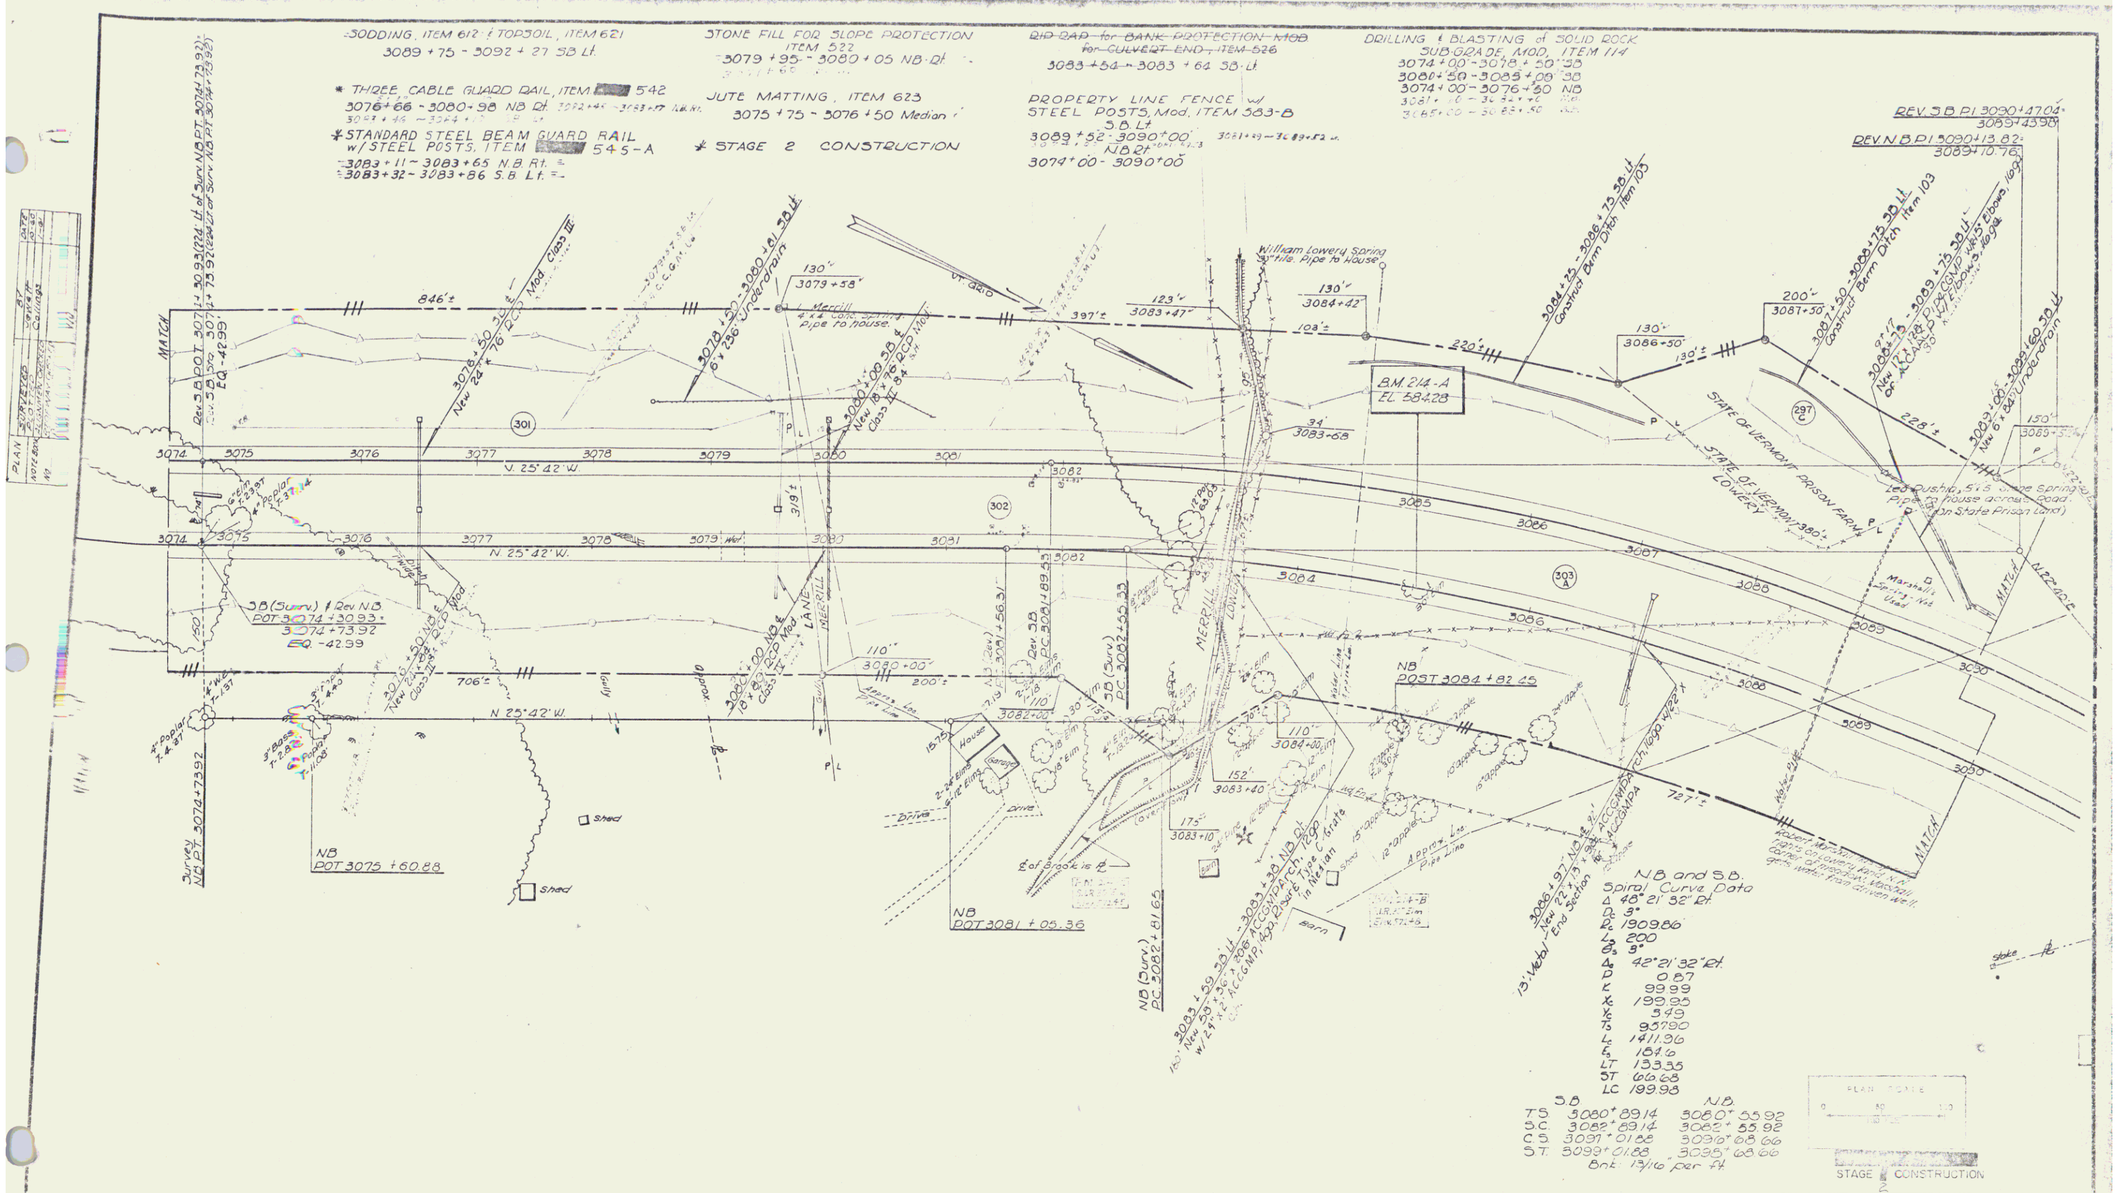

Control of Access is complete on this sheet

WEATHERSFIELD - WINDSOR - HARTLAND
PROJECT I 91-1 (30)
Sheet 33 of 166
Sheet 28 of 188

36