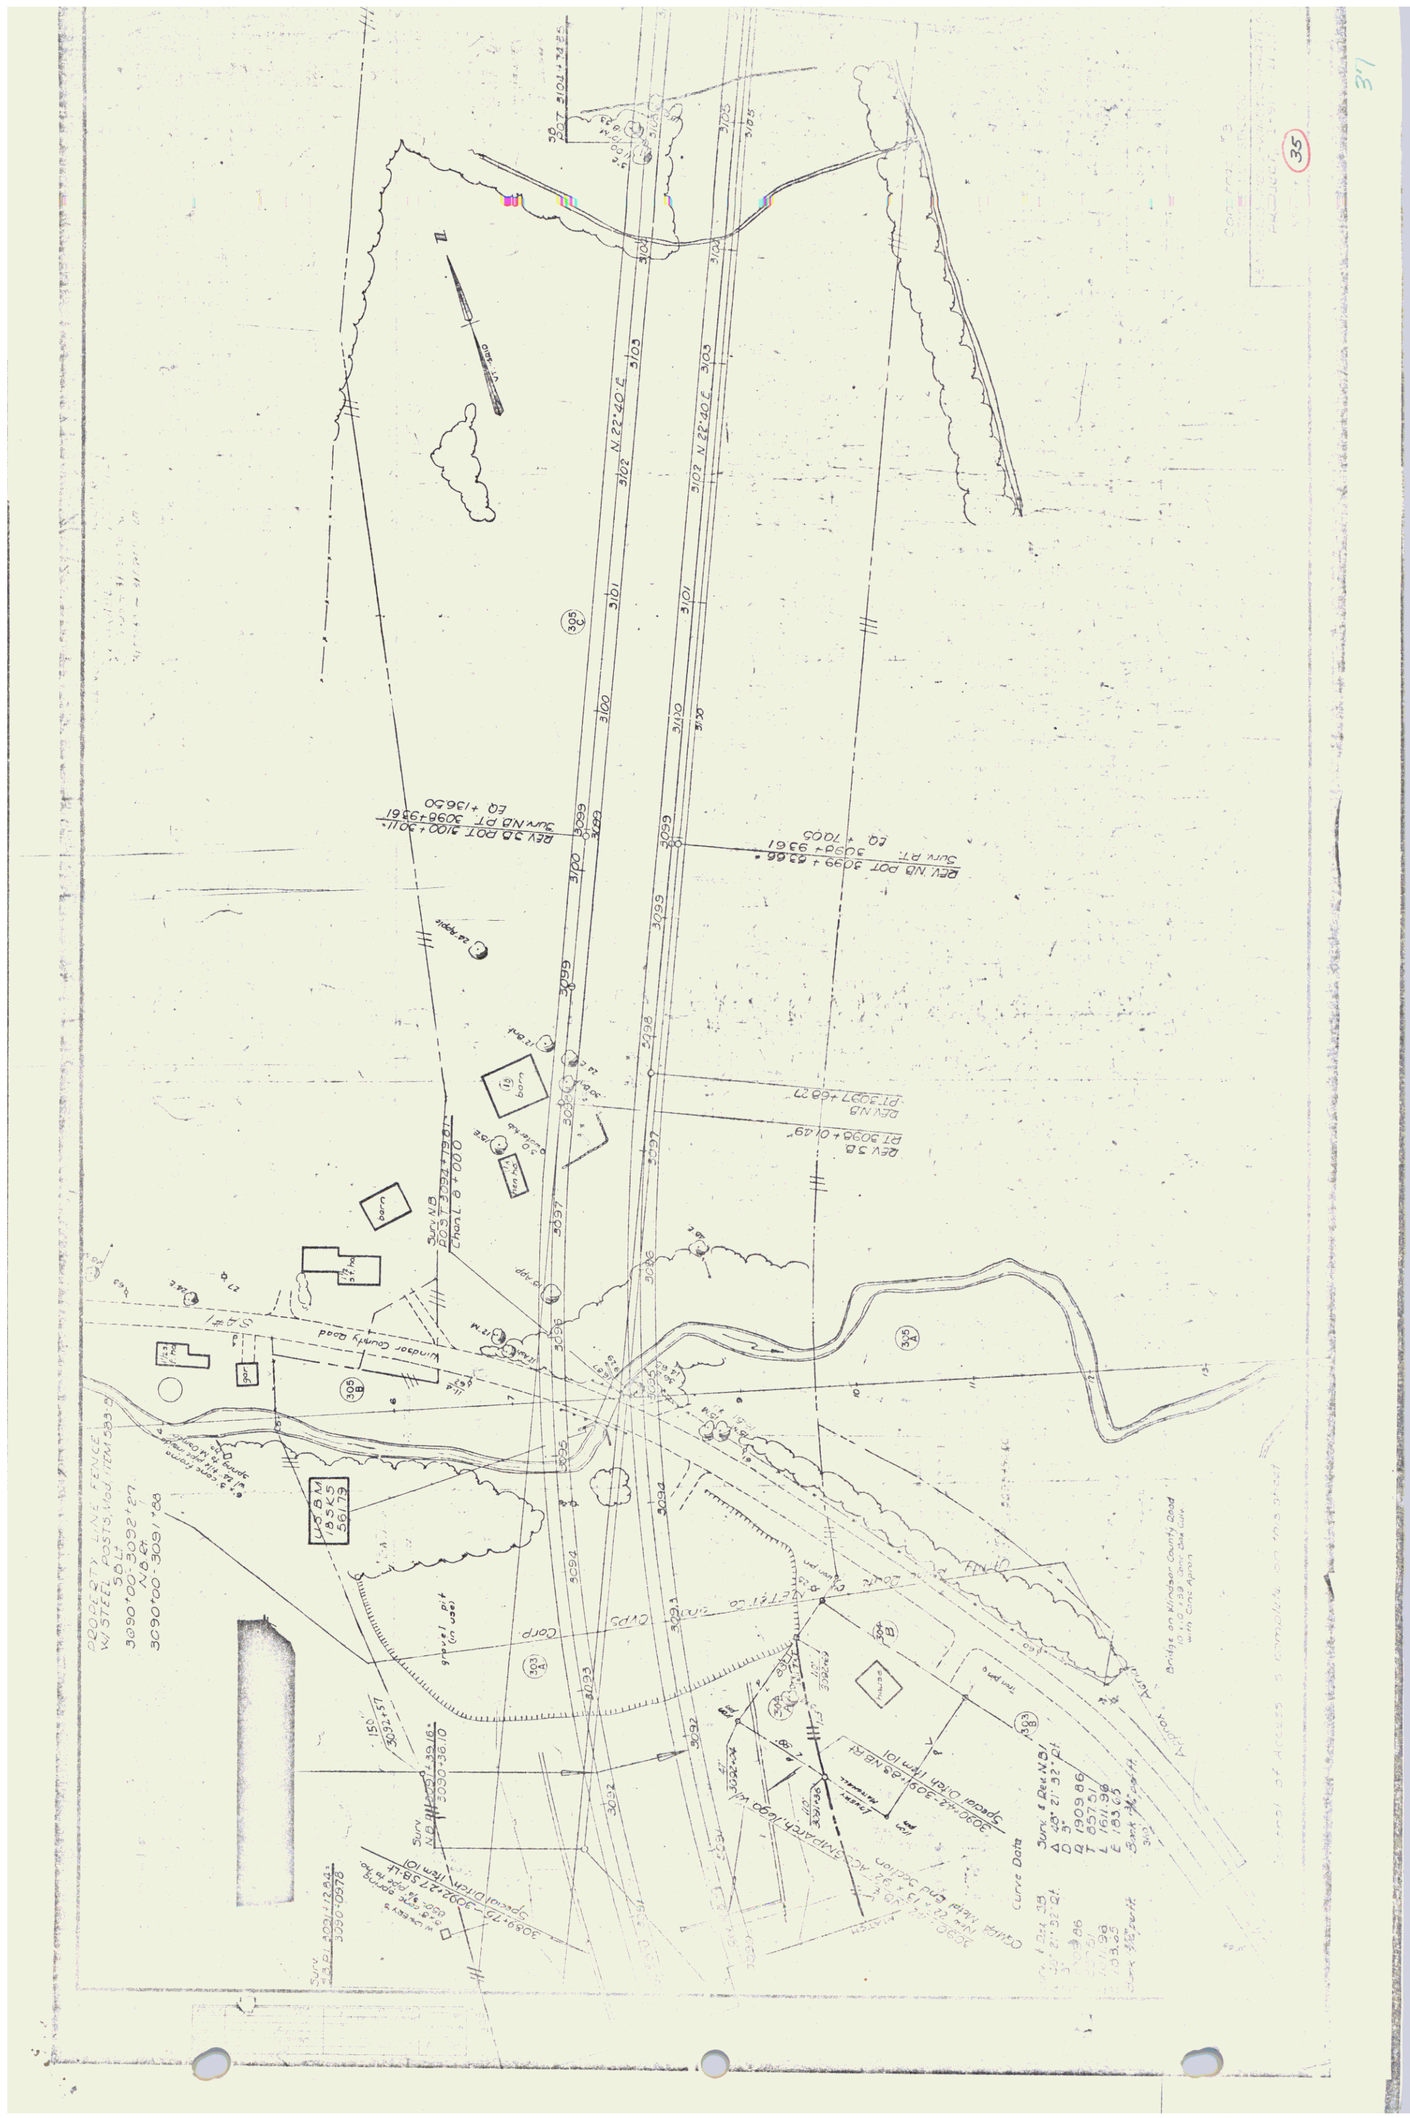
Curve Data
Windsor County Road
Bridge on Windsor County Road
Spread Ditch Item 101
Special Ditch Item 101
Gravel pit
Corp
Corp
Corp
Corp
N 22°40'E
N 22°40'E
N 22°40'E
Dev Rt. N.B.
Sur. Rt. N.B.
Dev. 5.B.
Sur. N.B.
Sur. 5.B.
