SHEETS

SHEET NO. 1. Title Sheet
2. Alignment Sheet
3. Interstate Typical Cross Sections, Standard Median
4. Interstate Typical Cross Sections, Variable Median
5. Ramp Typical Cross Sections
6. Route 5 Typical Cross Sections
7-9. Quantity Sheets
10-12A. Item Detail and Drainage Sheets
13-19. Earthwork Sheets
20.2-21. Right of Way Detail Sheets
22-44. Plan and Profile Sheets
45-47. 20 Scale Grading Plans
48. Standard Drawing A-41
49. Standard Drawing B-1
50. Standard Drawing B-5
51. Standard Drawing B-9
52. Standard Drawing B-15
53. Standard Drawing B-17
54. Standard Drawing D-2
55. Standard Drawing D-3
56. Standard Drawing D-4
57. Standard Drawing D-8
58. Standard Drawing D-10
59. Standard Drawing D-11
60. Standard Drawing D-14
61. Standard Drawing D-16
62. Standard Drawing D-17
63. Standard Drawing E-31 63A. Guardrailings, Posts and Lights (Roadway)
64-85. BR 2000 Series, Structures 63A, 63 (See Sheet 65 for Details)
86-89. Bridge Standard Sheet, SCWPG-BC-62-Sheets 1 thru 5
90. Bridge Standard Sheet-SCB-D1-62
91. Bridge Standard Sheet-SCB-D2-62
92. Bridge Standard Sheet-SCB-D4-62
93-94. Bridge Standard Sheet-SA-BG-62-Sheets 1 and 2
95. Plan and Elevation 9A" CGMP Wabnan Brook
96-102. Channel Cross Sections Wabnan Brook
103-116. BR 2000 Series, Structures 63.5, 65 (See Sheet 103 for Details)
117-128. Bridge Standard Drawings (See Sheet 103 for Details)
129-257. Roadway Cross Sections
258-267. U.S. 5 Cross Sections
268-273. Ramps "A" Cross Sections
274-276. Ramps "B" Cross Sections
277-279. Ramps "C" Cross Sections
280-282. Ramps "D" Cross Sections
283-287. State Aid 41 Cross Sections

STATE OF VERMONT
DEPARTMENT OF HIGHWAYS

PROPOSED IMPROVEMENT

INTERSTATE PROJECT

TOWNS OF WEATHERSFIELD-WINDSOR-HARTLAND
COUNTY OF WINDSOR
INTERSTATE ROUTE 91
BRATTLEBORO-WHITE RIVER JCT. ROAD

Project # I 91-1(21) CONTRACT # 4

BEGINNING AT A POINT 1.571 ± MILES SOUTHERLY OF THE WINDSOR-HARTLAND TOWN LINE AND EXTENDING NORTHERLY 2.434 MILES

LENGTH OF ROADWAY 12,734.13 FEET = 2.412 MILES
LENGTH OF BRIDGE 119.21 FEET = 0.022 MILE
LENGTH OF CONTRACT 12,853.34 FEET = 2.434 MILES

POOR ORIGINAL COPY

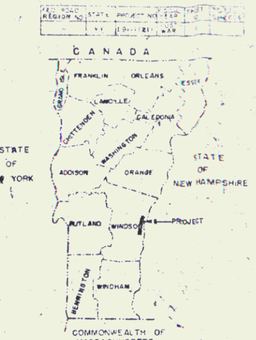

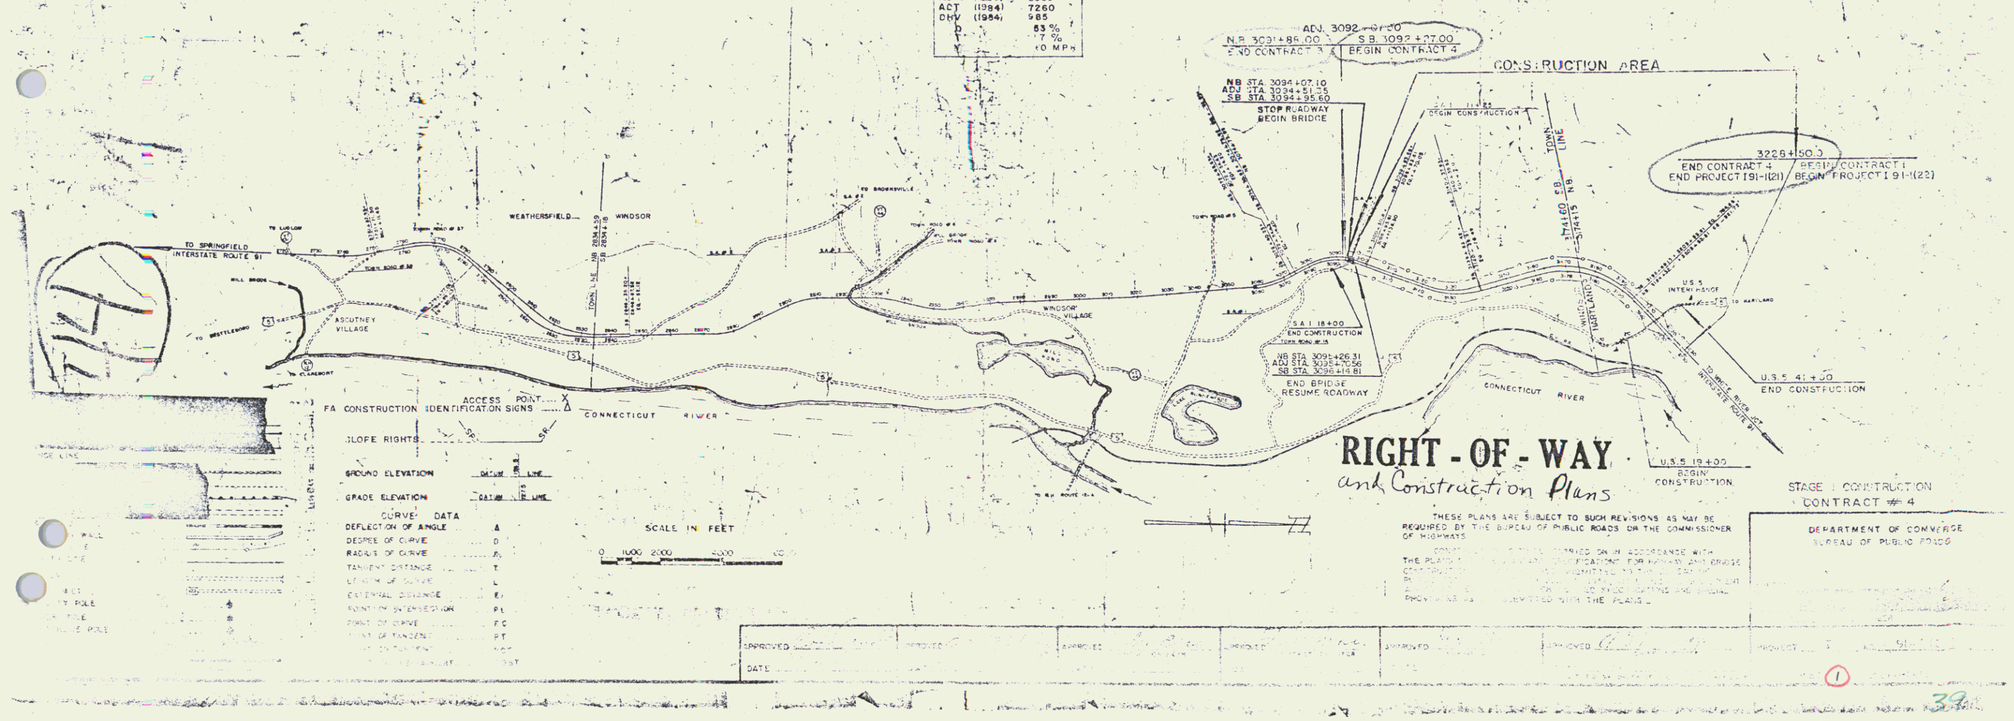

RIGHT - OF - WAY
and Construction Plans

THESE PLANS ARE SUBJECT TO SUCH REVISIONS AS MAY BE REQUIRED BY THE BUREAU OF PUBLIC ROADS OR THE COMMISSIONER OF HIGHWAYS

STAGE 1 CONSTRUCTION
CONTRACT # 4

DEPARTMENT OF CONVERSE
BUREAU OF PUBLIC ROADS

APPROVED
DATE

1

39