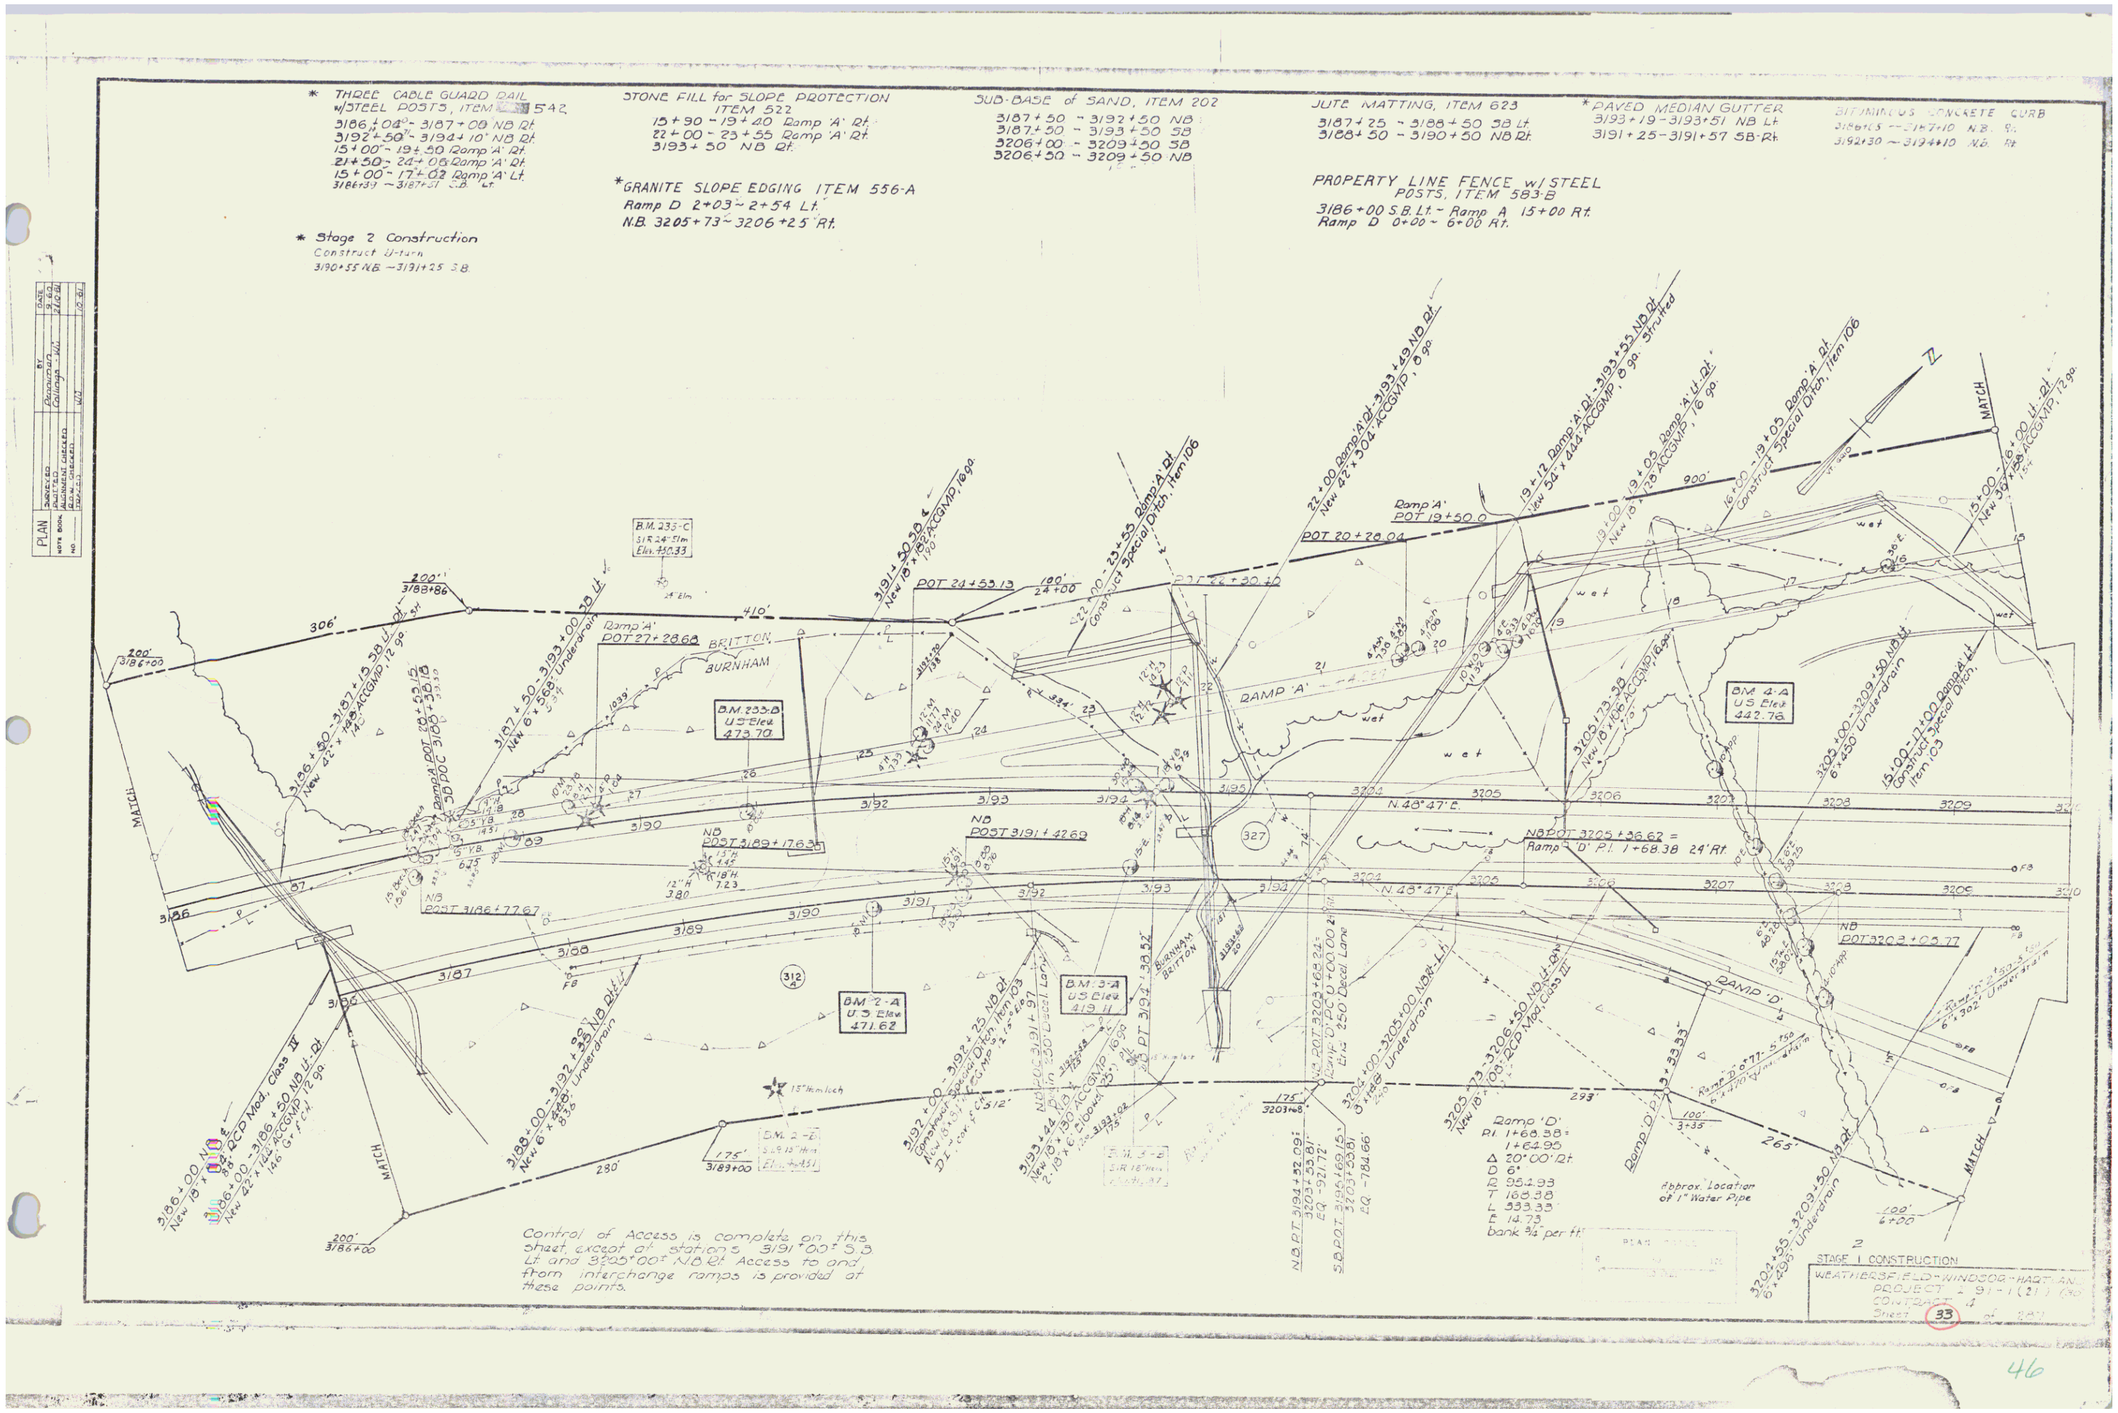
* THREE CABLE GUARD RAIL w/STEEL POSTS, ITEM 542
3186+04 - 3187+00 NB Rt.
3192+50 - 3194+10 NB Rt.
15+00 - 19+50 Ramp 'A' Rt.
21+50 - 24+06 Ramp 'A' Rt.
15+00 - 17+02 Ramp 'A' Lt.
3186+39 - 3187+51 SB Lt.
STONE FILL for SLOPE PROTECTION ITEM 522
15+90 - 19+40 Ramp 'A' Rt.
22+00 - 23+55 Ramp 'A' Rt.
3193+50 NB Rt.
SUB-BASE of SAND, ITEM 202
3187+50 - 3192+50 NB
3187+50 - 3193+50 SB
3206+00 - 3209+50 SB
3206+50 - 3209+50 NB
JUTE MATTING, ITEM 623
3187+25 - 3188+50 SB Lt.
3188+50 - 3190+50 NB Rt.
*PAVED MEDIAN GUTTER
3193+19 - 3193+51 NB Lt.
3191+25 - 3191+57 SB Rt.
BITUMINOUS CONCRETE CURB
3186+65 - 3187+10 NB Rt.
3192+30 - 3194+10 NB Rt.
*GRANITE SLOPE EDGING ITEM 556-A
Ramp D 2+03 - 2+54 Lt.
N.B. 3205+73 - 3206+25 Rt.
PROPERTY LINE FENCE w/STEEL POSTS, ITEM 583-B
3186+00 S.B. Lt. - Ramp A 15+00 Rt.
Ramp D 0+00 - 6+00 Rt.
* Stage 2 Construction
Construct U-turn
3190+55 NB - 3191+25 SB
PLAN
SURVEYED
PLOTTED
NOTE BOOK
NO.
DESIGNED
CHECKED
REVIEWED
DATE
Ramp 'A'
POT 19+50.0
POT 20+28.04
POT 24+55.13
POT 27+28.68
BRITTON
BURNHAM
RAMP 'A'
B.M. 233-C
B.M. 235-B
U.S. Elev. 473.70
B.M. 4-A
U.S. Elev. 442.78
B.M. 2-A
U.S. Elev. 471.62
B.M. 3-A
U.S. Elev. 419.11
N.48°47'E.
NB POT 3205+36.62 = Ramp 'D' P.I. 1+68.38 24' Rt.
NB POT 3189+17.63
NB POT 3191+42.69
NB POT 3186+77.67
NB POT 3202+05.77
Ramp 'D'
P.I. 1+68.38 = 1+64.95
Δ 20°00'12t
D 6°
R 954.93
T 168.38
L 333.33
E 14.73
bank 3/4" per ft.
Approx. Location of 1" Water Pipe
MATCH
Control of Access is complete on this sheet except at stations 3191+00 S.B. Lt. and 3205+00 NB Rt. Access to and from interchange ramps is provided at these points.
STAGE 1 CONSTRUCTION
WEATHERSFIELD-WINDSOR-HARTFORD
PROJECT
CONTRACT
Sheet 33 of

46