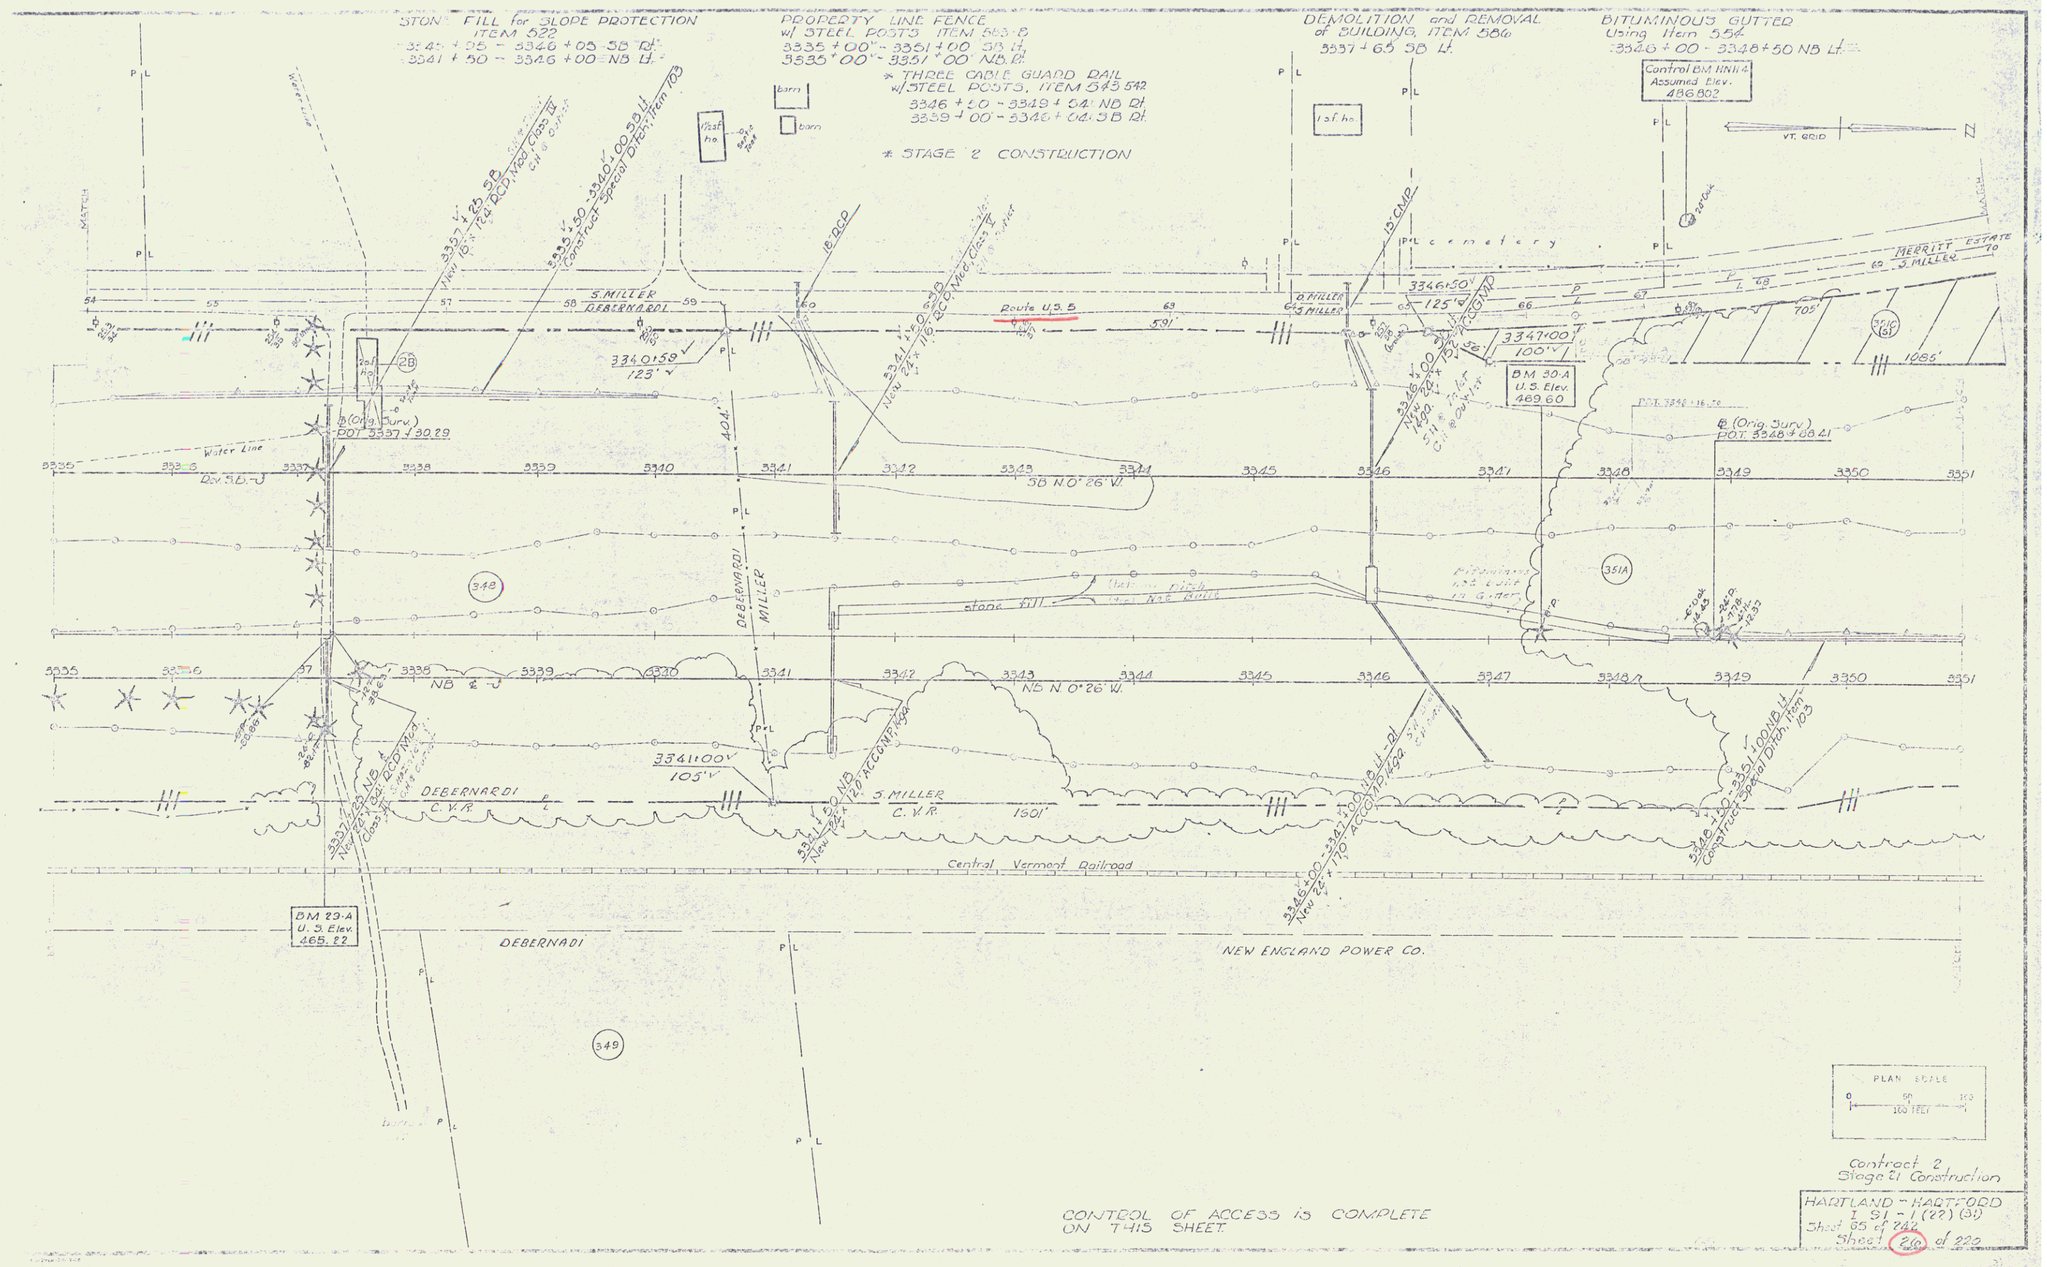
STONE FILL for SLOPE PROTECTION
ITEM 622
3341 + 05 - 3346 + 05 SB Rt.
3341 + 50 - 3346 + 00 NB Lt.
PROPERTY LINE FENCE
w/ STEEL POSTS ITEM 563-8
3335 + 00 - 3351 + 00 SB Lt.
3335 + 00 - 3351 + 00 NB Rt.
* THREE CABLE GUARD RAIL
w/ STEEL POSTS, ITEM 545.542
3346 + 20 - 3349 + 54 NB Rt.
3339 + 00 - 3346 + 04 SB Rt.
* STAGE 2 CONSTRUCTION
DEMOLITION and REMOVAL
of BUILDING, ITEM 586
3337 + 65 SB Lt.
BITUMINOUS GUTTER
Using Item 554
3346 + 00 - 3348 + 50 NB Lt.
Control BM NN14
Assumed Elev.
486.802
VT. GRID
S. MILLER
DEBERNARDI
Route U.S. 5
D. MILLER
S. MILLER
MERRITT ESTATE
S. MILLER
Cemetery
3341+00
100'
BM 30-A
U.S. Elev.
469.60
Water Line
Dev. SB-J
SB N 0° 26' W.
NB N 0° 26' W.
DEBERNARDI
MILLER
stone fill
DEBERNARDI
C.V.R.
S. MILLER
C.V.R.
Central Vermont Railroad
BM 29-A
U.S. Elev.
465.22
DEBERNADI
NEW ENGLAND POWER CO.
PLAN SCALE
0 50 100 FEET
Contract 2
Stage 2 Construction
HARTLAND - HARTFORD
I 91 - 1 (22) (31)
Sheet 65 of 242
CONTROL OF ACCESS IS COMPLETE
ON THIS SHEET