STONE FILL FOR ROCK FOUNDATION, ITEM 572
NB 3467+00 – 3470+00 RT

DEMOLITION AND REMOVAL OF BUILDING, ITEM 560
NB 3470+50 RT

BITUMINOUS CONCRETE CURB, ITEM 555
SB 3466+50 – 3467+50 LT
NB 3467+00 – 3469+00 RT

JUTE MATTING, ITEM 623
3463+00 – 3464+00 MED
3465+50 – 3468+50 MED
3470+00 – 3471+50 MED
3473+00 – 3475+00 MED
3477+00 – 3478+25 MED

DRILLING AND BLASTING OF SOLID ROCK SUBGRADE, ITEM 124
3477+50 – 3479+00

* TREATED TIMBER CURB, ITEM 556
NB 3472+00 – 3476+00 RT
SB 3472+96 – 3475+00 LT

* THREE CABLE GUARD RAIL WITH STEEL POSTS, ITEM 543.542
NORTHBOUND
3467+00 – 3468+00
3471+75 – 3478+15
SOUTHBOUND
3466+50 – 3467+85
3472+50 – 3476+72

PROPERTY LINE FENCE WITH STEEL POSTS, ITEM 583-0
NORTHBOUND
3465+00 – 3479+00
SOUTHBOUND
3463+00 – 3466+50
3468+50 – 3476+50

DRILLING AND PRESPLITTING OF SOLID ROCK, ITEM 125
NB 3478+00 – 3479+00' LT.
SB 3476+80 – 3479+00' RT.

List of Sheets for
P.C. Box @ sta. 3467+75
1 of 6 Plan and Section
2 of 6 General Notes, Details, & Summary of Quantities
3 of 6 Reinforcing Schedule
4-6 of 6 Chan. Line Sections
Reference Sheet
Standard Sheet S.B. 21-56

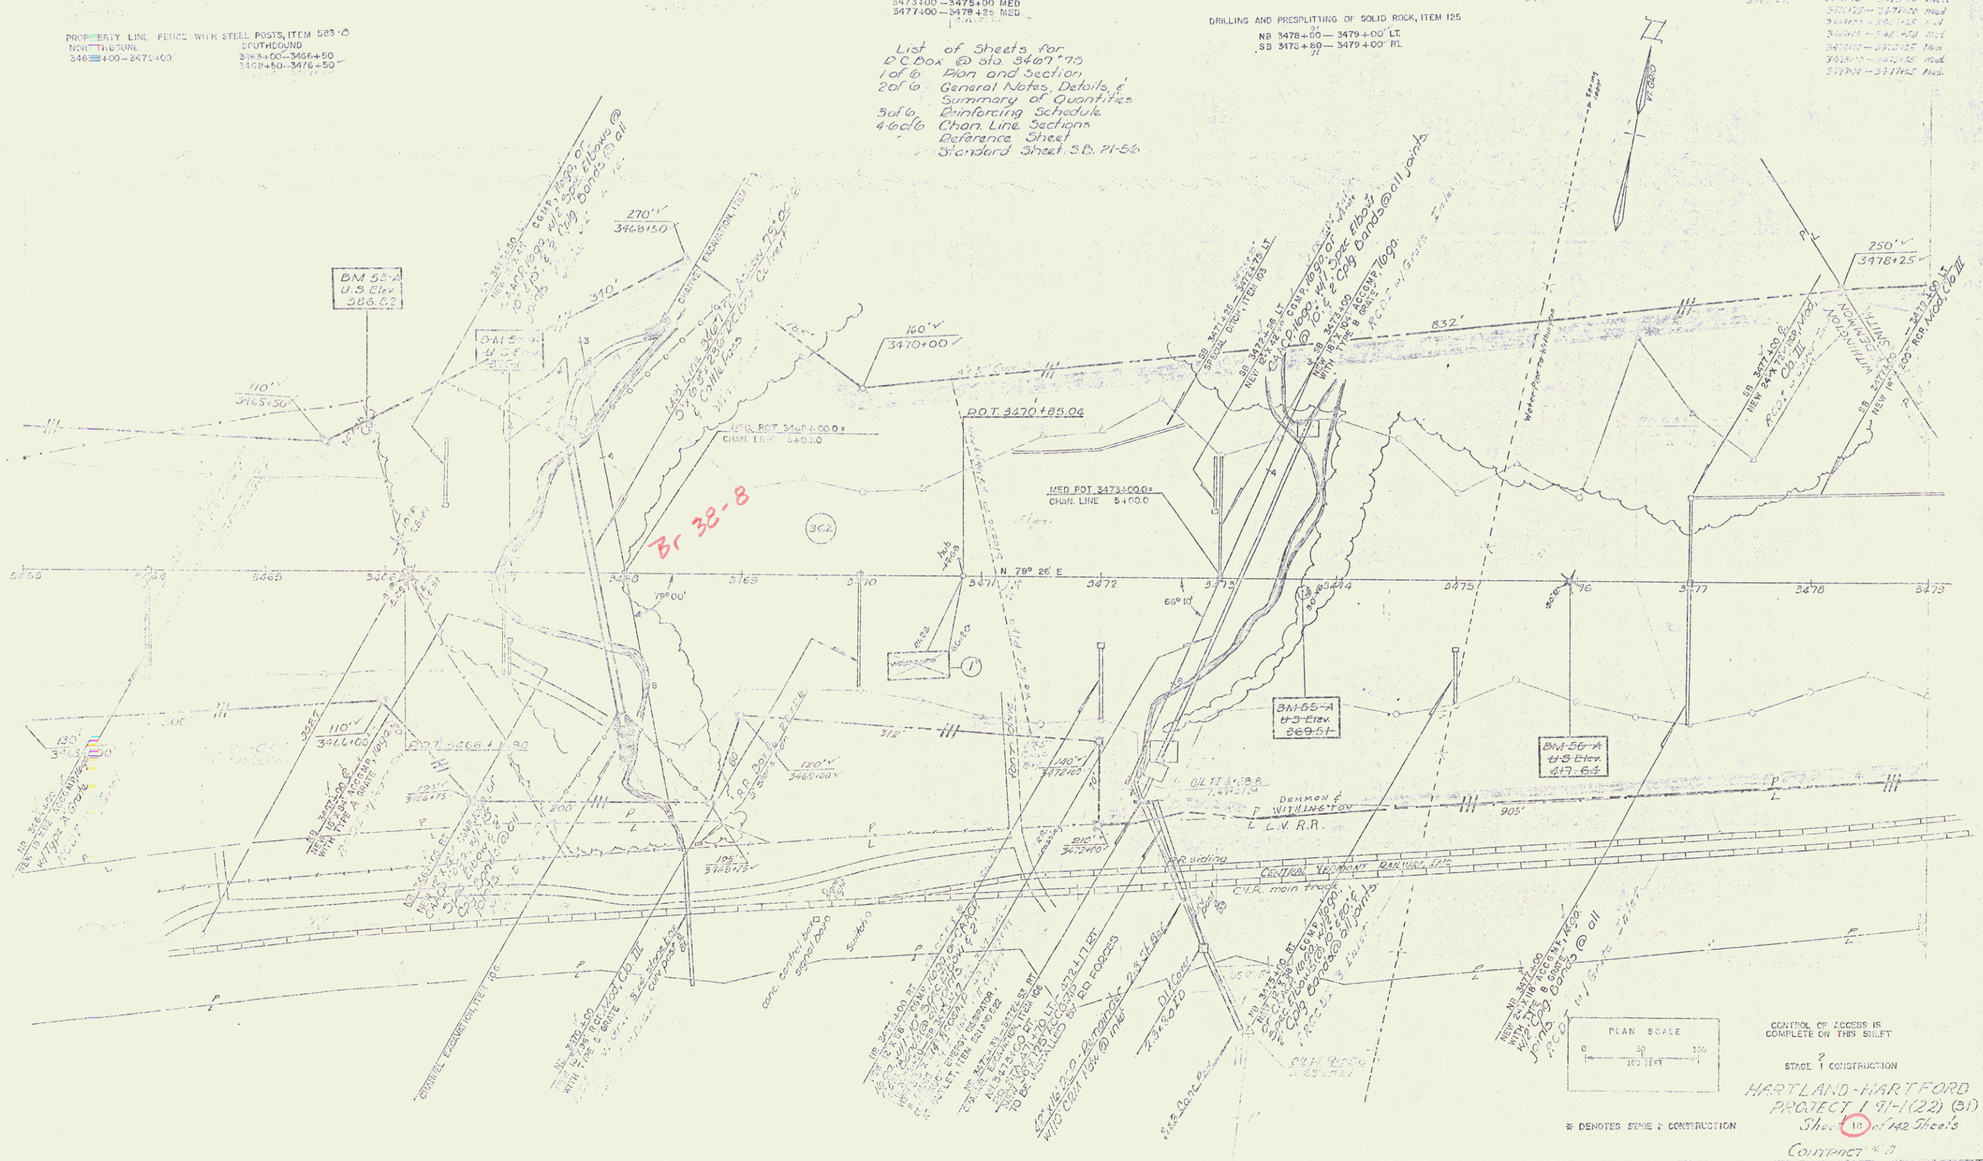

34