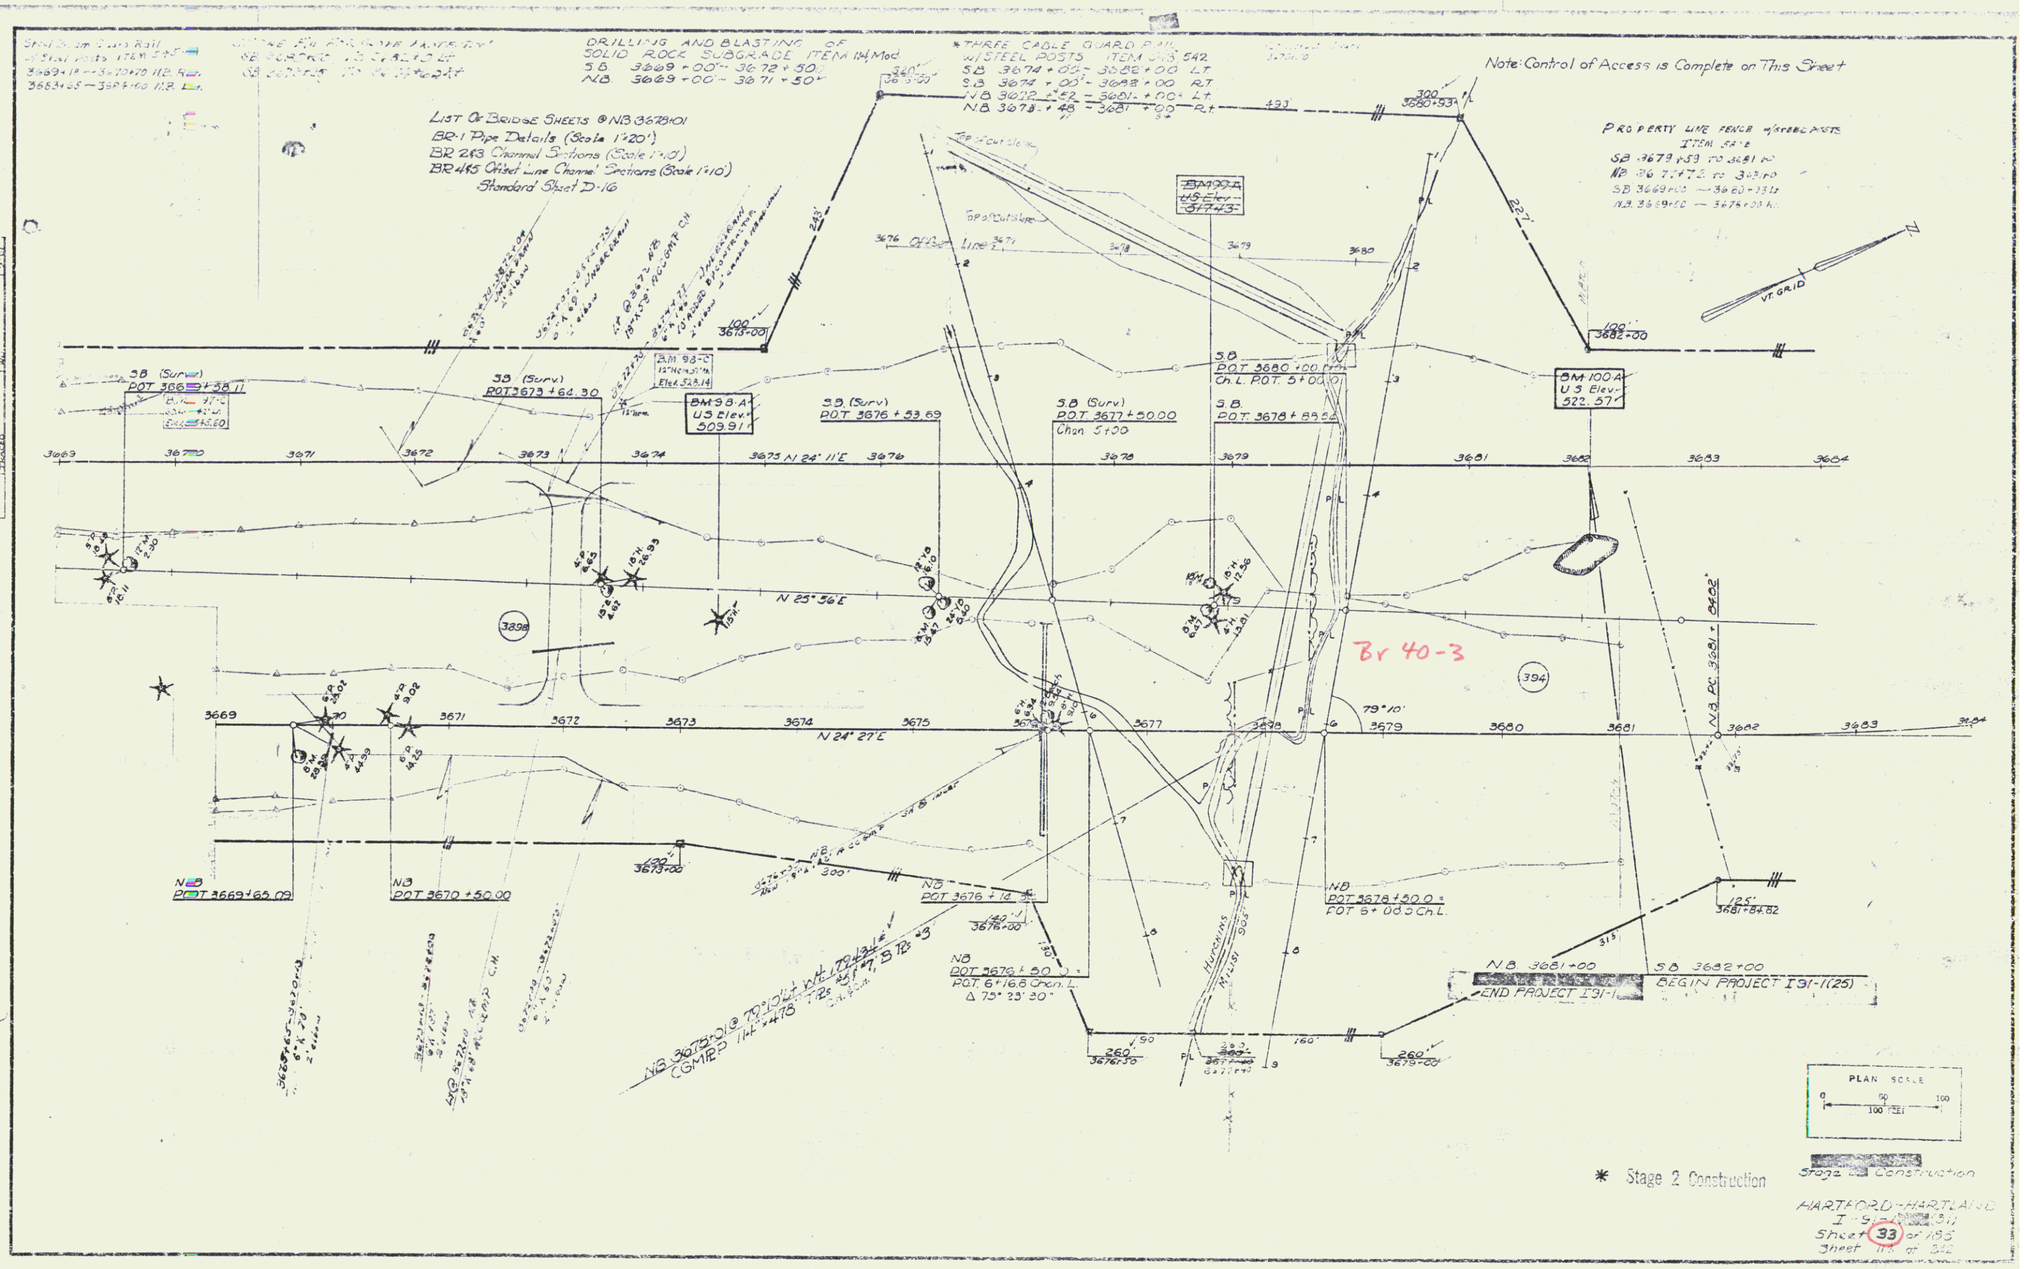
Note: Control of Access is Complete on This Sheet
DRILLING AND BLASTING OF SOLID ROCK SUBGRADE ITEM 144 Mod
S.B. 3669+00 - 3672+50
N.B. 3669+00 - 3671+50
* THREE CABLE GUARD RAIL W/STEEL POSTS ITEM 613 542
S.B. 3674+00 - 3682+00 LT
S.B. 3674+00 - 3682+00 RT
N.B. 3672+52 - 3681+00 LT
N.B. 3673+48 - 3681+00 RT
LIST OF BRIDGE SHEETS @ NB 3678+01
BR-1 Pipe Details (Scale 1"=20')
BR 2&3 Channel Sections (Scale 1"=10')
BR 4&5 Offset Line Channel Sections (Scale 1"=10')
Standard Sheet D-16
PROPERTY LINE FENCE W/BARBED WIRE ITEM 5[illegible]
S.B. 3679+53 TO 3681+00
N.B. 3677+72 TO 3681+00
S.B. 3669+00 — 3680+93
N.B. 3669+00 — 3676+03
VF GRID
BM 98-A US Elev. 509.91'
BM 100-A US Elev. 522.57'
S.B. POT 3669+65.09
S.B. POT 3673+64.30
S.B. POT 3676+53.69
S.B. POT 3677+50.00
Chan. 5+00
S.B. POT 3678+89.52
S.B. POT 3680+00 PTH
Ch. L. POT. 5+00.00
N 25° 56' E
N 24° 27' E
N 24° 11' E
79° 10'
N.B. POT 3669+65.09
N.B. POT 3670+50.00
N.B. POT 3676+12
N.B. POT 3678+50.0 ±
POT 5+00.0 Ch. L.
N.B. POT 3679+50.0 ±
POT 6+16.8 Chan. L.
Δ 73° 23' 30"
N.B. 3681+00
S.B. 3682+00
END PROJECT I91-1
BEGIN PROJECT I91-1(25)
Br 40-3
PLAN SCALE
Stage 2 Construction
* Stage 2 Construction
HARTFORD-HARTLAND
I-91
Sheet 33 of 185
Sheet 11 of 34