

• BITUMINOUS CONCRETE GUTTER ITEM 554  
 S.B. 3694+71.52 - NB 3695+00 Lt  
 3701+50 S.B. 371 - NB Lt  
 3721+00 - NB Rt  
 3732+00 - NB Rt  
 3691+50 - NB Rt

• THREE CABLE GUARD-RAIL w/ STEEL POSTS ITEM 542  
 NB 3700+04 - 3701+88 Rt  
 S.B. 3701+25 - 3701+91 Lt  
 NB 3700+06 - 3702+00 Lt

PROPERTY LINE FENCE w/ STEEL POSTS, ITEM 583-B  
 S.B. 3690+00 - 3695+67 Lt  
 Ramp D' 7+00 - 10+00 Lt  
 (The above stationing fence is to be erected prior to the commencement of construction)  
 Ramp E' 14+00 - 16+25 Rt S.B. Lt

• GRANITE SLOPE EDGING-ITEM 556-A  
 Ramp E' 17+00 - 17+37 Lt


DRILLING & BLASTING OF SOLID ROCK SUBGRADE, ITEM 114  
 S.B. 3692+10 - 3702+00  
 NB 3695+85 - 3702+00  
 Ramp E' 17+00 - 24+00  
 13+24


• STANDARD STEEL BEAM GUARD RAIL w/ STEEL POSTS ITEM 545-A  
 S.B. 3701+99 - 3702+00 -  
 S.B. 3702+00 Rt - NB 3702+00 Lt

Rev. S.B. Curve #1  
 Δ 21° 56' 40" Lt  
 D 2'  
 T 555.42  
 L 1097.22  
 E 52.37  
 Bank 1/4% per ft.

NB CURVE #1  
 Δ 22° 12' 20" Lt  
 D 2' 00"  
 R 2864.79  
 T 562.19  
 L 1110.28  
 E 54.24  
 Bank 1/4% per ft.

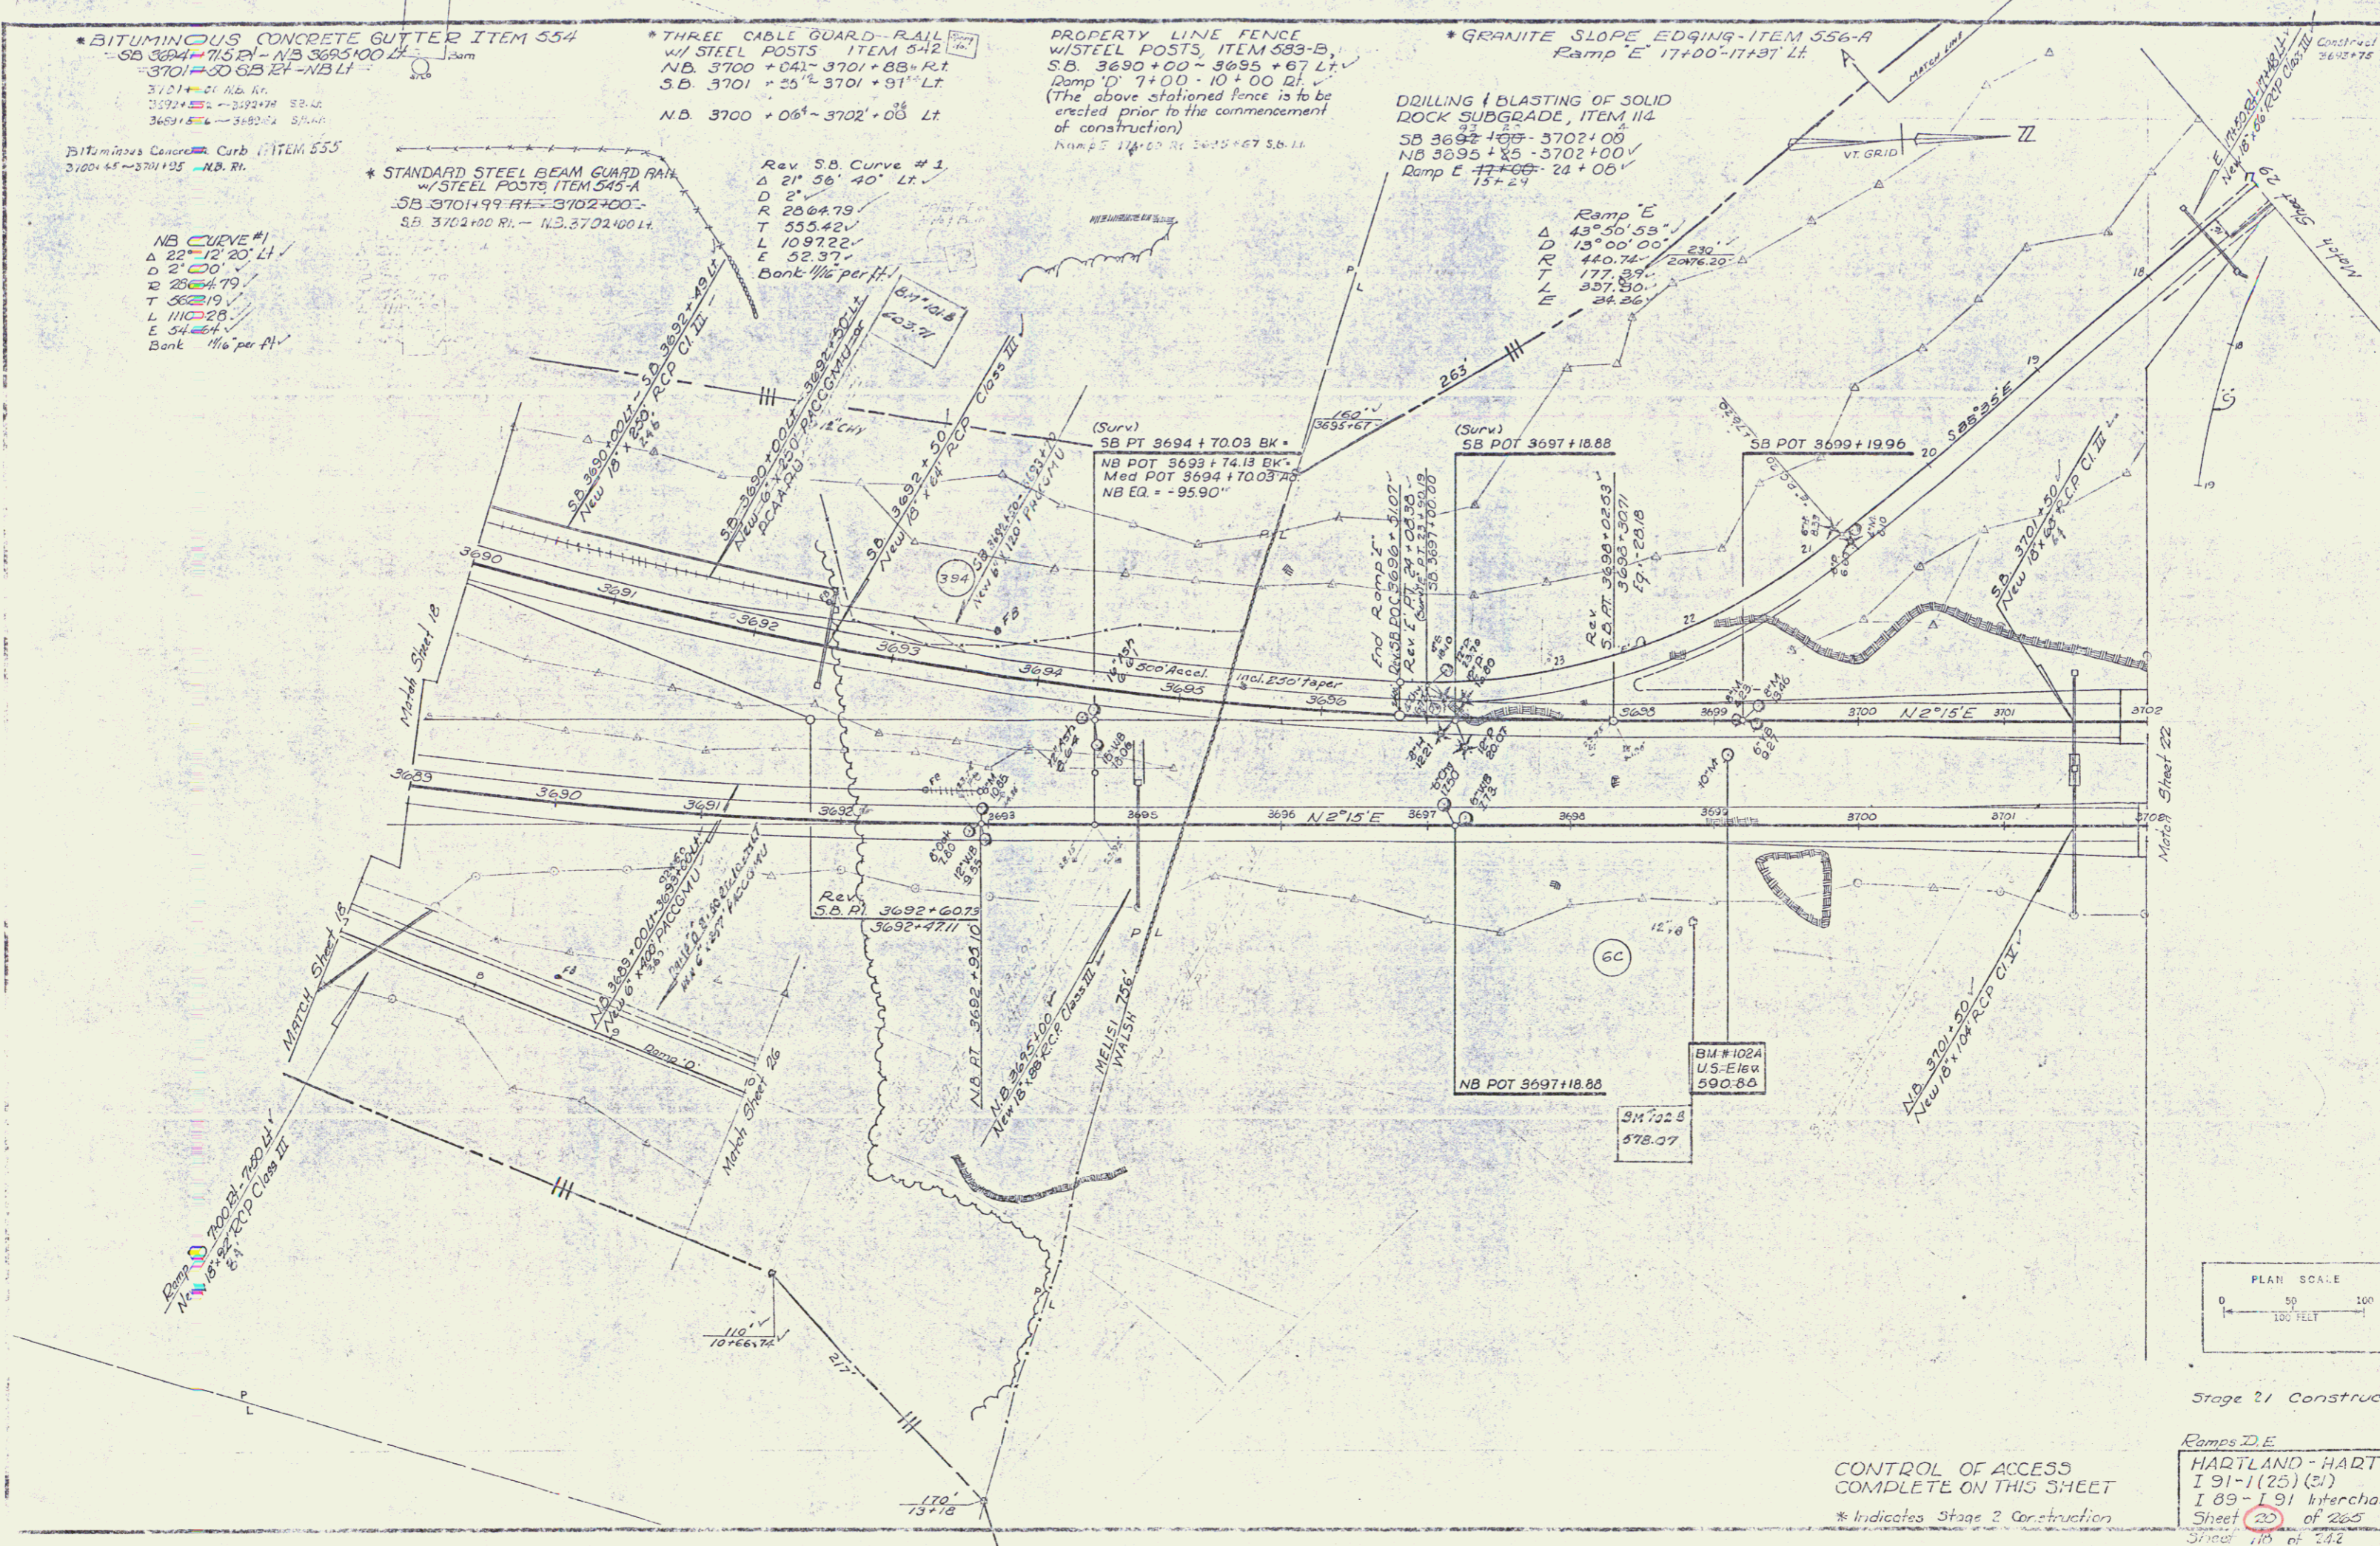

Stage 21 Construction

CONTROL OF ACCESS  
 COMPLETE ON THIS SHEET  
 \* Indicates Stage 2 Construction

Ramps D, E  
 HARTLAND - HARTFORD  
 I 91 - I (25) (21)  
 I 89 - I 91 Interchange  
 Sheet 20 of 265  
 Sheet 115 of 142