
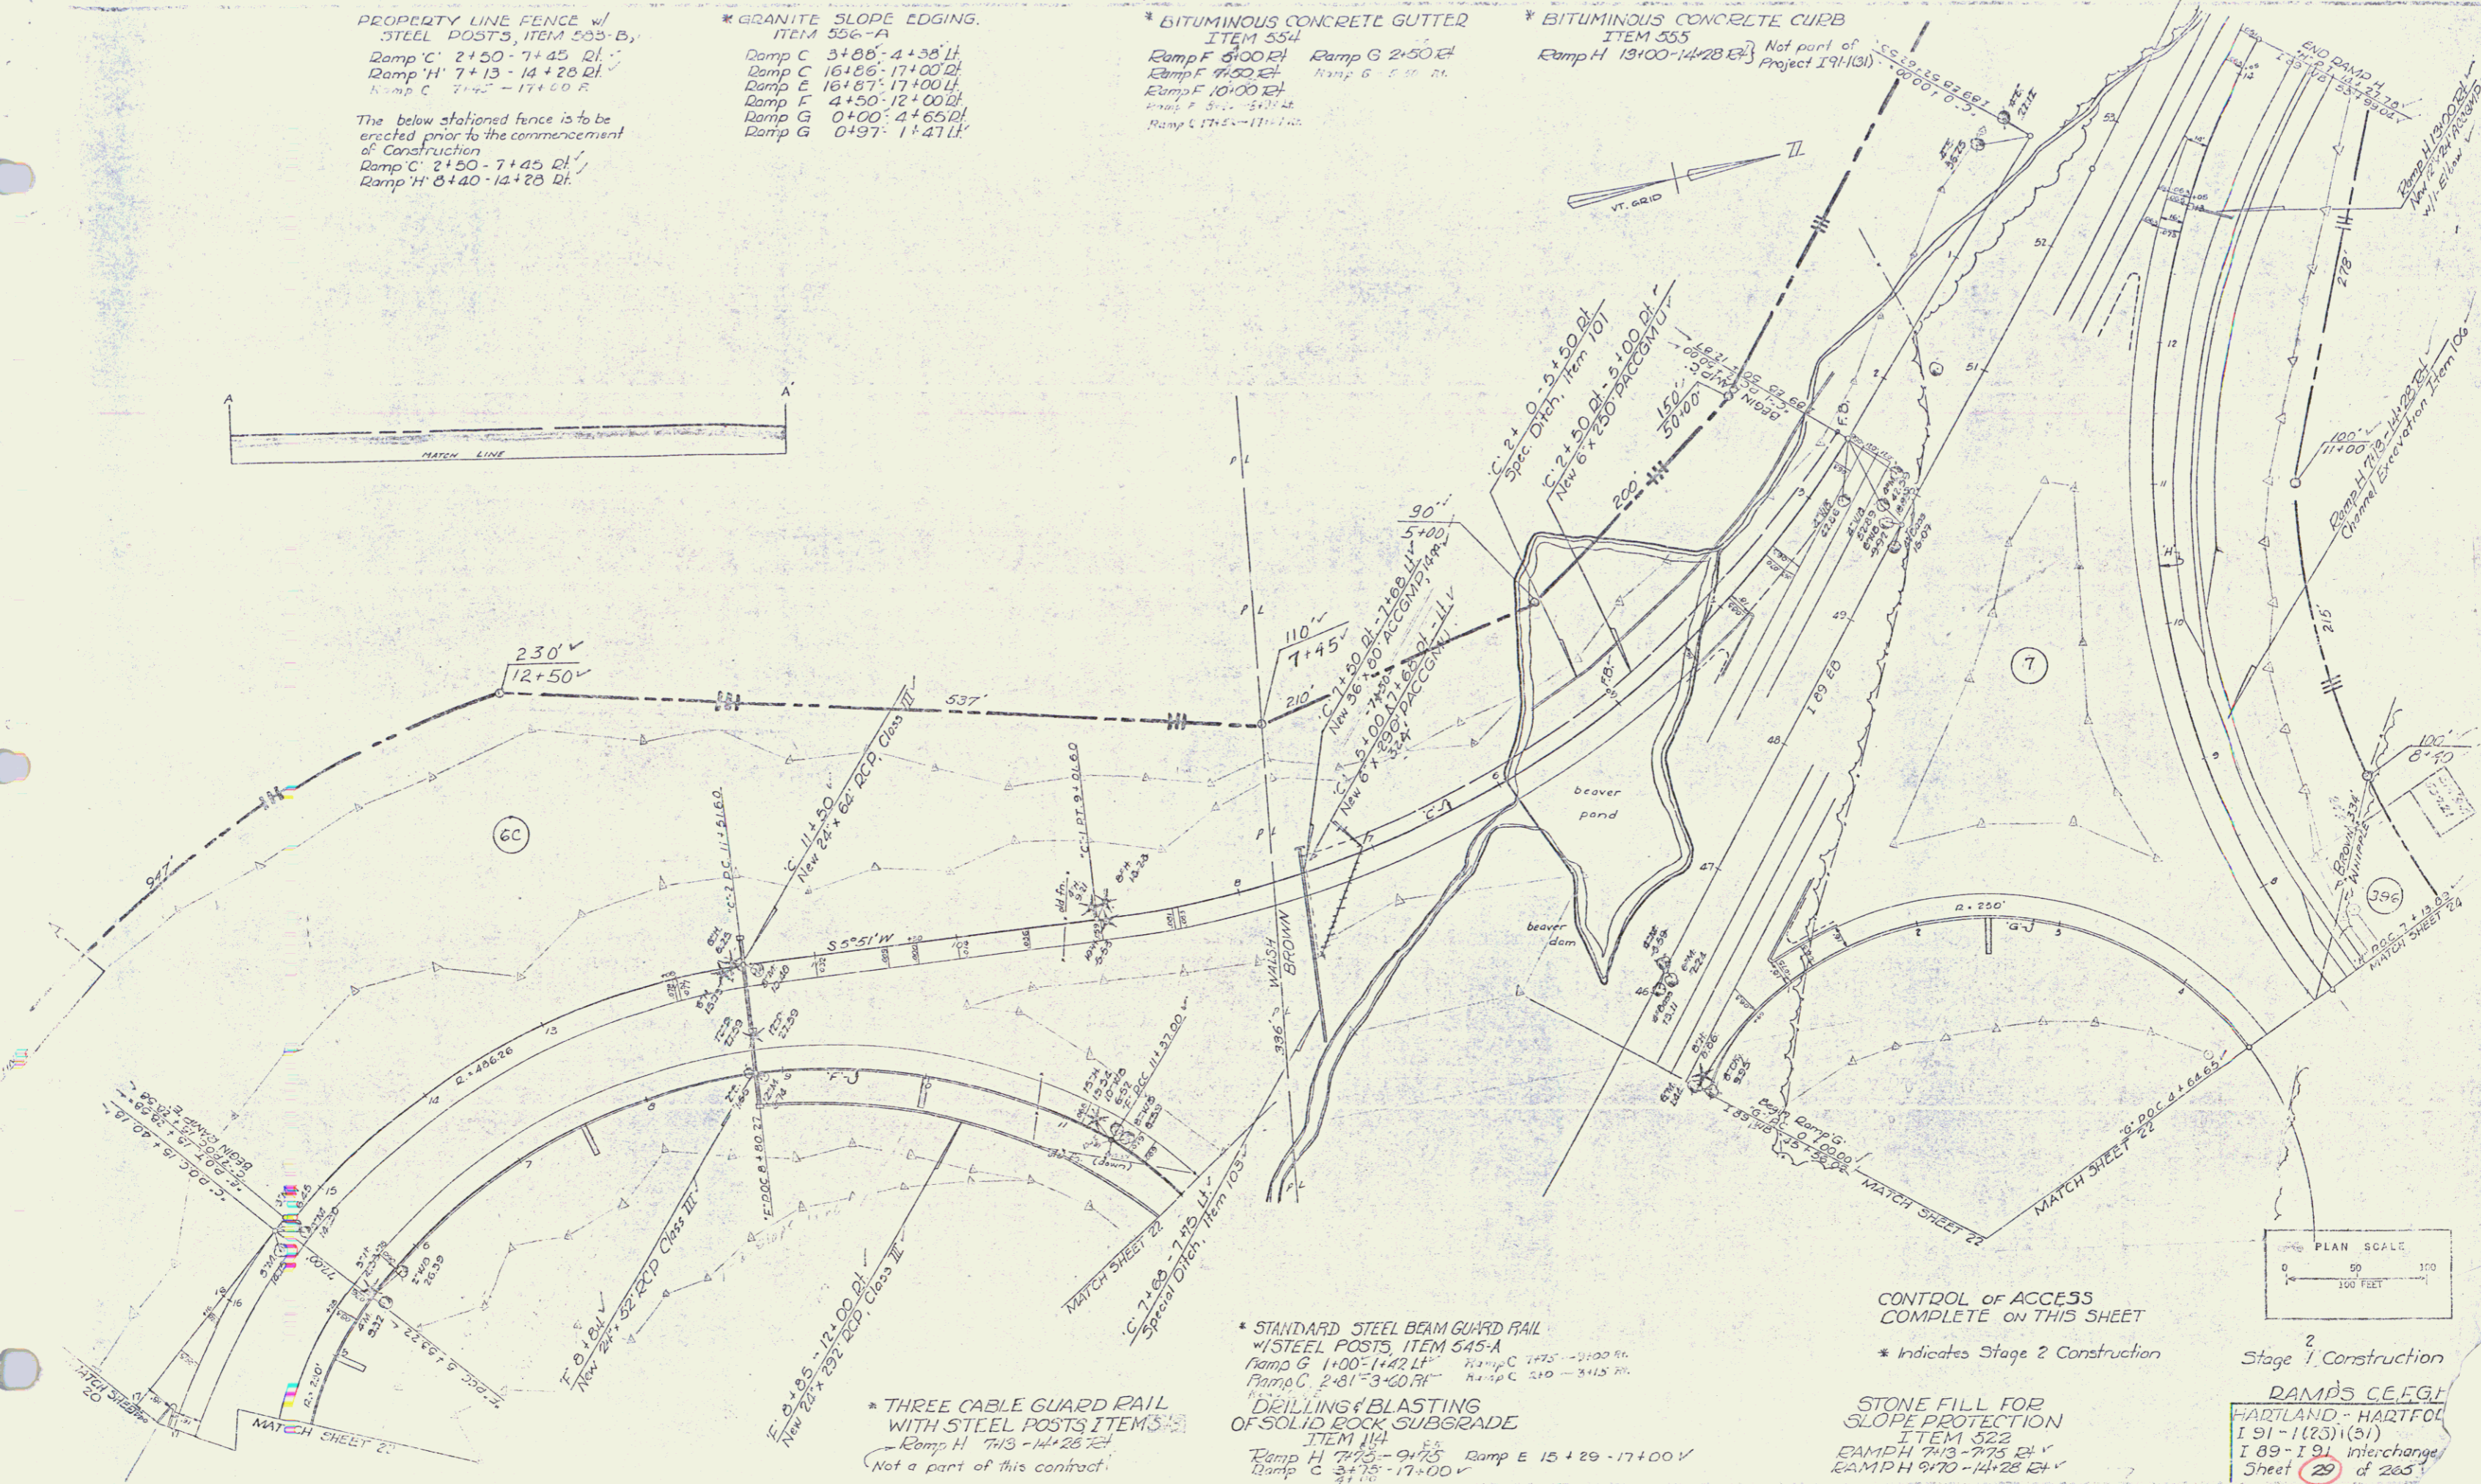
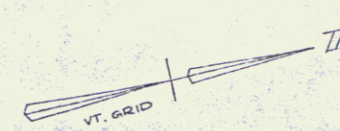


PROPERTY LINE FENCE w/  
STEEL POSTS, ITEM 555-B,  
Ramp C' 2+50 - 7+45 D.L.  
Ramp H' 7+13 - 14+28 D.L.  
Ramp C' 7+45 - 17+00 R.  
The below stationed fence is to be  
erected prior to the commencement  
of construction  
Ramp C' 2+50 - 7+45 D.L.  
Ramp H' 8+40 - 14+28 D.L.

\* GRANITE SLOPE EDGING,  
ITEM 556-A  
Ramp C 3+88 - 4+38 D.L.  
Ramp C 16+86 - 17+00 D.L.  
Ramp E 16+87 - 17+00 D.L.  
Ramp F 4+50 - 12+00 D.L.  
Ramp G 0+00 - 4+65 D.L.  
Ramp G 0+37 - 1+47 D.L.

\* BITUMINOUS CONCRETE GUTTER  
ITEM 554  
Ramp F 6+00 D.L. Ramp G 2+50 D.L.  
Ramp F 7+50 D.L. Ramp G 2+50 D.L.  
Ramp F 10+00 D.L. Ramp G 2+50 D.L.  
Ramp F 8+15 - 8+15 D.L.  
Ramp G 17+15 - 17+15 D.L.


\* BITUMINOUS CONCRETE CURB  
ITEM 555  
Ramp H 13+00 - 14+28 D.L. Not part of  
Project I 91-103  
0+00 - 0+50

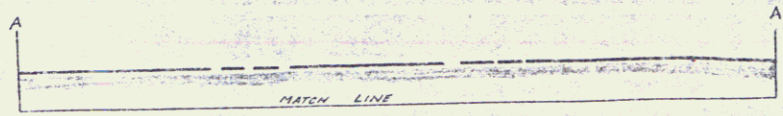

\* THREE CABLE GUARD RAIL  
WITH STEEL POSTS ITEMS  
Ramp H 7+13 - 14+28 D.L.  
Not a part of this contract.

\* STANDARD STEEL BEAM GUARD RAIL  
WITH STEEL POSTS, ITEM 545-A  
Ramp G 1+00 - 1+42 D.L. Ramp C 2+75 - 3+00 D.L.  
Ramp C 2+81 - 3+40 D.L. Ramp C 2+10 - 3+15 D.L.  
\* DRILLING & BLASTING  
OF SOLID ROCK SUBGRADE  
ITEM 114  
Ramp H 7+15 - 9+75 Ramp E 15+29 - 17+00 V.  
Ramp C 3+15 - 17+00 V.

CONTROL OF ACCESS  
COMPLETE ON THIS SHEET  
\* Indicates Stage 2 Construction

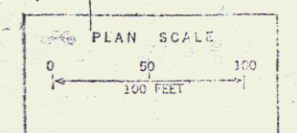

Stage 2 Construction  
DAMPS C.E.F.G.I.  
HARTLAND - HARTFOL  
I 91 - I 203 (21)  
I 89 - I 91 interchange  
Sheet 29 of 265  
Sheet 12 of 242

61