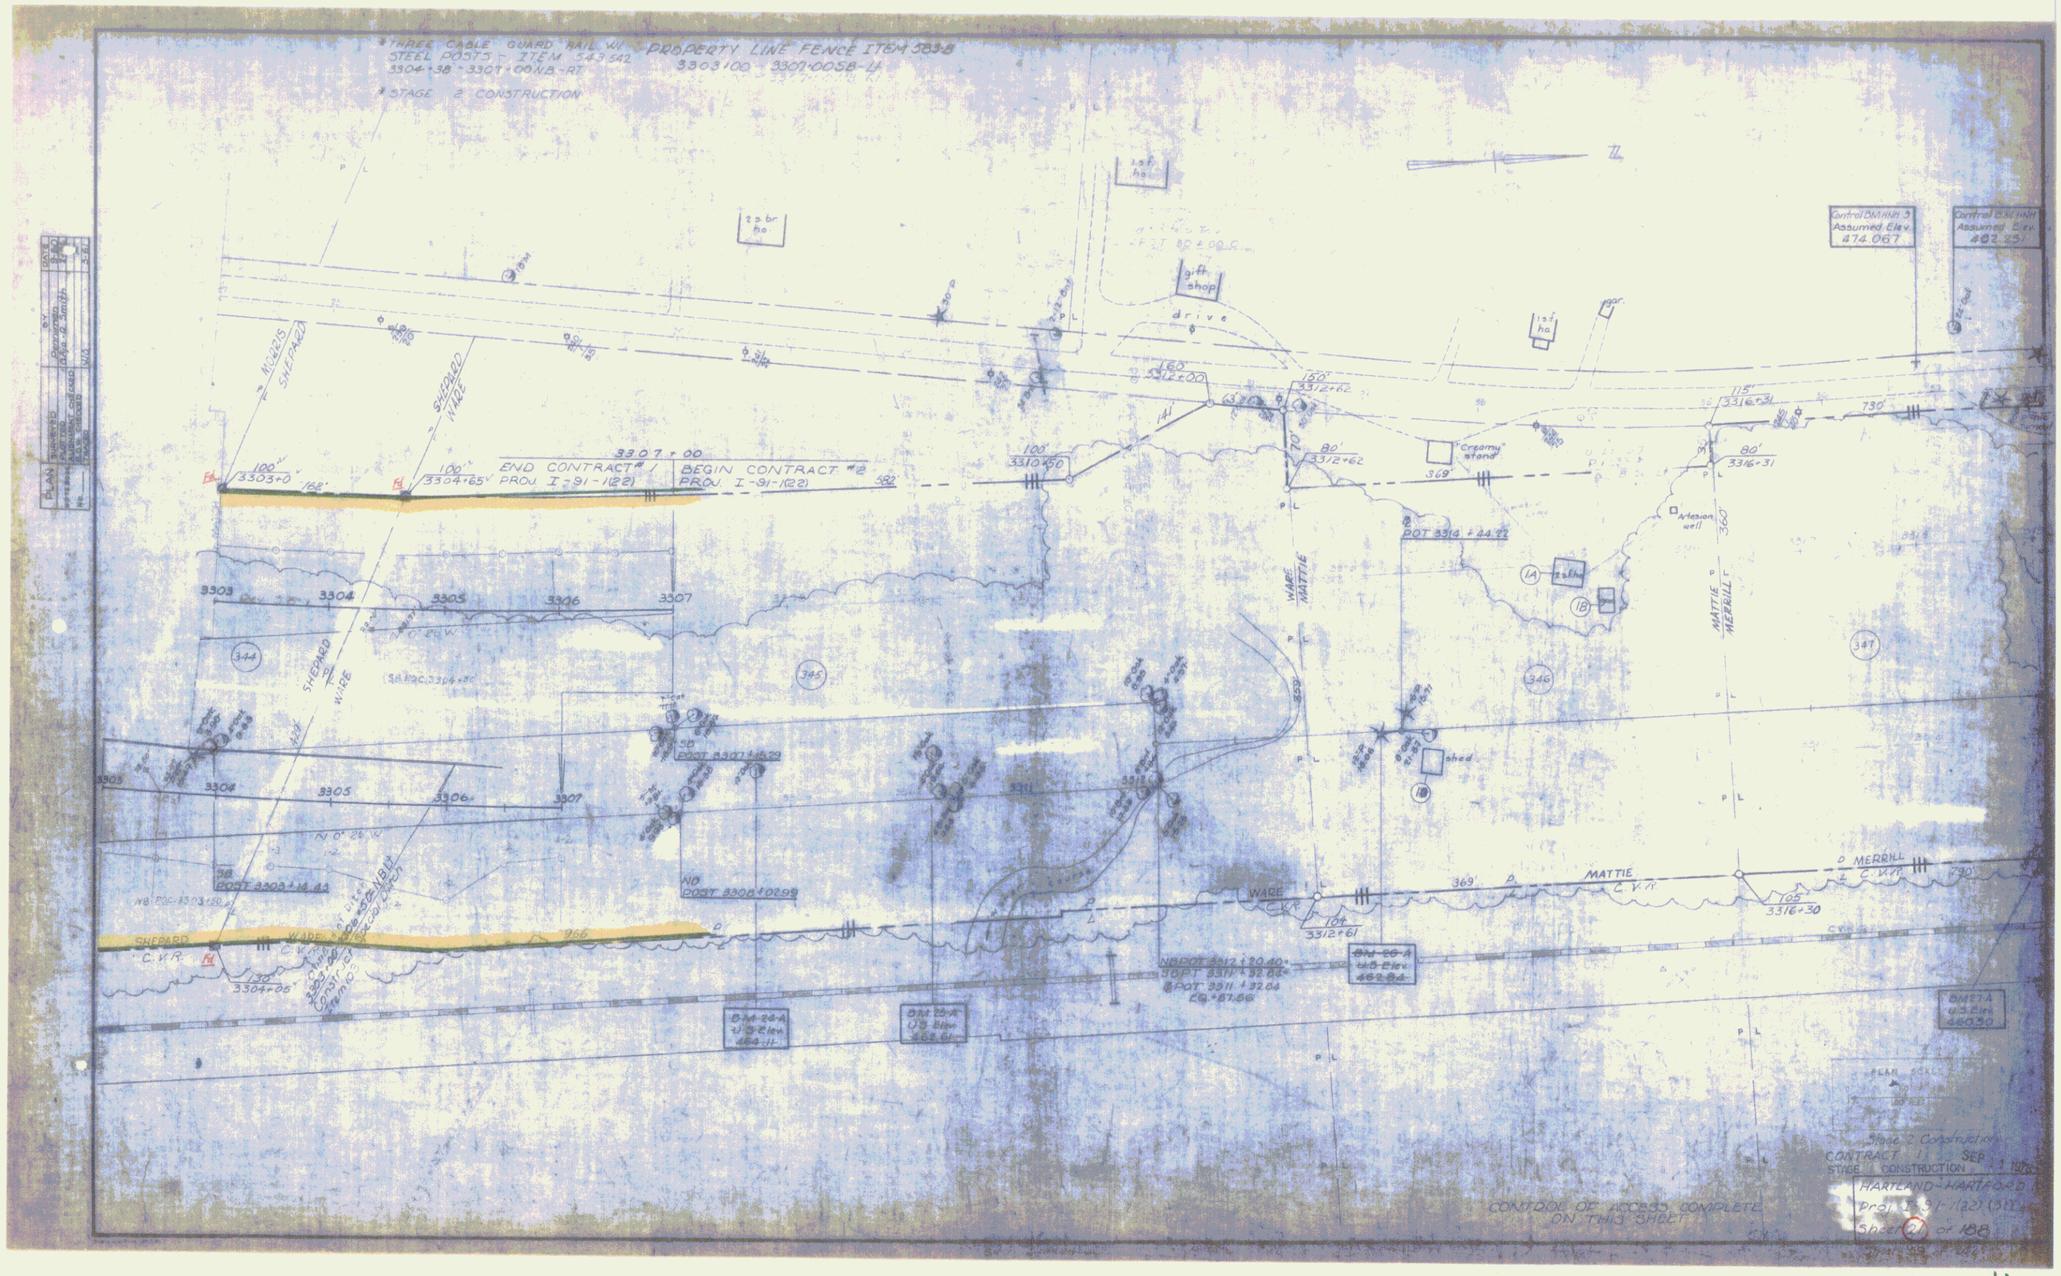
THREE CABLE GUARD RAIL W/ STEEL POSTS ITEM 543.542
3304+38 - 3307+00 N.B.-RT
PROPERTY LINE FENCE ITEM 383.8
3303+00 - 3307+00 SB-LT
STAGE 2 CONSTRUCTION
END CONTRACT #1 PROJ. I-91-1(22)
BEGIN CONTRACT #2 PROJ. I-91-1(22)
3307+00
Control BM 1481.3 Assumed Elev. 474.067
Control BM 1481.4 Assumed Elev. 482.251
gift shop
drive
"Creamy" stand
Artesian well
shed
WARE
MATTIE
MERRILL
SHEPARD
C.V.R.
POST 3314+24.22
NB POST 3303+00.29
NB POST 3306+02.99
NB POST 3307+15.29
NB POST 3309+14.43
NB POST 3312+20.40
SB POST 3311+32.01
SB POST 3311+32.04
EQ +57.56
BM 24-A
BM 25-A
BM 26-A
BM 27-A
CONTROL OF ACCESS COMPLETE ON THIS SHEET
Stage 2 Construction
CONTRACT
STAGE 1 CONSTRUCTION
SEP 1 1 1976
HARTLAND-HARTFORD
Proj. I-91-1(22)(31)
Sheet 21 of 188

14A