STATE OF VERMONT
DEPARTMENT OF HIGHWAYS

PROPOSED IMPROVEMENT

INTERSTATE PROJECT

TOWNS OF HARTLAND-HARTFORD

COUNTY OF WINDSOR
INTERSTATE ROUTE 91
BELLOWS FALLS-WHITE RIVER JCT. ROAD

CONTRACT # 2

BEGINNING AT A POINT 2.352 MILES NORTH OF THE WINDSOR-HARTLAND TOWN LINE AND EXTENDING NORTHERLY 2.240 MILES

LENGTH OF ROADWAY (CONTRACT) 11,829.32 FEET = 2.240 MILES

ADT (1985) =	3500
ADT (1985)	8060
DHV (1985)	1160
D	51 %
T	7 %
V	60 MPH

= LIMITED ACCESS PURCHASE.
= NON LIMITED ACCESS PURCHASE.
= AS BUILT RIGHT OF WAY FENCE.

INDEX OF SHEETS

SHEET NO.		
1		Title Page
2		Alignment Sheet
3		Typical Cross Section
4		1" = 20' Detail Sheets
5-12		Quantity Sheet - Items
13-16		Item Detail and Drainage Sheets
16a-16i		Earthworks
22-49		Plan & Profiles
49	BR	00 General Plan and Elevation U.S.#5 over 91
49a	BR	01 Quantity Sheet
50	BR	02 Profiles & Typicals
49a-50	BR	03-4 Auger Borings
51	BR	05 Casing Borings
49	BR	06 Framing Plan
49	BR	07 Typical Section, Rail and Granite Curb Lengths
50	BR	08 Details of Abutment No. 1
51	BR	09 Details of Abutment No. 2 Exposed End
51a	BR	10 Details of Abutment No. 2 Wing Walls
53	BR	11 Pier No. 1 Layout Details
54	BR	12 Pier No. 1 Reinforcing Steel
55	BR	13 Pier No. 2 Layout Details
56	BR	14 Pier No. 2 Reinforcing Steel
57	BR	15 Pier No. 3 Layout Details
58-59		Blank
60	BR	16 Pier No. 3 Reinforcing Steel
61	BR	17 Pier No. 4 Layout Details
62	BR	18 Pier No. 4 Reinforcing Steel
63	BR	19 Details of Approach Slab #1
64	BR	20 Details of Approach Slab #2
65-66	BR	21-2 Reinforcing Steel Schedule
67	SH	1 Plan and Elevation Cover Bridge
68	SH	2 Roofing Lay
69	SCB	24C-1
70	SCB	30-92
71	SCB	01-82
72	SCB	02-82 Details A,B,C
73	SCB	03-82 Details A,B,C,D,E
74	SCB	04-82
75	SCB	05-82
76	SCB	06-82 Details A,B,D,E
77	SCB	07-82 Details A,B,C,D
78	SCB	08-82 Detail A
79	SCB	08-82 Detail A
80-81	SB	58-82 Sheet 1 & 2
82	4-81	Typical for Slopes in Solid Rock Excavation-Drilling & Blasting of Solid Rock Subgrade
83a	4-1	Benching Ledge
83b	6-5	Slope Grading, etc.
83c	5-8	Rock Excavation
83d	5-10	Embankment of Slopes
83e	5-11	Underdrain & Slope Stabilization
84	2-1	Curbs
85	D-2	CBN-Headwalls & Underdrain
86	D-3	Jute Matting & Treated Gutters
87	D-4	Metal End Sections-Metal Elbows, etc.
88	SB	SCB's
89	6-13	Details of Grates and Covers
89a	6-13	Conc. Catch Basins
90	6-16	PRC Curb Dl's
91	6-17	Vertical Risers
92	6-1	Barricades, Signs, etc.
93	6-31	Federal Aid Construction Identification Sign
94	7-1	Property Line Fence
95-95a	G-26&2a	Two Cable Guard Rail
96-96a	G-26&a	Three Cable Guard Rail
97	8-4	Wood and Steel Marker Posts
98	8-1	Project Markers, Boundary Markers
99		Blank
100-208		Mainline Cross Sections
209-211		T.H. 178 Cross Sections
212-228		U.S. #5 Cross Sections

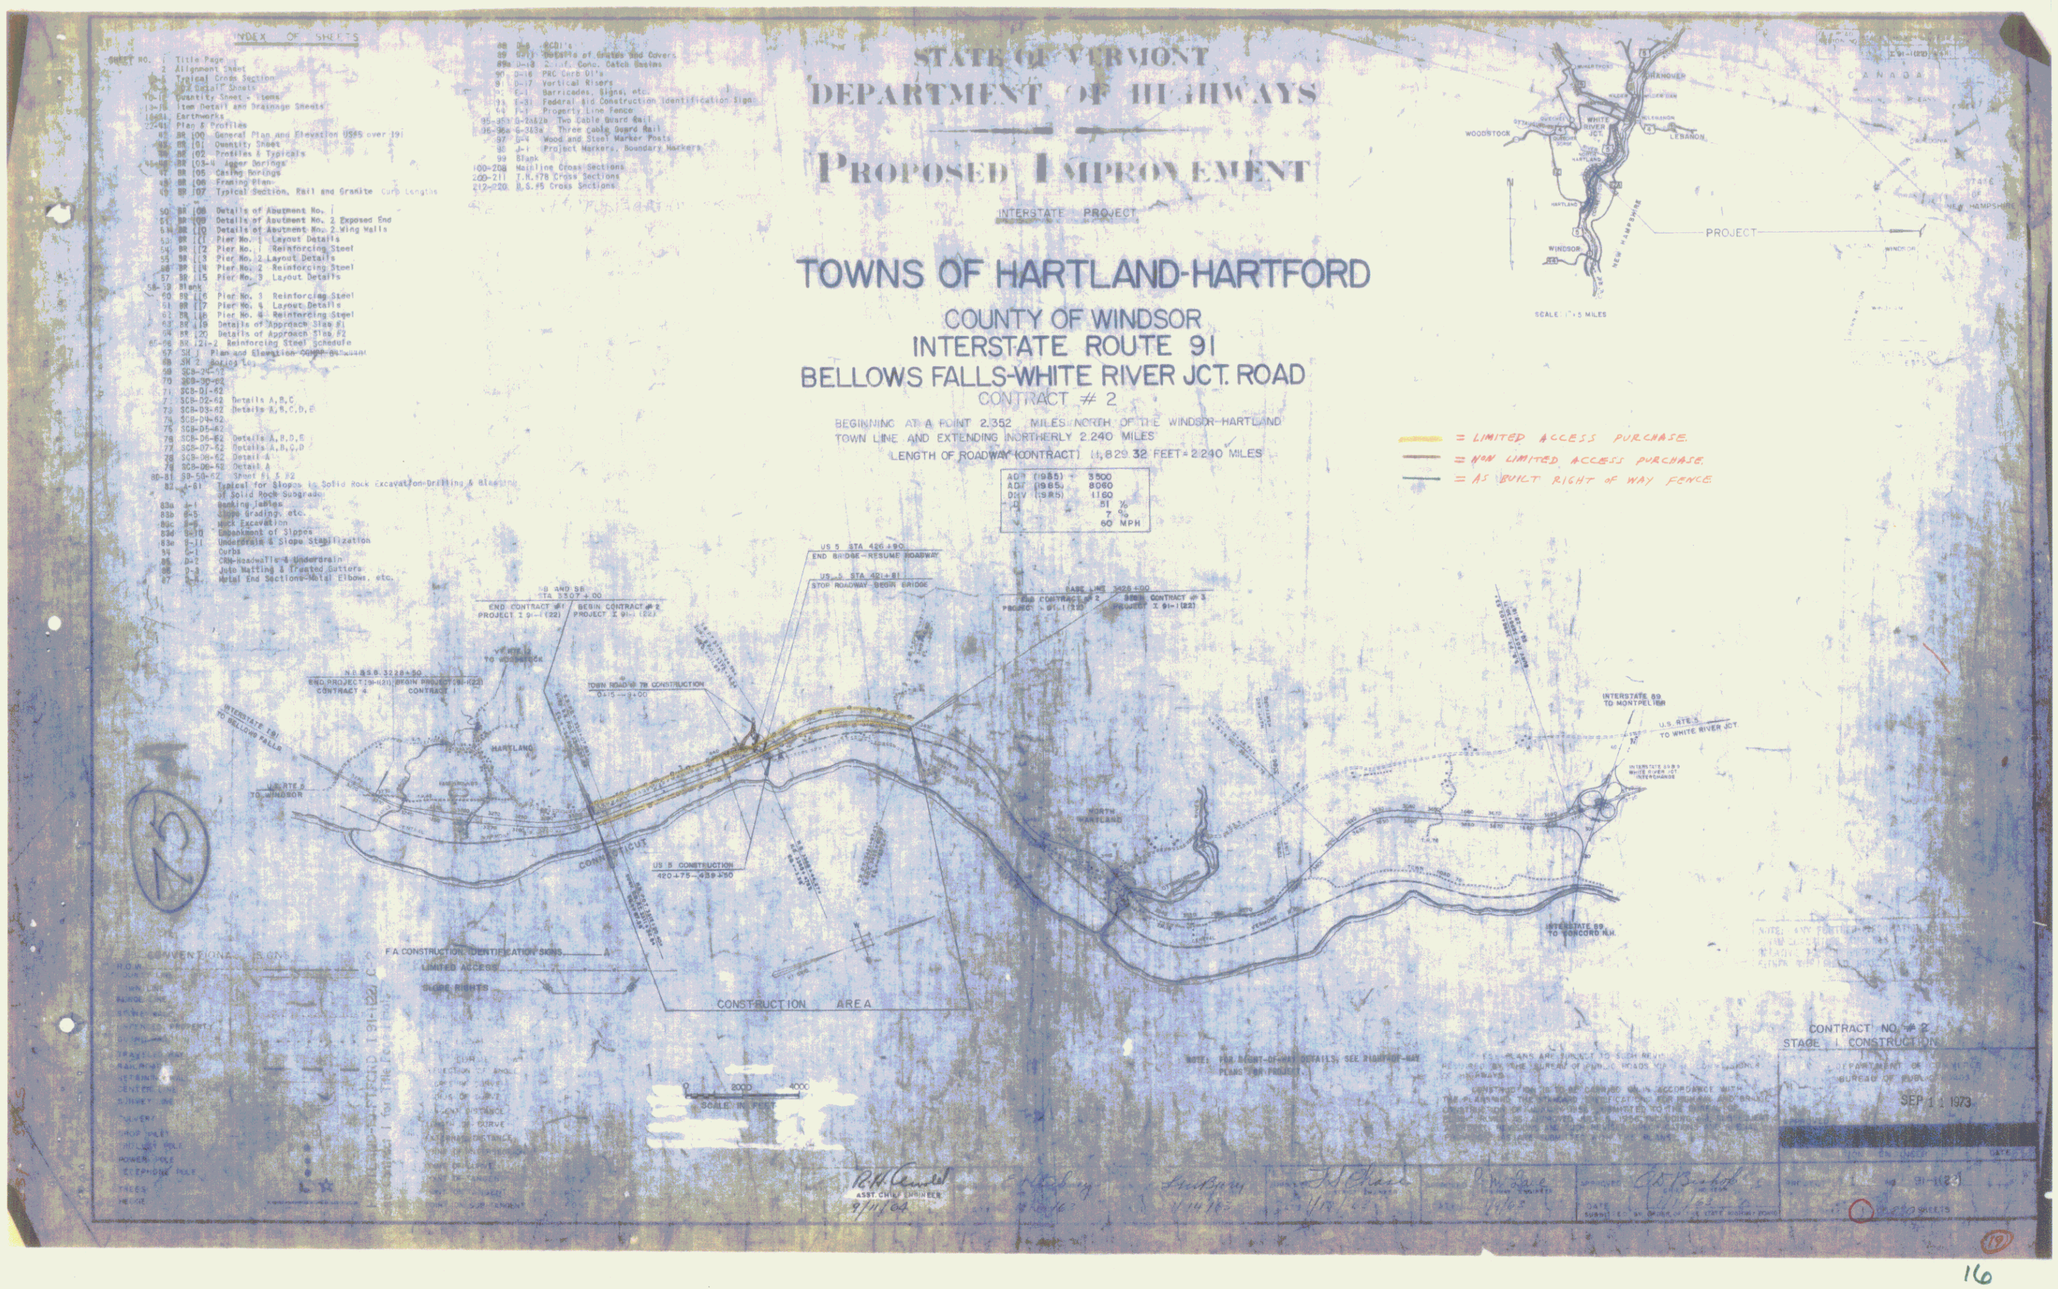

16