


w/STEEL POSTS, ITEM 583-B
NB 3307+00-3311+66 (ahead) DI

* STAGE 2 CONSTRUCTION

PROPERTY LINE FENCE
w/STEEL POSTS, ITEM 583-B
SB 3307+00'- 3319+00' L
NB 3307+00'- 3319+00' R
SB Curve Data NB Curve Data
Δ 27° 45' 00" L Δ 25° 53' 31" L
D 1' D 1'
R 5729.58 R 5728.56
T 1415.20 T 1304.81
L 2774.86 L 2345.66
E 172.17 E 146.58
Cnt. 3/4" Cnt. 3/4"

JUTE MATTING, ITEM 623
NB 3312+55- 3313+45 7L

DEMOLITION and REMOVAL of
BUILDING, ITEM 586
NB 3313+70

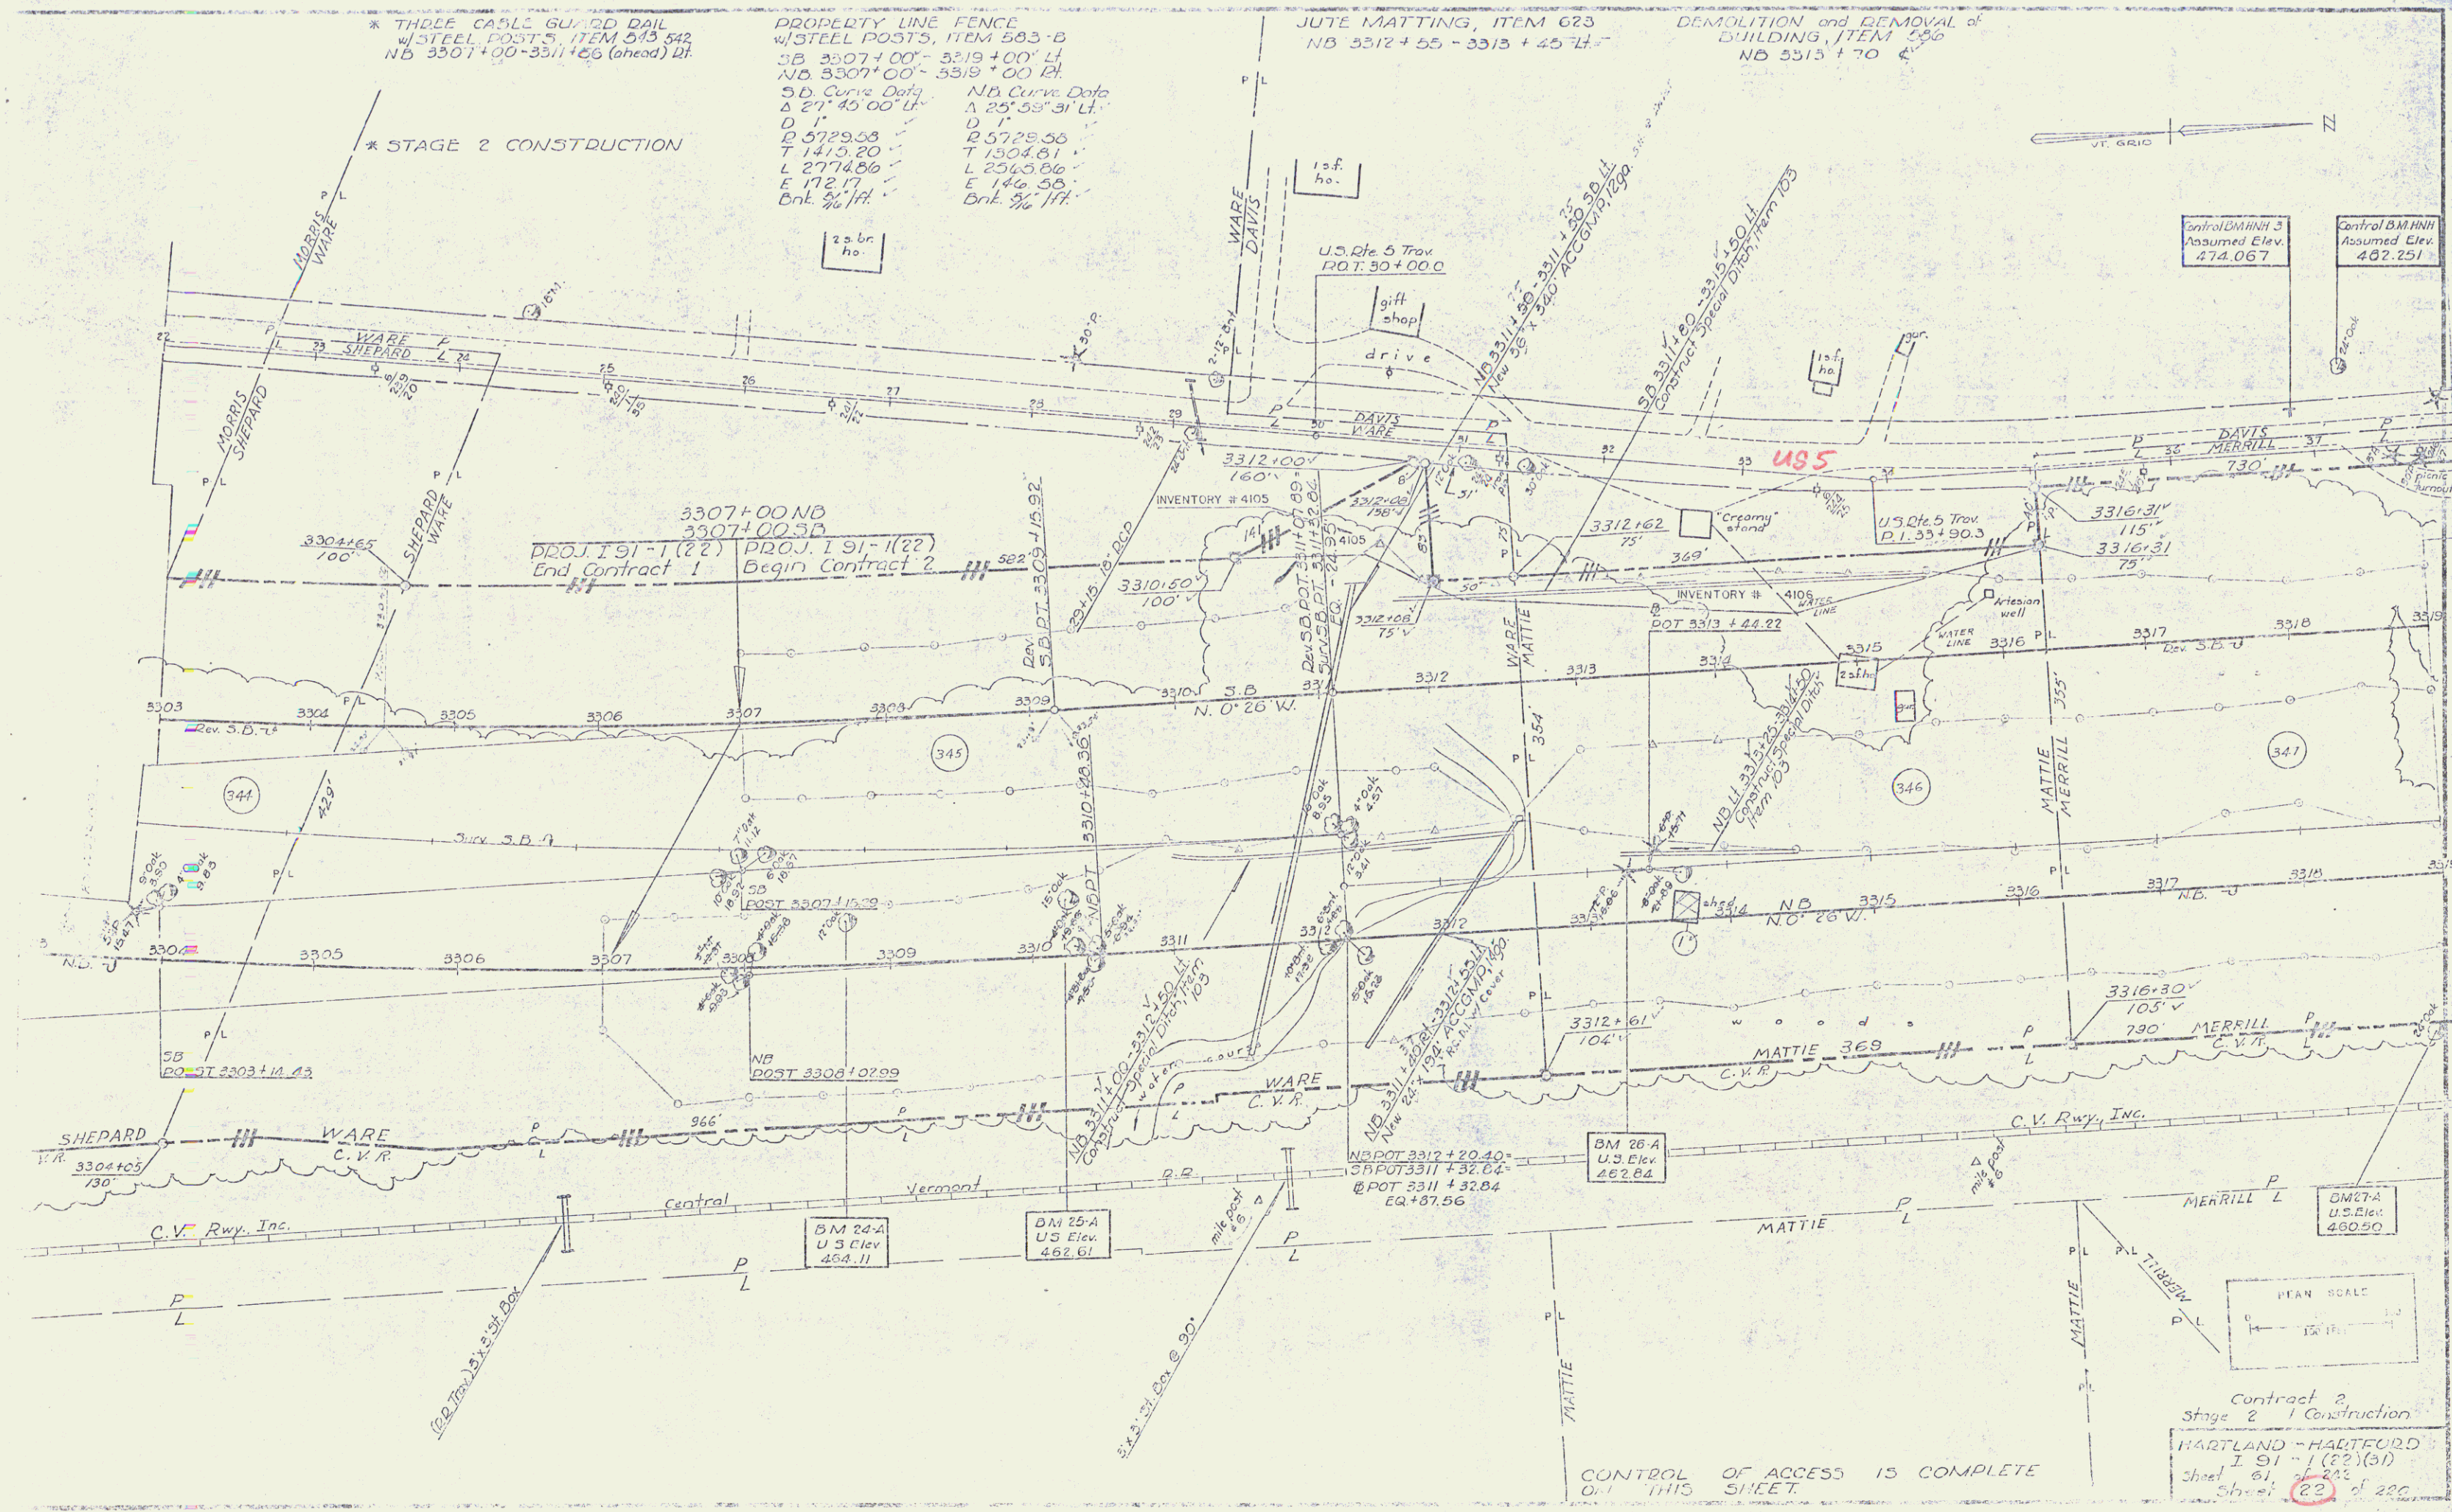


Assumed Elev.
474.067

Assumed Elev.
462.251

BM 26-A
U.S. Elev.
462.84

BM 27-A
U.S. Elev.

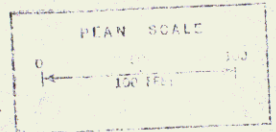

Contract 2
Stage 2 Construction
HARTLAND - HARTFORD
I 91-1(22)(31)
Sheet 61 of 222
Sheet 22 of 222