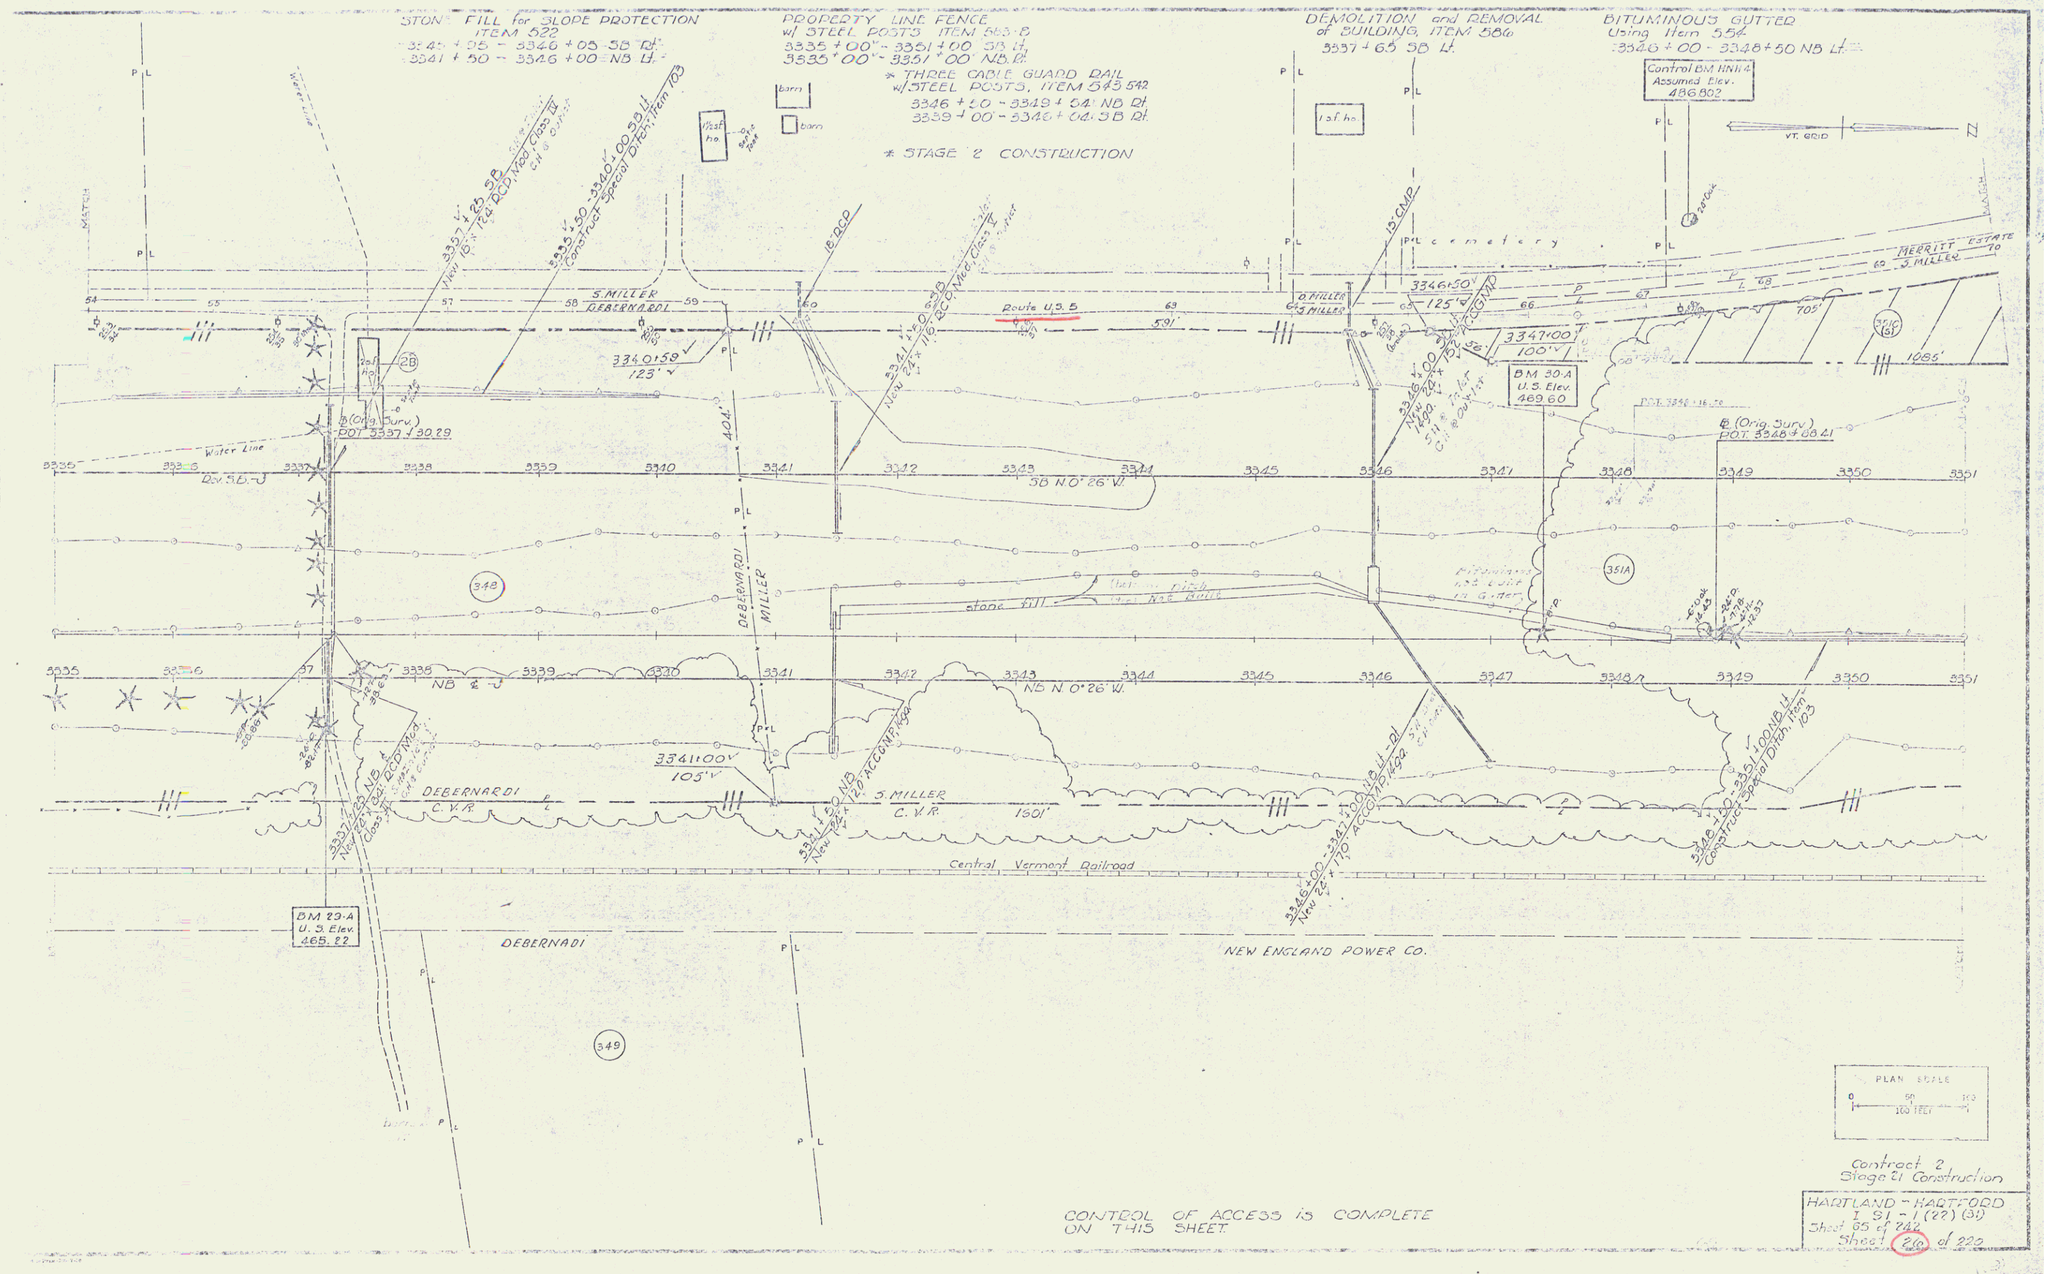


Contract 2
Stage 2 Construction

HARTLAND - HARTFORD
I 91 - 1 (22) (31)
Sheet 65 of 242

CONTROL OF ACCESS IS COMPLETE
ON THIS SHEET.