


PROPERTY LINE - FENCE ITEM 583-B
NB 3415+00 LT - 3426+00 RT
SB 3415+00 LT - 3426+00 RT

STONE FILL FOR SLOPE PROTECTION ITEM 522
3416+10 - 3416+30 SB LT
DRILLING and BLASTING OF SOLID ROCK SUBGRADE ITEM 111
3415+00 - 3416+25 SB
3421+00 - 3421+50 SB

*THREE CABLE GUARD RAIL w/ STEEL POSTS ITEM 543 542
3415+00 - 3417+12 NB RT
3421+48 - 3426+00 NB RT
3413+00 - 3414+00 NB RT

SUB-BASE OF SAND ITEM 202
3415+00 - 3421+50 SB
3415+50 - 3417+00 NB RT
*BITUMINOUS CONCRETE CURB ITEM 500
3423+00 - 3426+00 NB RT
*STAGE 2 CONSTRUCTION

DEMOLITION and REMOVAL of BUILDING ITEM 586
3417+00' N.E. Rt - 2 Bldgs.
3417+70' N.E. Rt

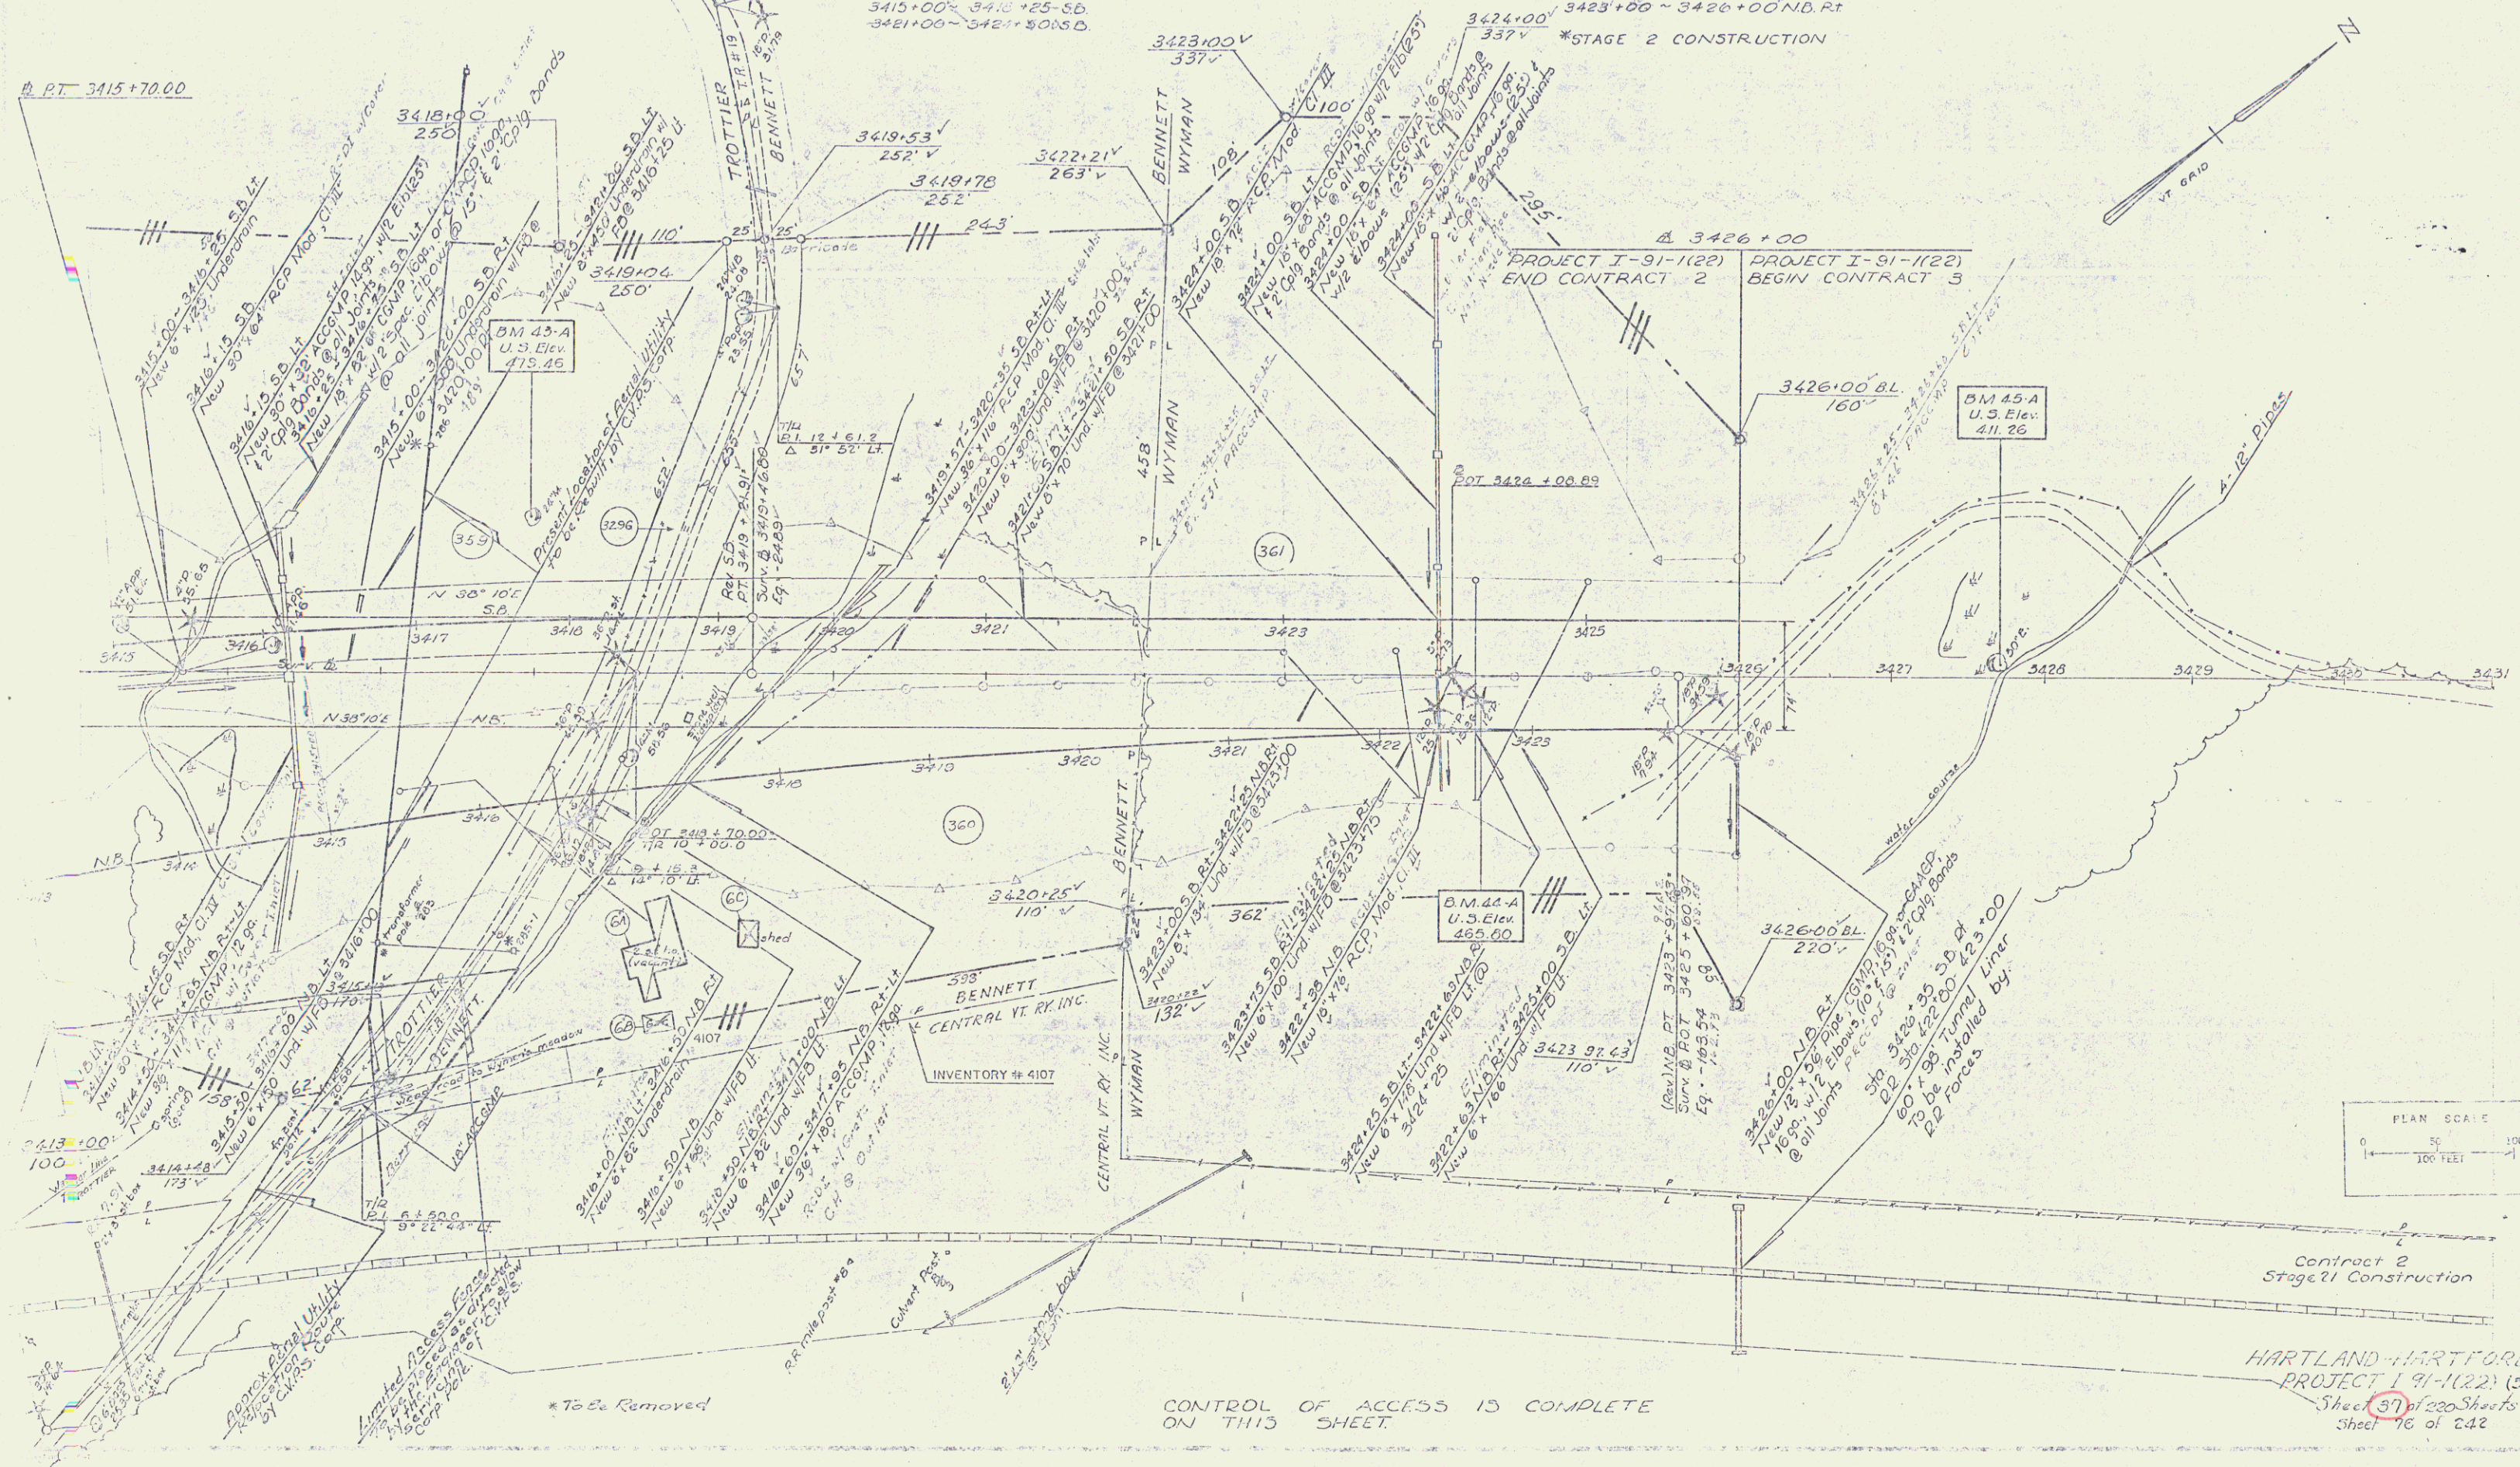

CONTROL OF ACCESS IS COMPLETE ON THIS SHEET.

HARTLAND-HARTFORD
PROJECT I-91-1(22) (51)
Sheet 37 of 220 Sheets
Sheet 16 of 242